



**ABELL  
SURVEYING & MAPPING  
DELAVER, WISCONSIN 53115  
414-728-6737**

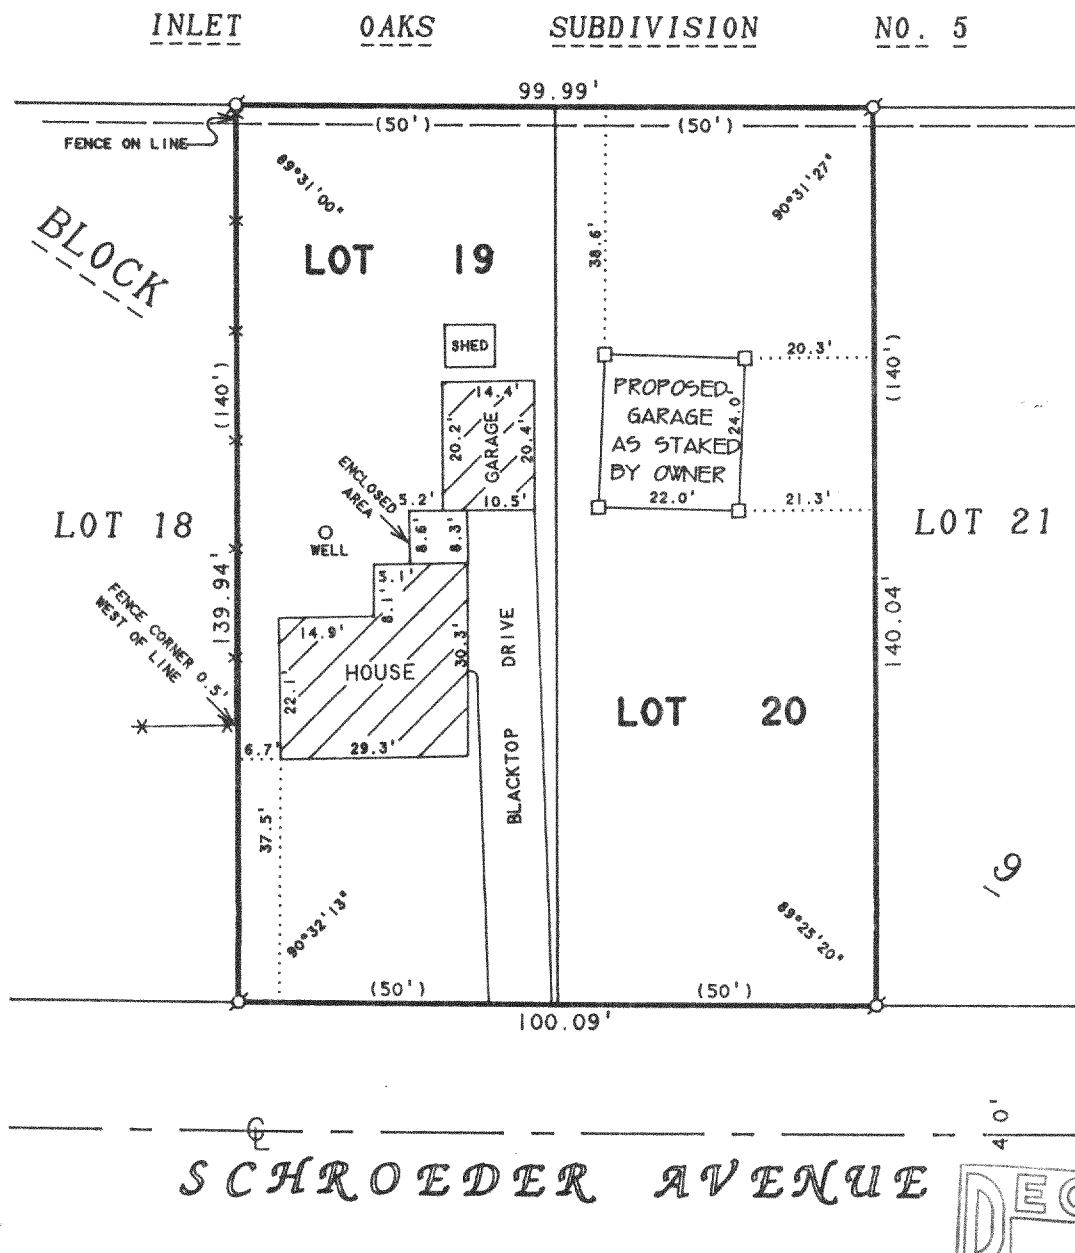

ORDERED BY: JOHN PUHL  
422 SCHROEDER AVENUE  
DELAVER, WI 53115

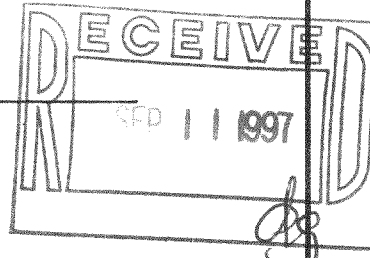

**PLAT OF SURVEY OF**

LOTS 19 AND 20, BLOCK 9, INLET OAKS SUBDIVISION  
NO. 4, LOCATED IN T2N, R16E, WALWORTH COUNTY,  
WISCONSIN.



SCALE 1"=30'

**LEGEND**

- ⊙ - IRON PIPE FOUND
- \* - WOOD FENCE
- - OVERHEAD UTILITY LINES
- - WOOD STAKE
- ( ) - RECORDED AS

I, DAVID F. ABELL, DO HEREBY CERTIFY THAT I HAVE SURVEYED THE PROPERTY HEREON DESCRIBED ACCORDING TO THE OFFICIAL RECORDS AND THAT THE PLAT HEREON IS A CORRECT REPRESENTATION OF THE PROPERTY LINES TO THE BEST OF MY KNOWLEDGE AND BELIEF.

*David F. Abell*

DAVID F. ABELL  
WISCONSIN REGISTERED LAND SURVEYOR, S-1596

*July 25, 1996*

DATE      JOB NUMBER - 96130  
NOTE: THIS IS NOT A CERTIFIED COPY UNLESS SEALED.

FIN4-ME  
216-2405