


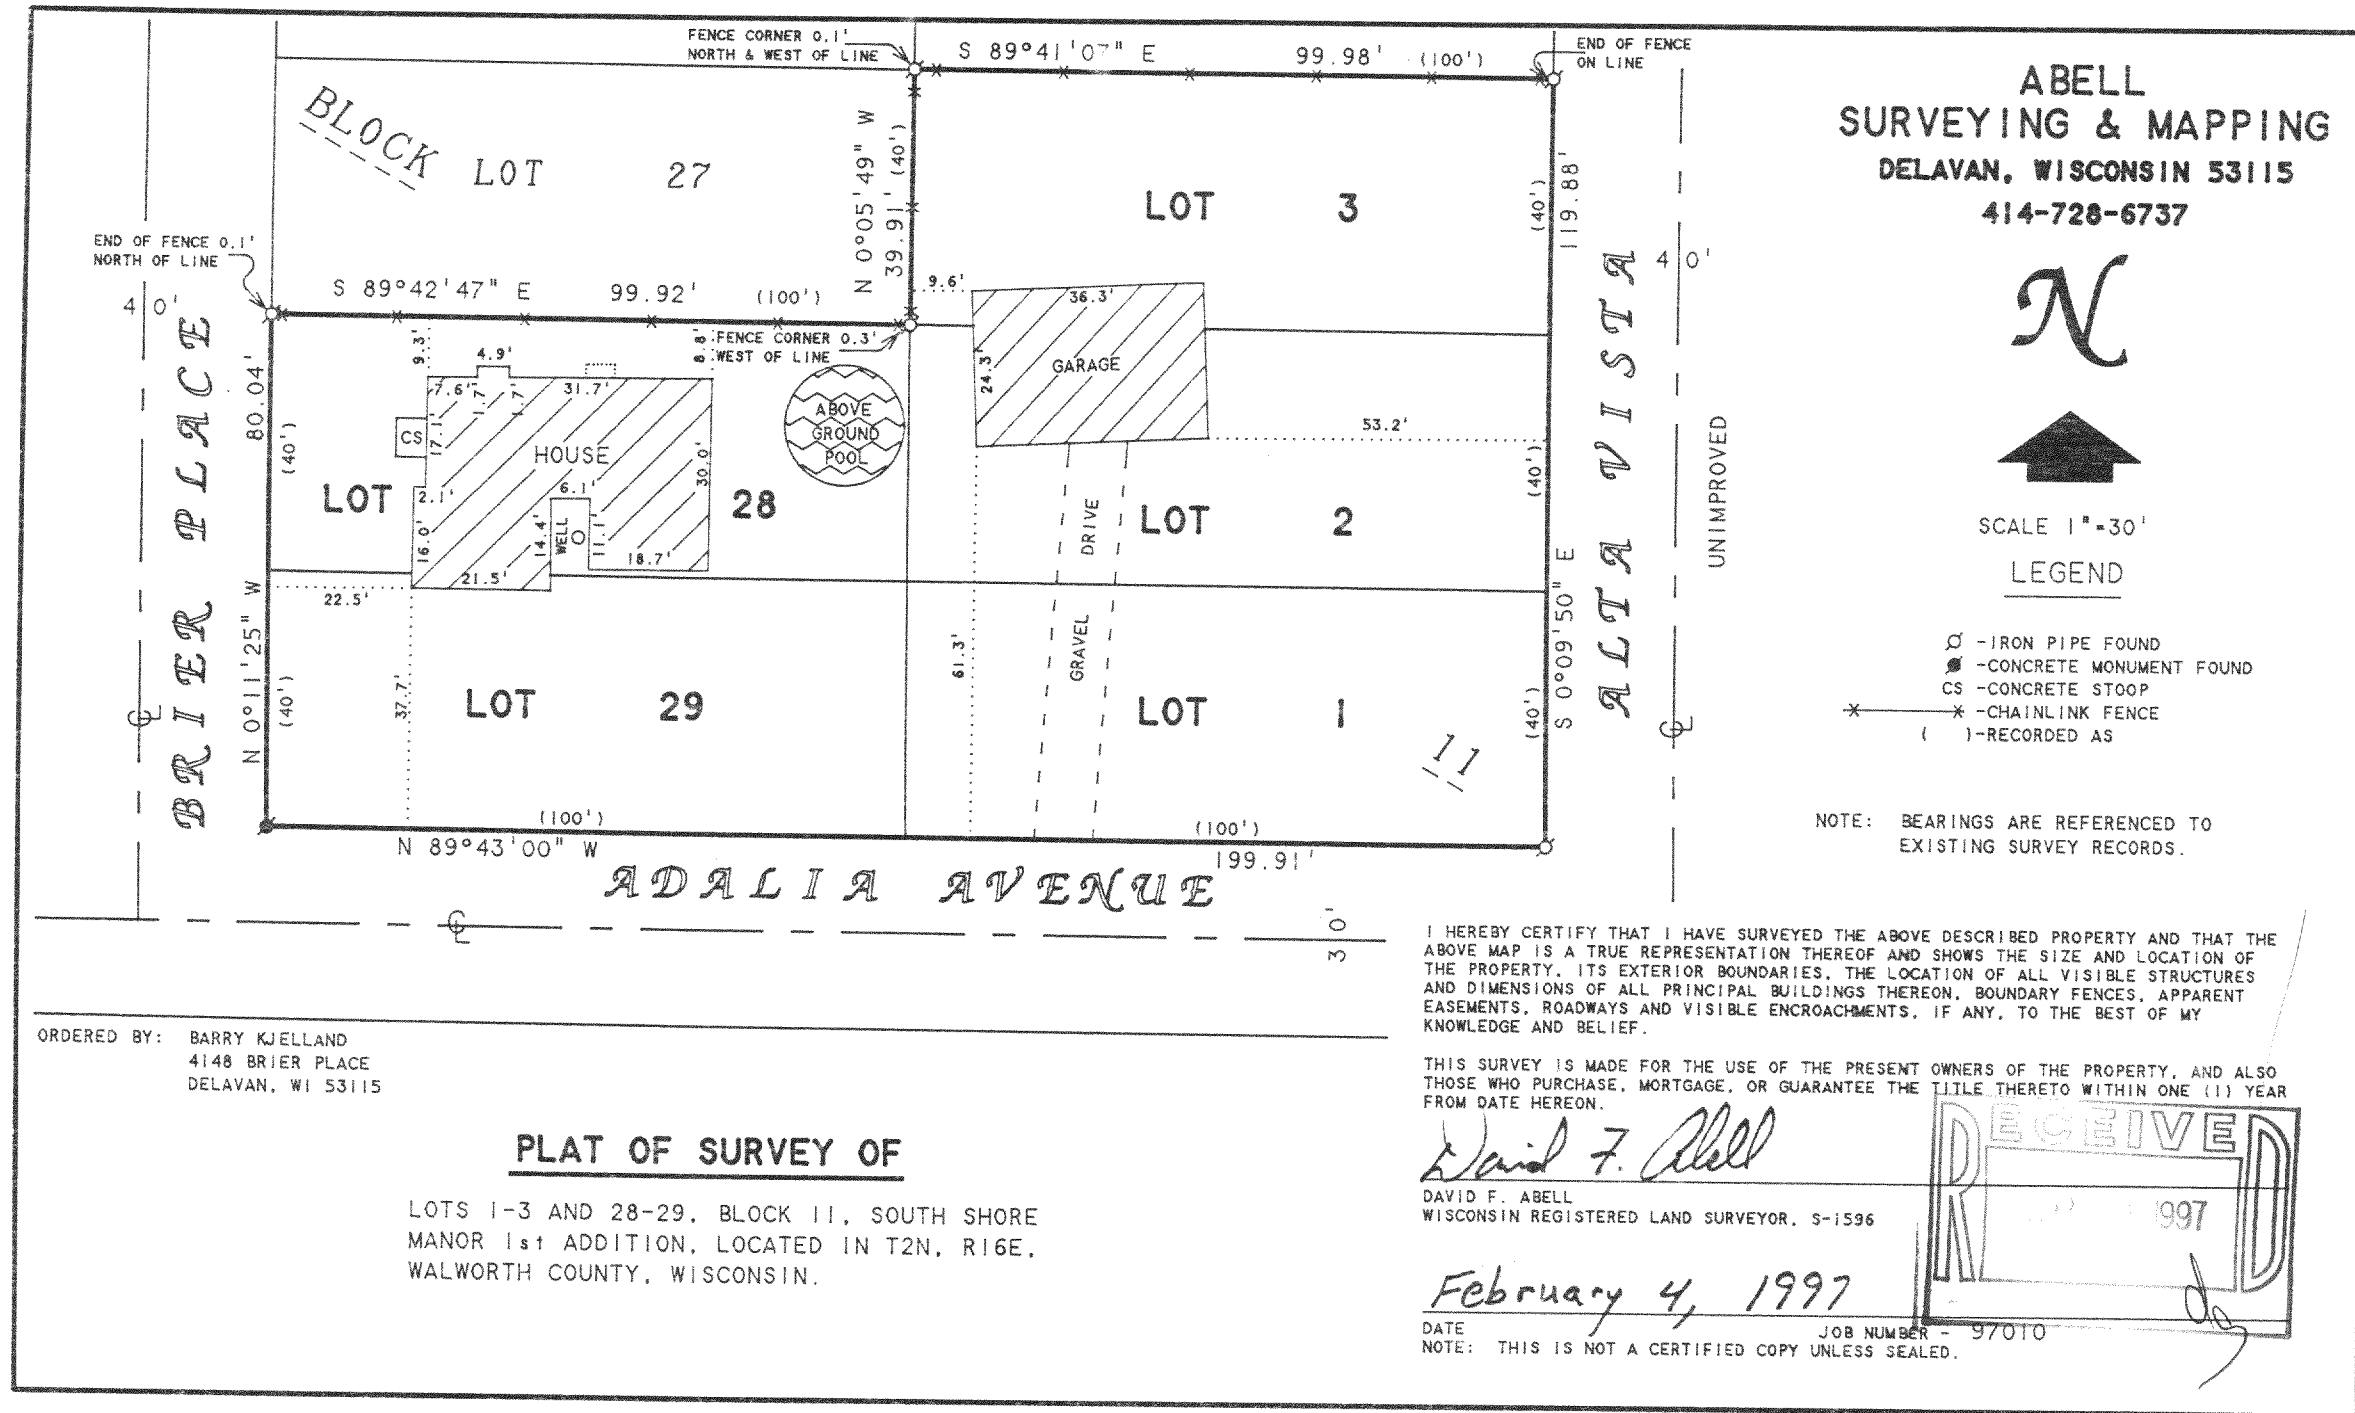

FSS1-45  
216-2452