


GEORGE T. DUNHAM  
SURVEYING & SUBDIVIDING  
DELAVAN, WISCONSIN

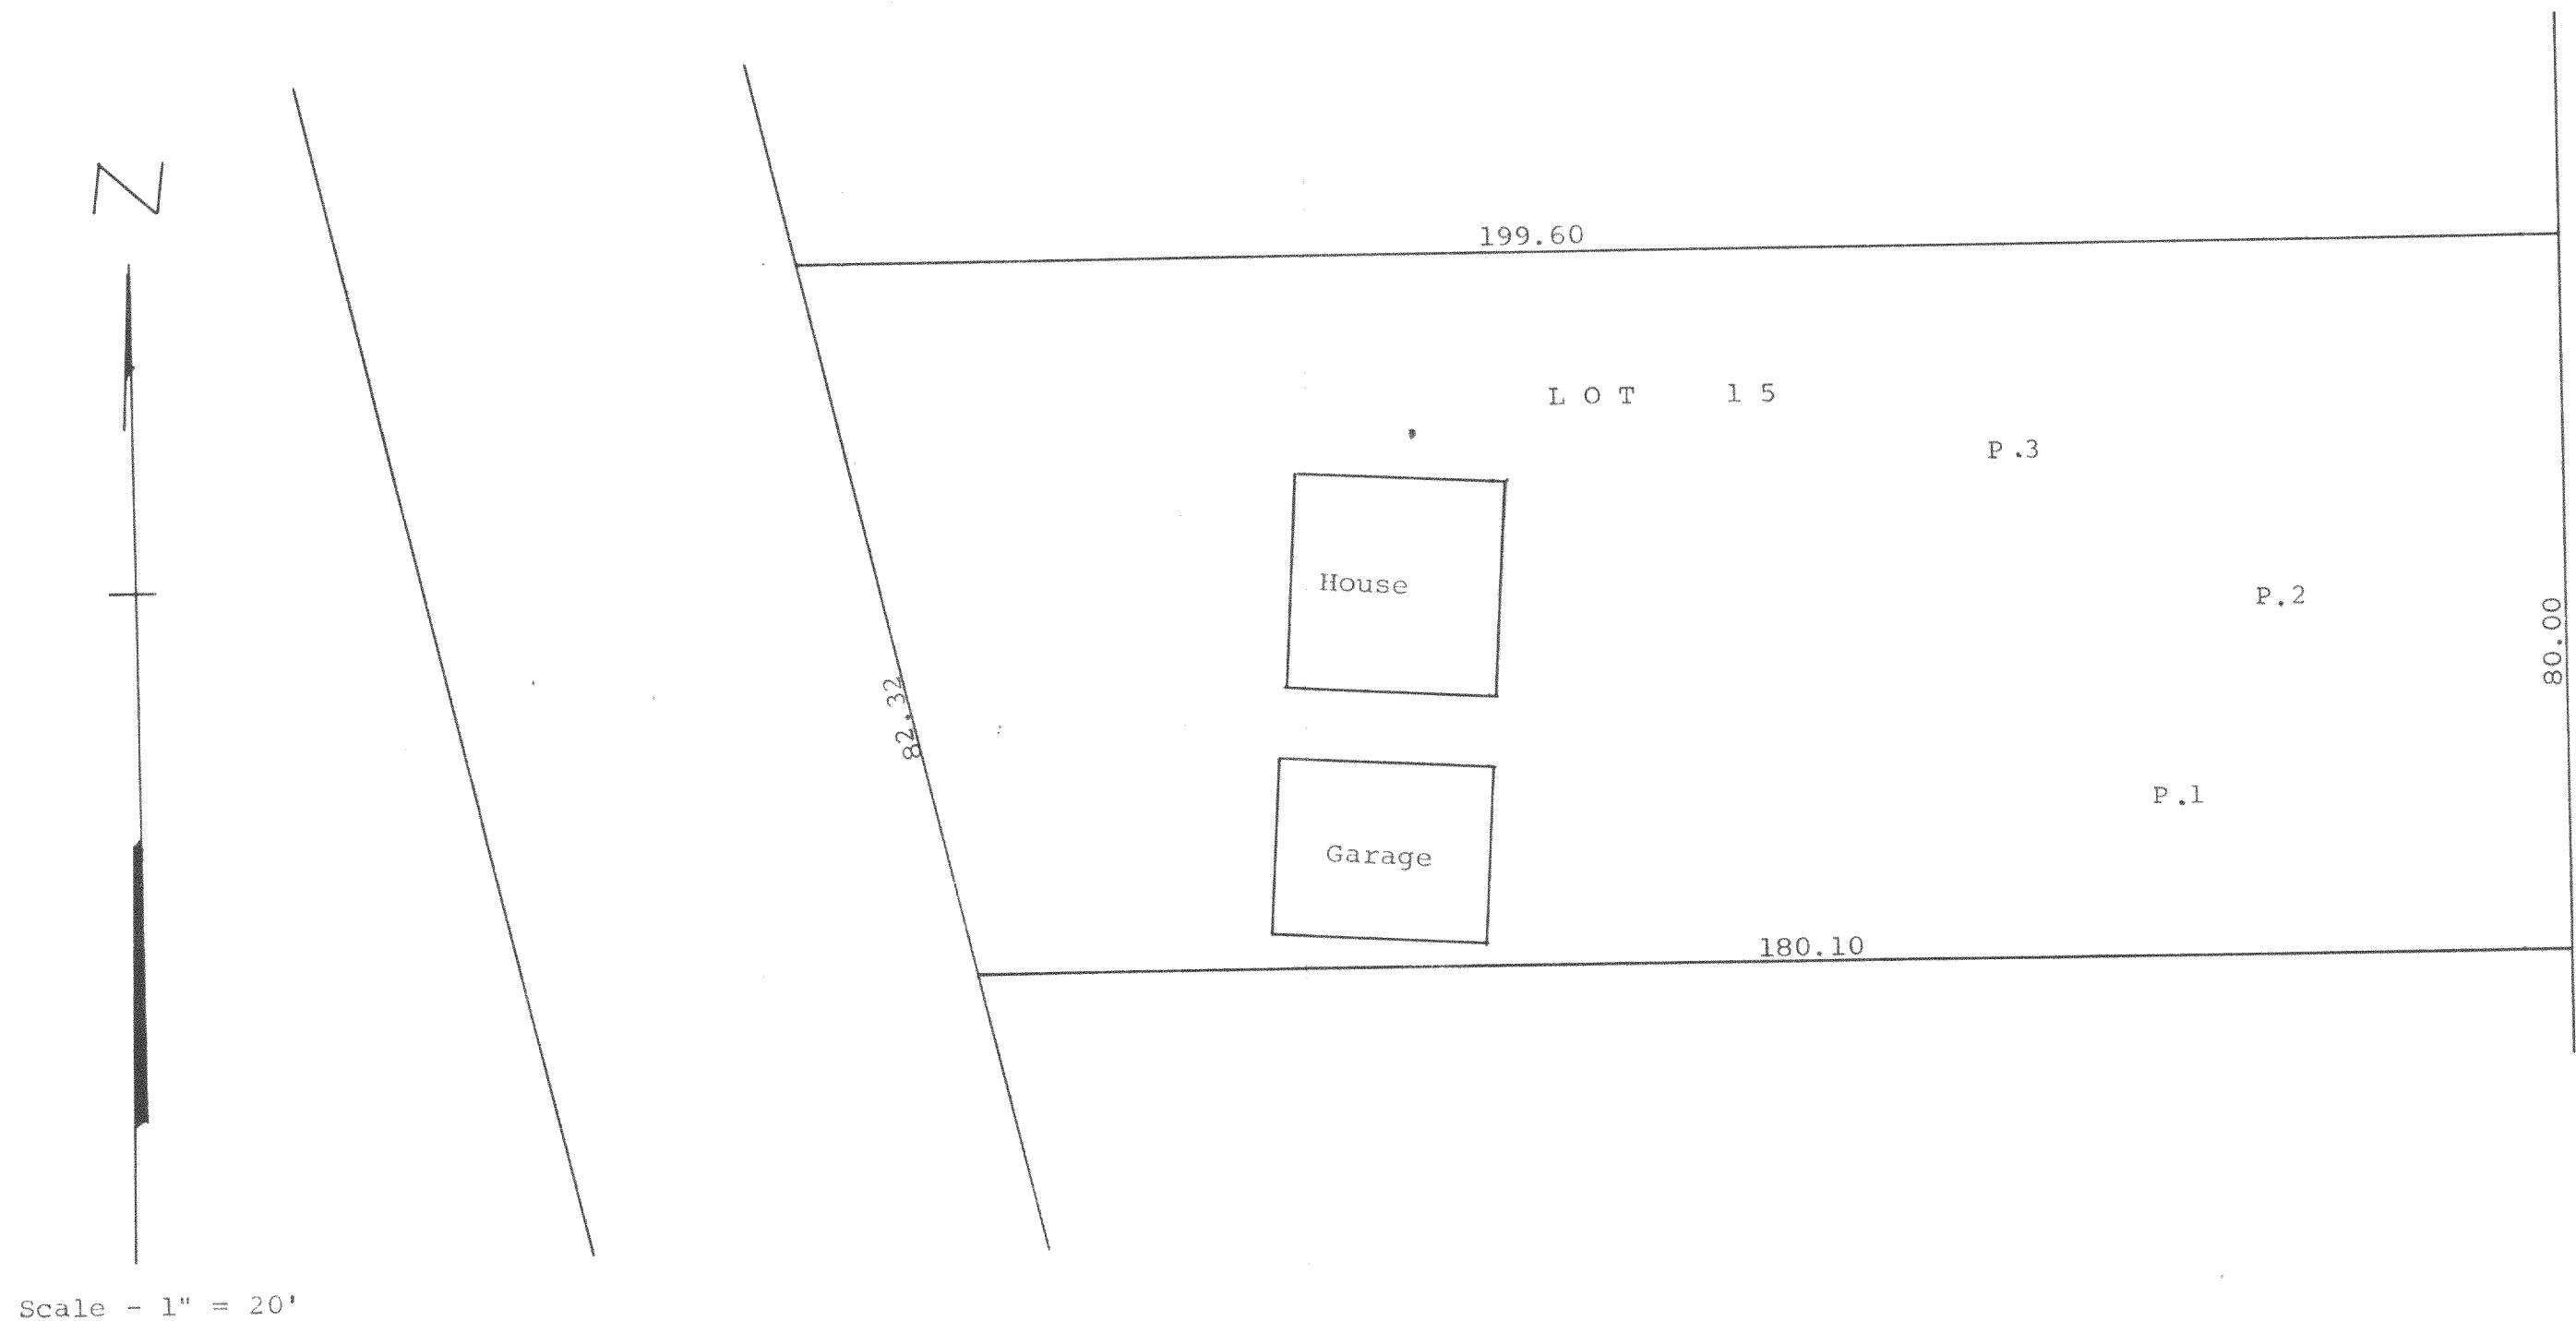

Plat showing the location of the percolation tests on  
Lot 15, Block 7, Delmar Subdivision, Town of Delavan,  
Walworth County, Wisconsin.  
July 12, 1967

*George T. Dunham*  
George T. Dunham, Surveyor

216-246