

ABELL
SURVEYING & MAPPING
DELAVAN, WISCONSIN 53115
414-728-6737


N



SCALE 1"=20'


LEGEND

- Ø - IRON PIPE FOUND
- * - WOOD FENCE
- () - RECORDED AS

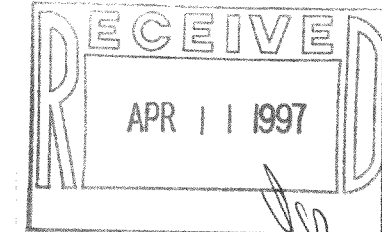

PLAT OF SURVEY OF

LOT 26, HOAG'S ADDITION, LOCATED IN
T2N, R16E, WALWORTH COUNTY, WISCONSIN.

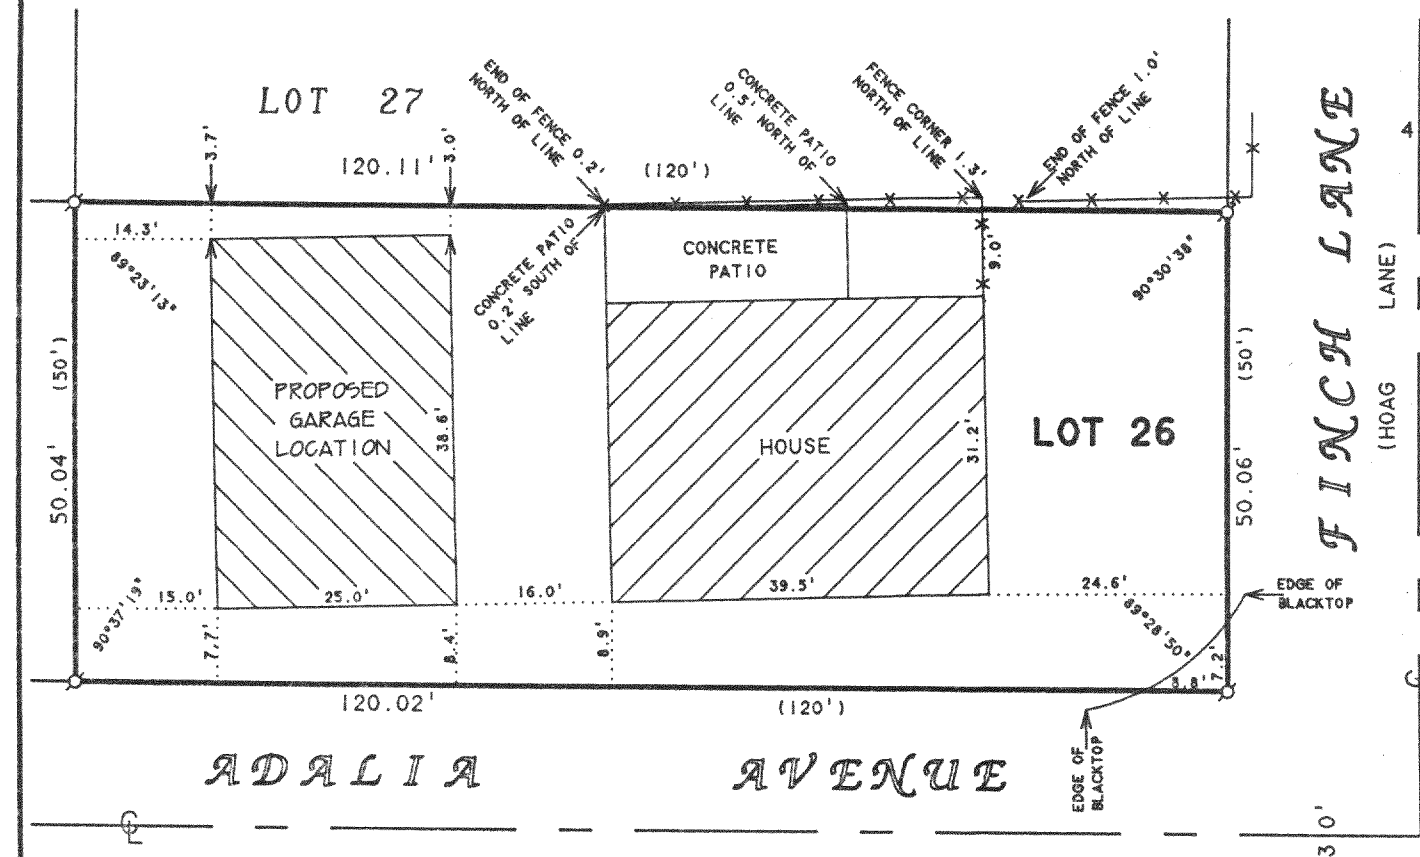

ORDERED BY: PAUL VENEMA
4155 FINCH LANE
DELAVAN, WI 53115

I, DAVID F. ABELL, DO HEREBY CERTIFY THAT I HAVE SURVEYED THE PROPERTY HEREON DESCRIBED ACCORDING TO THE OFFICAL RECORDS AND THAT THE PLAT HEREON IS A CORRECT REPRESENTATION OF THE PROPERTY LINES TO THE BEST OF MY KNOWLEDGE AND BELIEF

David F. Abell

DAVID F. ABELL
WISCONSIN REGISTERED LAND SURVEYOR, S-1596

September 4, 1996

DATE JOB NUMBER - 96153

NOTE: THIS IS NOT A CERTIFIED COPY UNLESS SEALED.

FHO-17
216-2469