
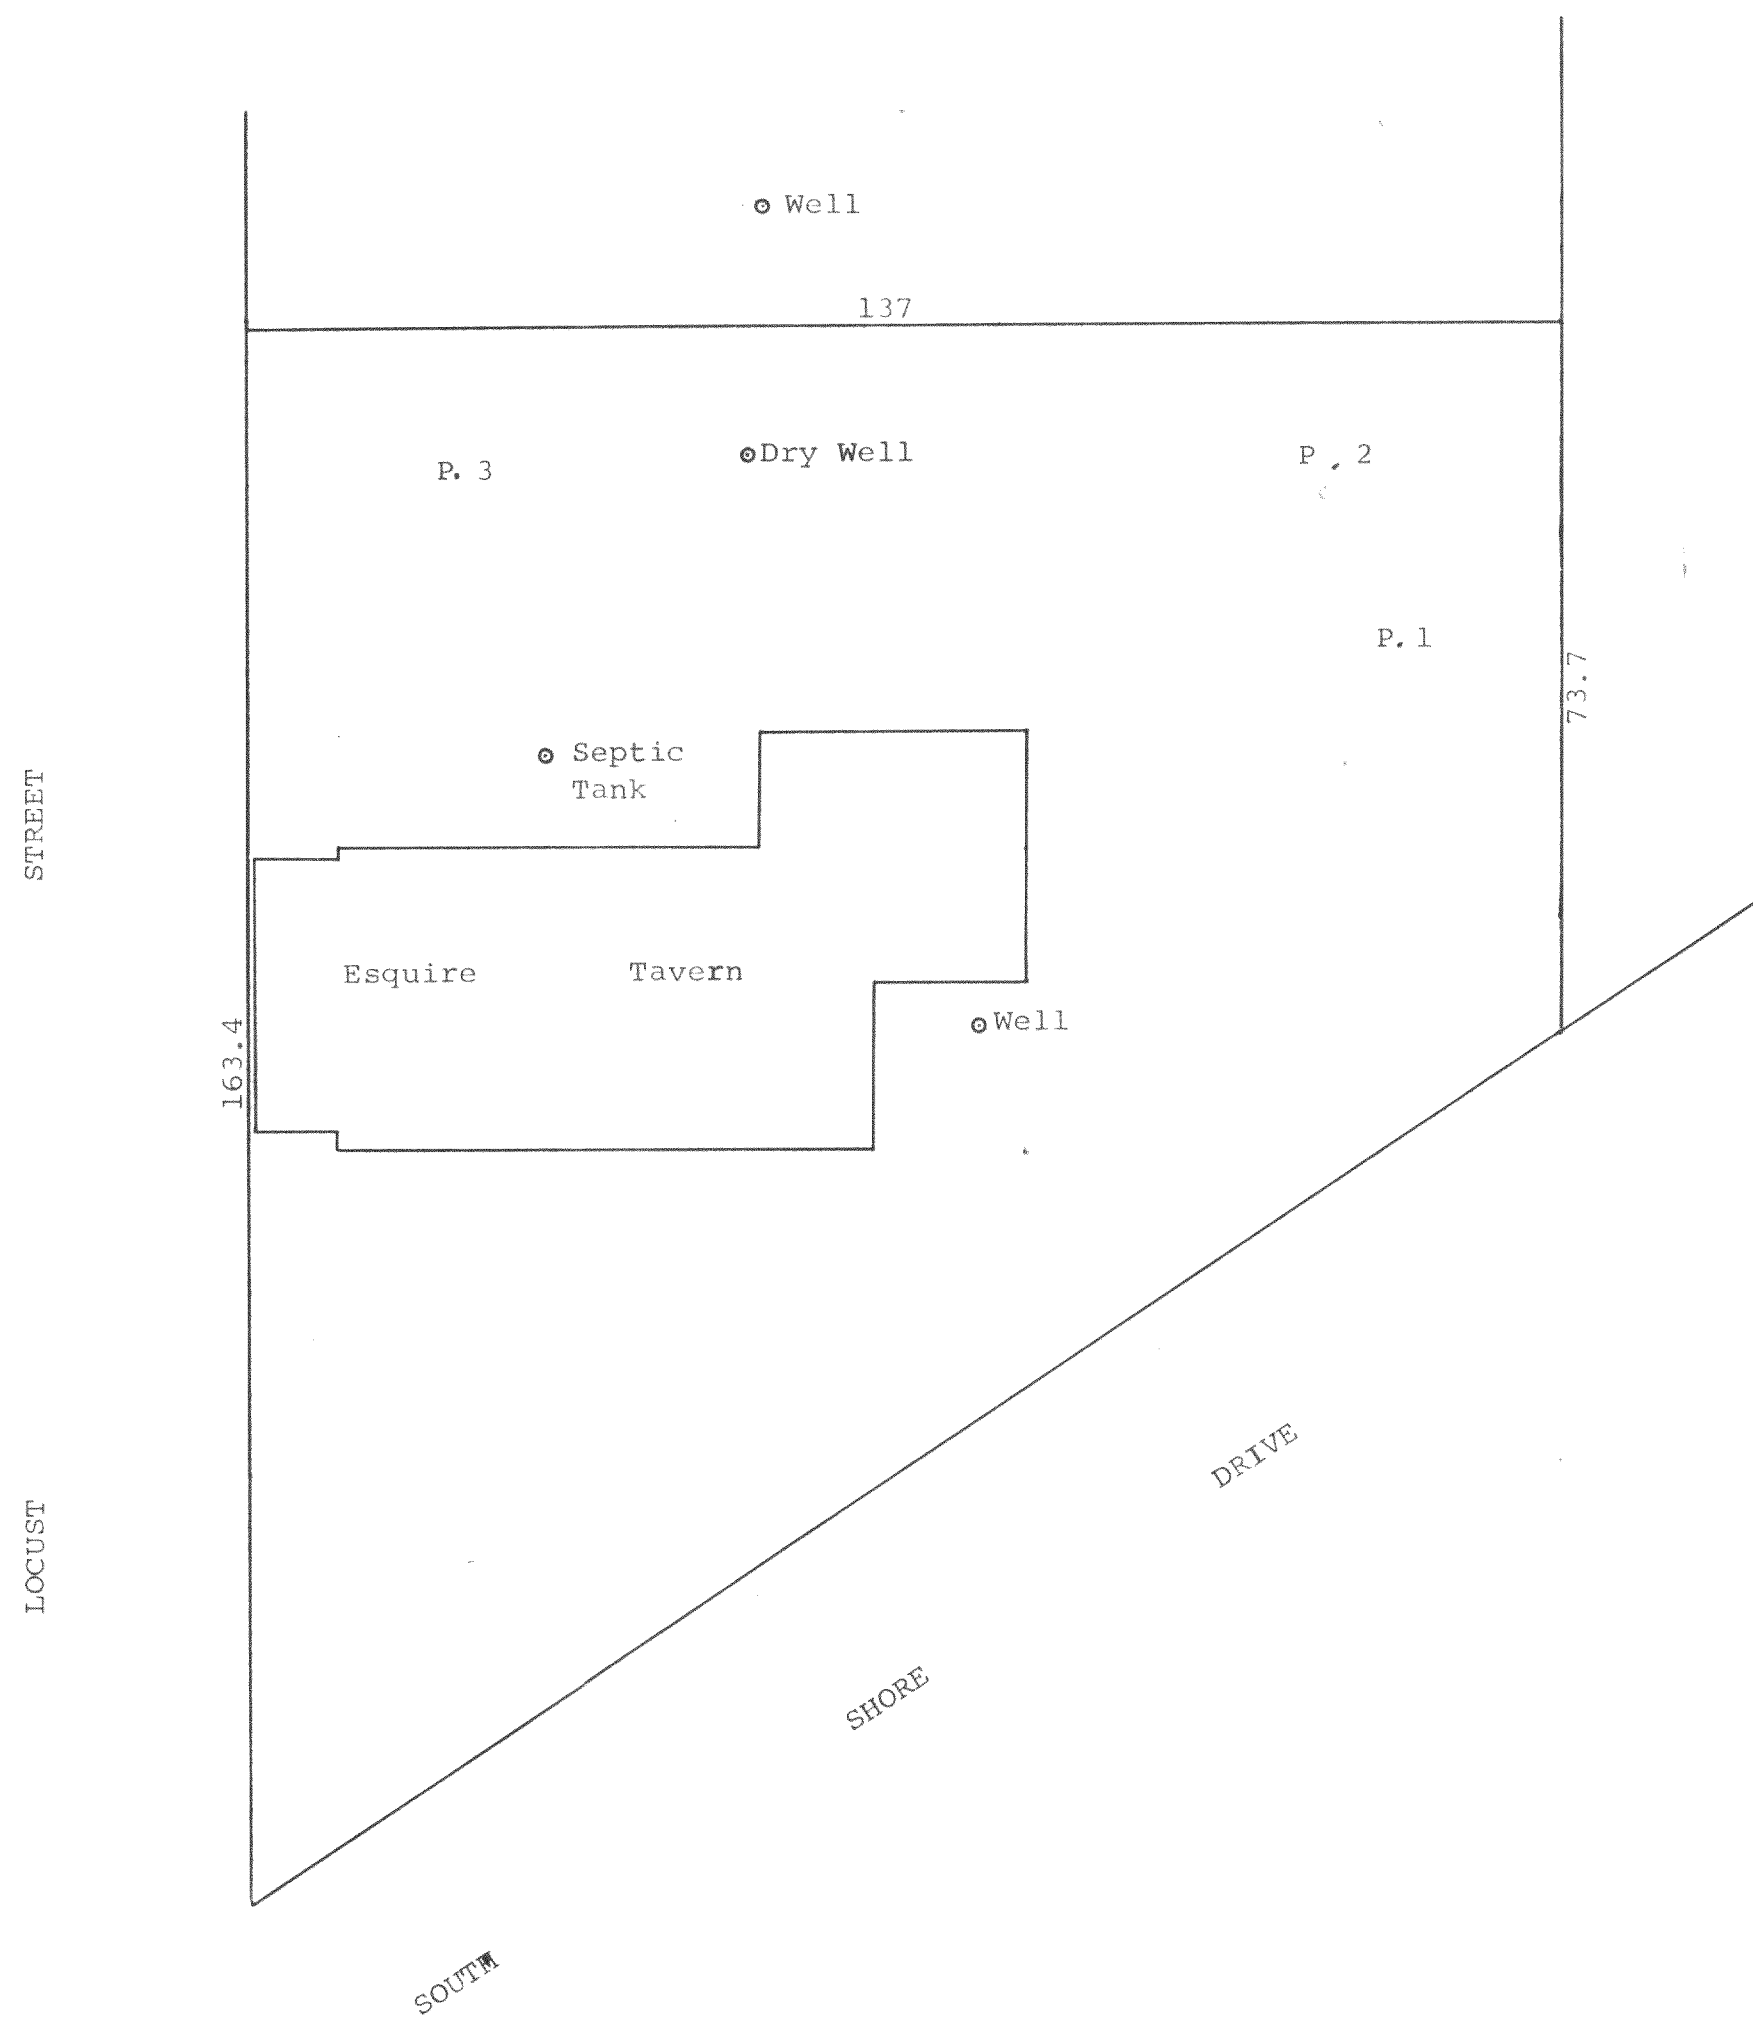


GEORGE T. DUNHAM
SURVEYING & SUBDIVIDING
DELAVER, WISCONSIN

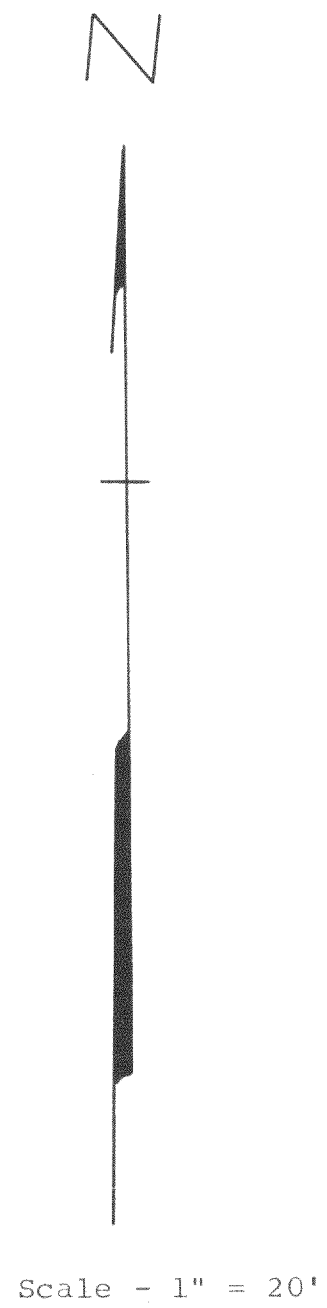

Plat showing location of the percolation tests made on
Lots 16 and 17, Lake View Subdivision, Section 32, T 2 N,
R 16 E, Walworth County, Wisconsin.
July 12, 1967

George T. Dunham
George T. Dunham, Surveyor