

ABERNATHY and ASSOCIATES


Kenneth B. Abernathy Jr.

Wisconsin Registered Land Surveyor S-1594

W4056 Bray Road 53121
Elkhorn, Wisconsin
Phone: (414) 723-4260 (office)
(414) 723-7209 (fax)

PLAT OF SURVEY

Lot 2 of Certified Survey Map Number 1971, as recorded in Volume 9 on Page 226 as Document Number 200820, being located in part of the Northeast 1/4 of the Northwest 1/4 of Section 2, Town 2 North, Range 16 East, Town of Delavan, Walworth County, Wisconsin.

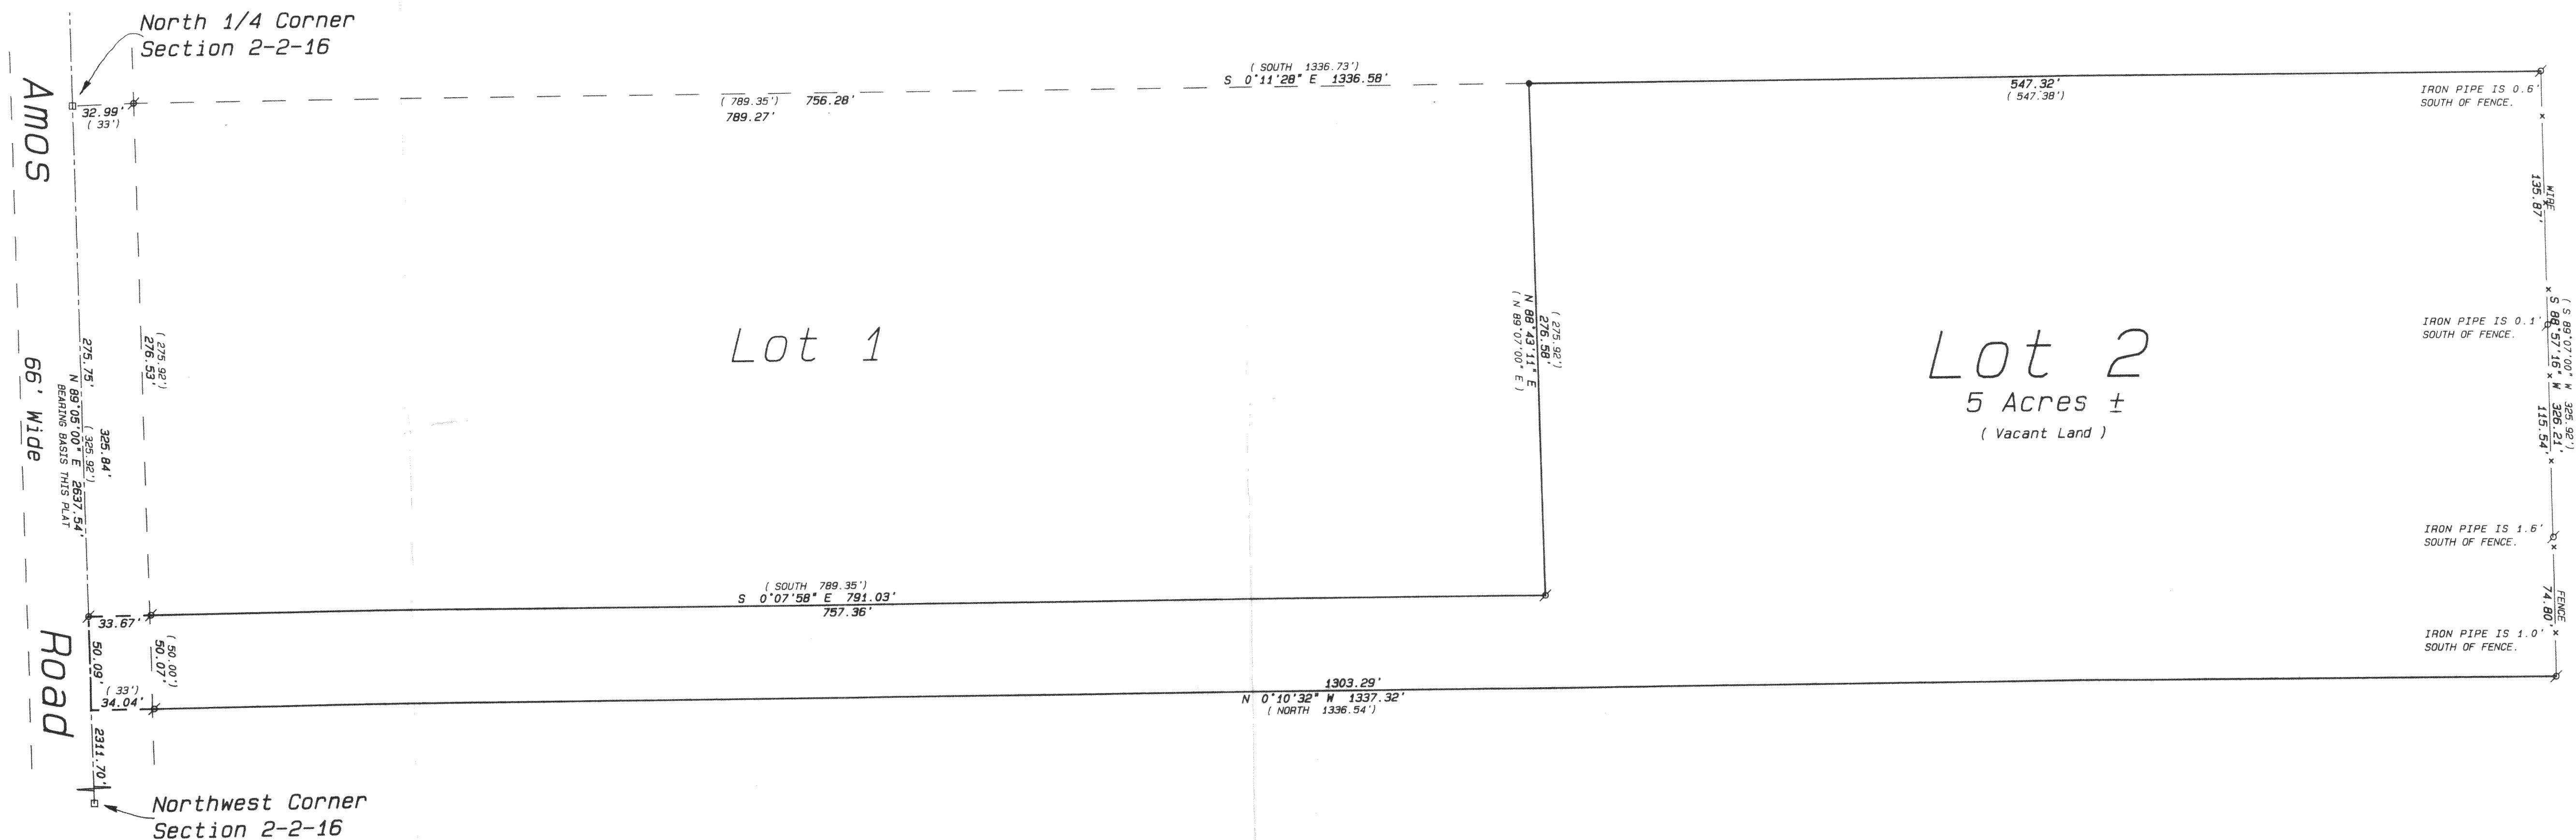

FA-1971-2
216-2474