


ABELL
SURVEYING & MAPPING
DELAVAN, WISCONSIN 53115
414-728-6737

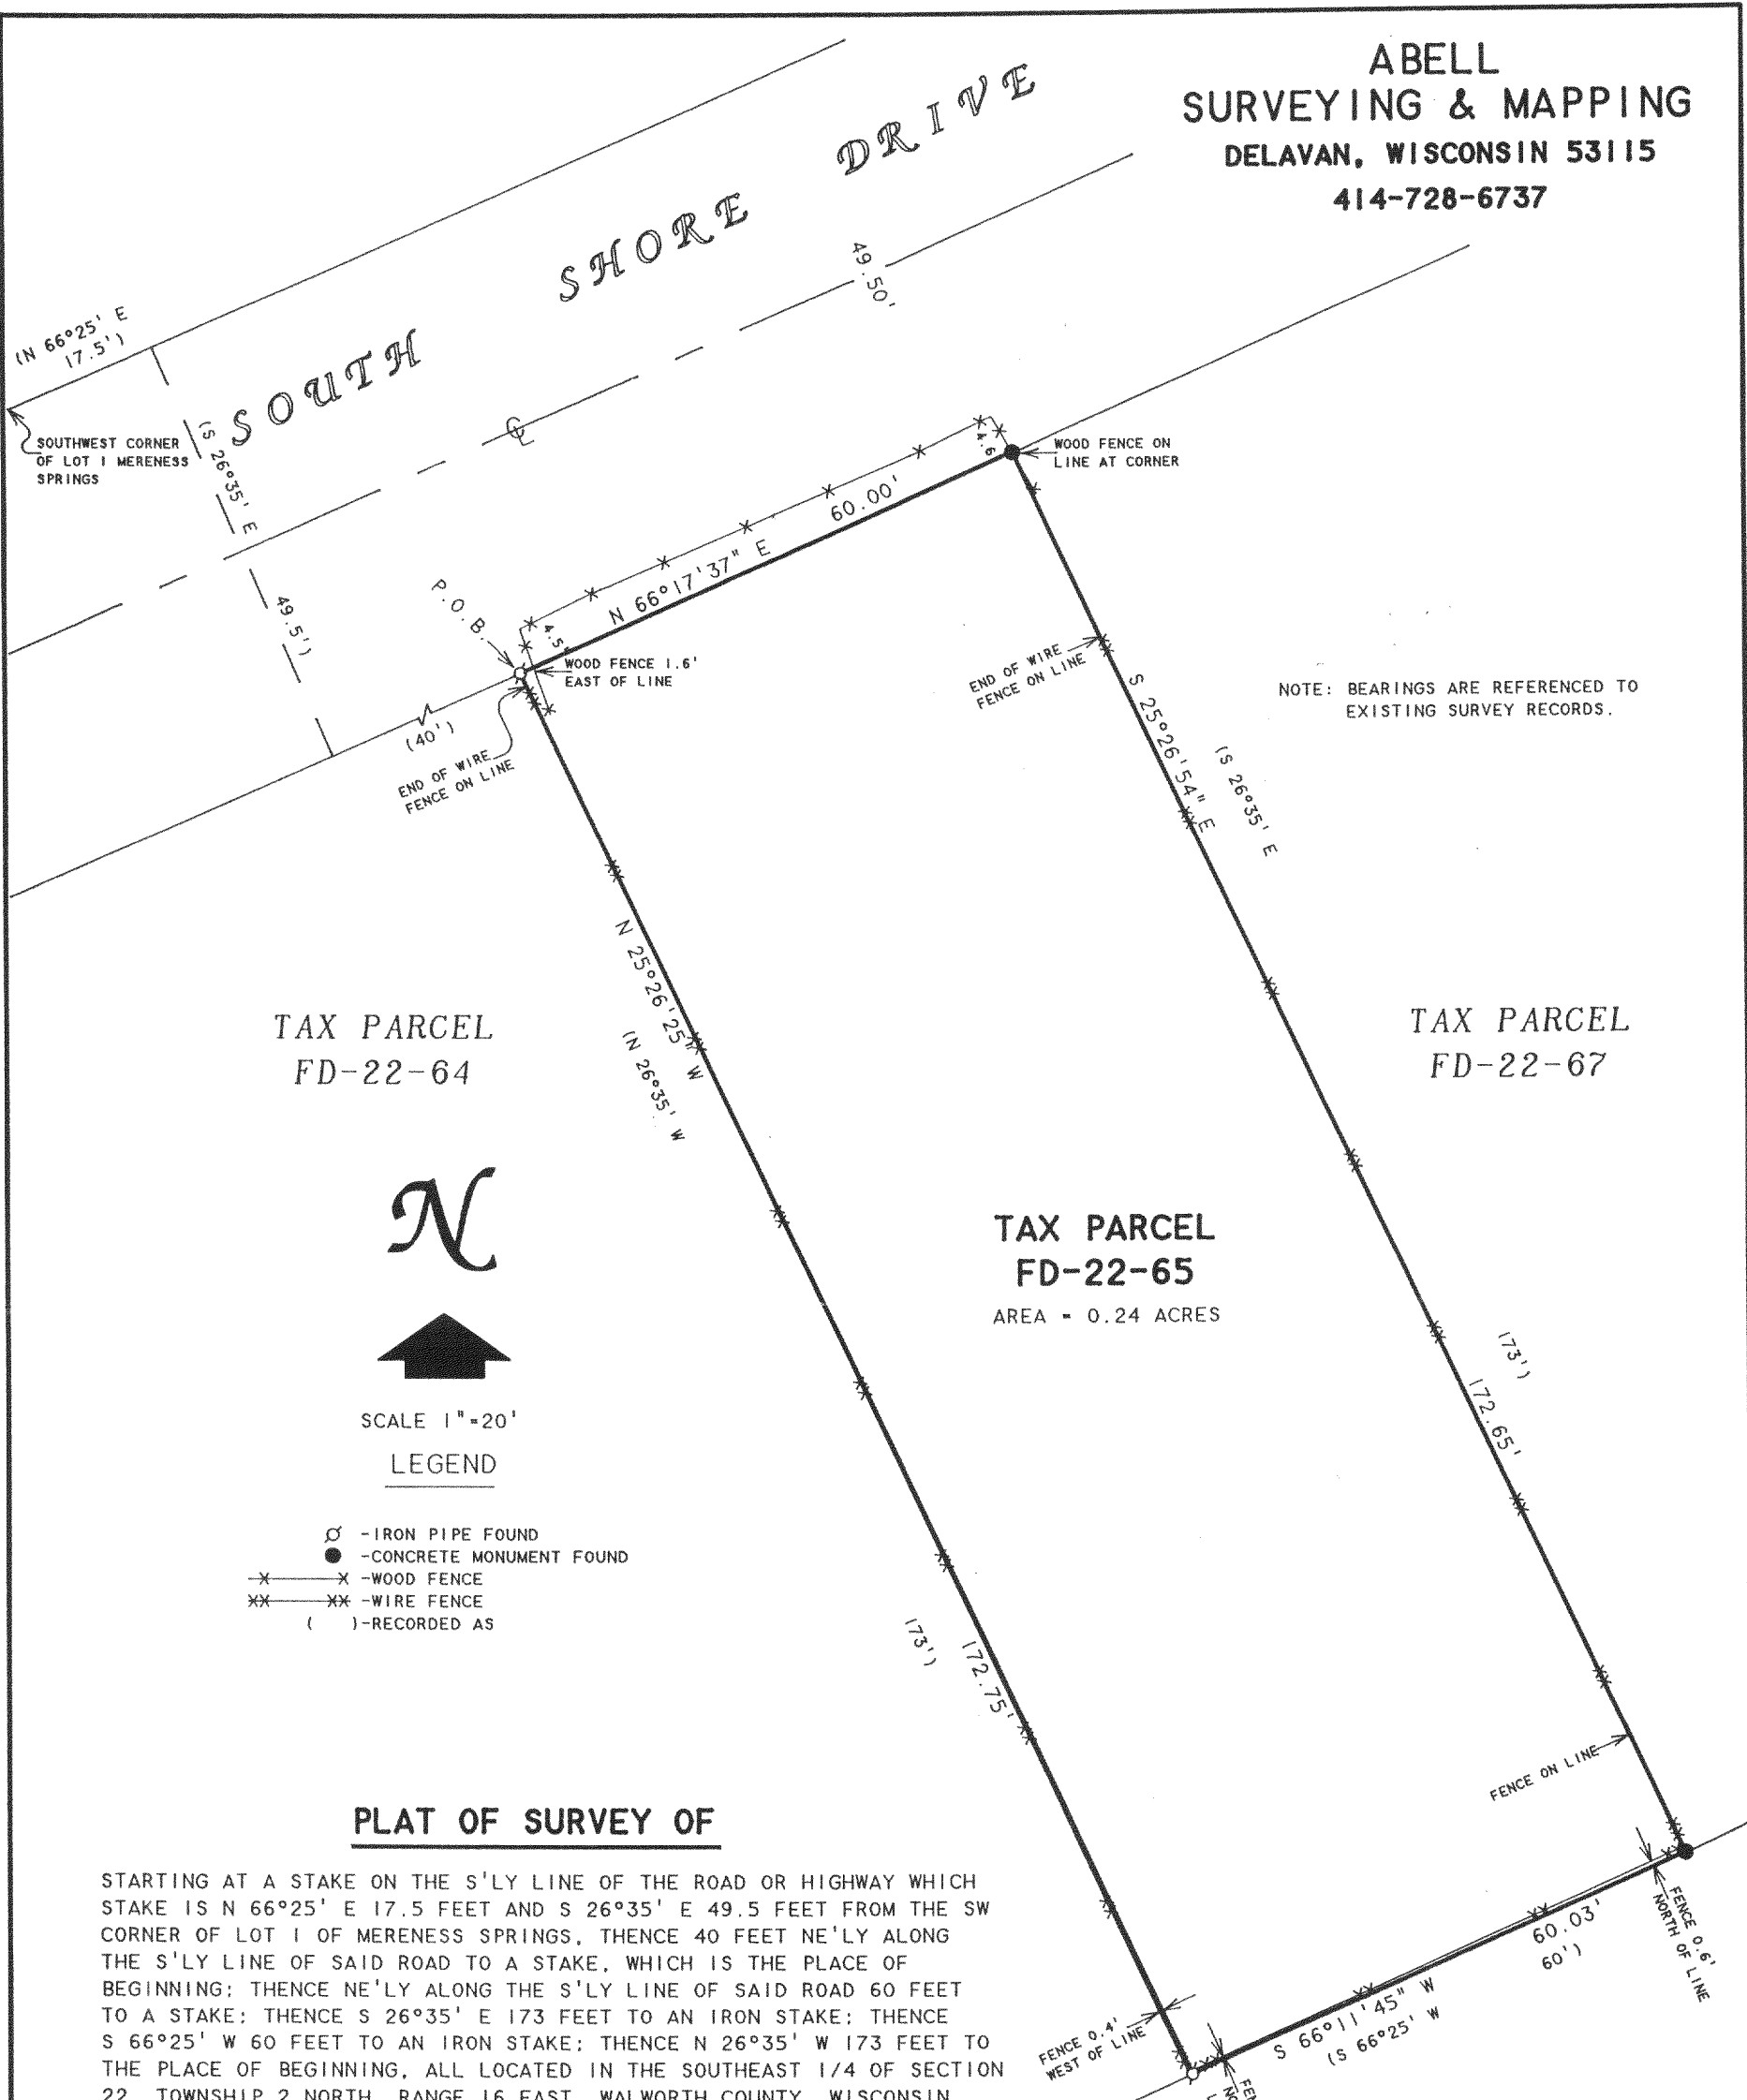

NOTE: BEARINGS ARE REFERENCED TO EXISTING SURVEY RECORDS.

TAX PARCEL
FD-22-64

TAX PARCEL
FD-22-67

TAX PARCEL
FD-22-65
AREA = 0.24 ACRES




SCALE 1" = 20'
LEGEND

- - IRON PIPE FOUND
- - CONCRETE MONUMENT FOUND
- x- - WOOD FENCE
- xx- - WIRE FENCE
- () - RECORDED AS

PLAT OF SURVEY OF

STARTING AT A STAKE ON THE S'LY LINE OF THE ROAD OR HIGHWAY WHICH STAKE IS N 66°25' E 17.5 FEET AND S 26°35' E 49.5 FEET FROM THE SW CORNER OF LOT 1 OF MERENESS SPRINGS, THENCE 40 FEET NE'LY ALONG THE S'LY LINE OF SAID ROAD TO A STAKE, WHICH IS THE PLACE OF BEGINNING; THENCE NE'LY ALONG THE S'LY LINE OF SAID ROAD 60 FEET TO A STAKE; THENCE S 26°35' E 173 FEET TO AN IRON STAKE; THENCE S 66°25' W 60 FEET TO AN IRON STAKE; THENCE N 26°35' W 173 FEET TO THE PLACE OF BEGINNING, ALL LOCATED IN THE SOUTHEAST 1/4 OF SECTION 22, TOWNSHIP 2 NORTH, RANGE 16 EAST, WALWORTH COUNTY, WISCONSIN.

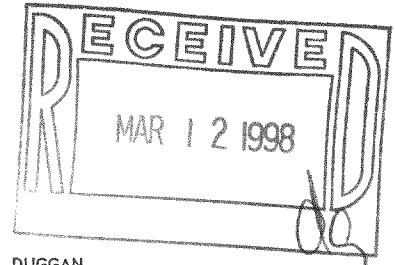

ORDERED BY: PAT DUGGAN
12462 S. NAGLE
PALOS HEIGHTS, IL 60463

RECERTIFIED: DECEMBER 11, 1997
ORDERED BY: MIKE DUGGAN
731 TOWN PLACE
HINSDALE, IL 60521

REVISED: DECEMBER 22, 1997
TO UPDATE LEGAL DESCRIPTION.

I HEREBY CERTIFY THAT I HAVE SURVEYED THE ABOVE DESCRIBED PROPERTY AND THAT THE ABOVE MAP IS A TRUE REPRESENTATION THEREOF AND SHOWS THE SIZE AND LOCATION OF THE PROPERTY, ITS EXTERIOR BOUNDARIES, THE LOCATION OF ALL VISIBLE STRUCTURES AND DIMENSIONS OF ALL PRINCIPAL BUILDINGS THEREON, BOUNDARY FENCES, APPARENT EASEMENTS, ROADWAYS AND VISIBLE ENCROACHMENTS, IF ANY, TO THE BEST OF MY KNOWLEDGE AND BELIEF.

THIS SURVEY IS MADE FOR THE USE OF THE PRESENT OWNERS OF THE PROPERTY, AND ALSO THOSE WHO PURCHASE, MORTGAGE, OR GUARANTEE THE TITLE THERETO WITHIN ONE (1) YEAR FROM DATE HEREON.

David F. Abell

DAVID F. ABELL
WISCONSIN REGISTERED LAND SURVEYOR, S-1596

September 5, 1995

DATE: _____ JOB NUMBER - 95131A

NOTE: THIS IS NOT A CERTIFIED COPY UNLESS SEALED.

FD-22-65

216-2530