


PLAT OF SURVEY

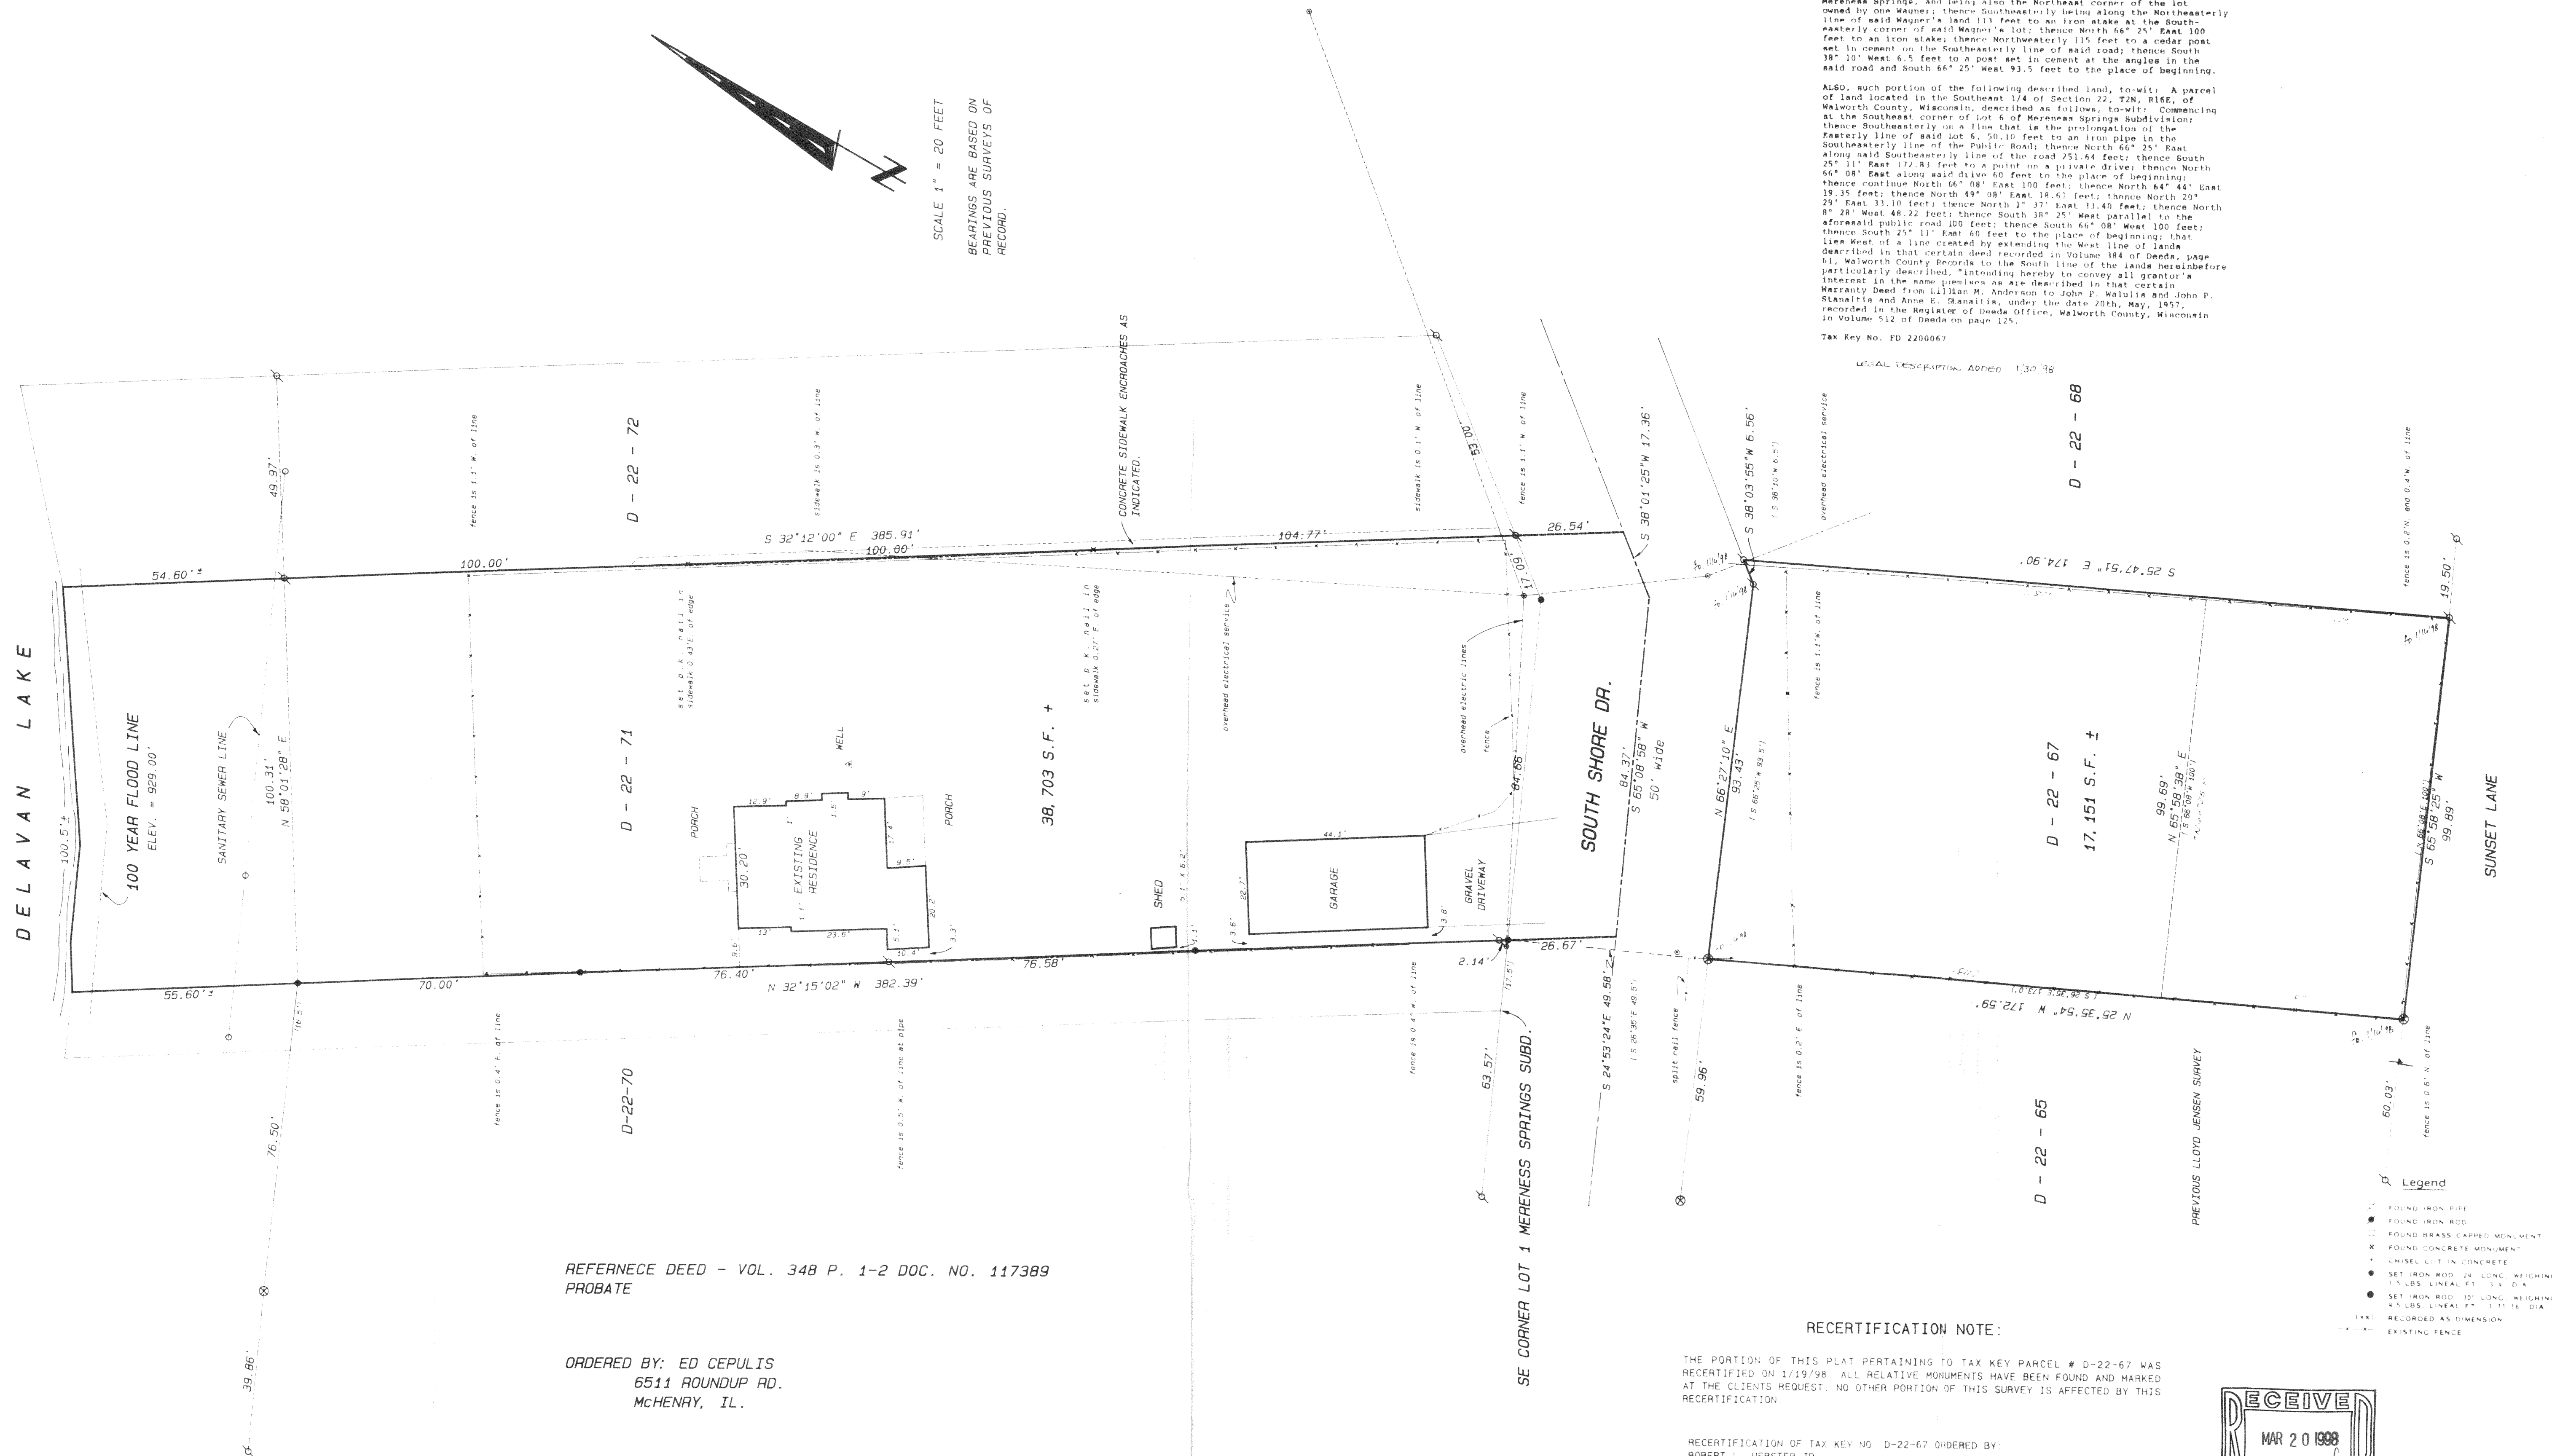

REFERNECE DEED - VOL. 348 P. 1-2 DOC. NO. 117389
PROBATE

ORDERED BY: ED CEPULIS
6511 ROUNDUP RD.
McHENRY, IL.

RECERTIFICATION NOTE:

THE PORTION OF THIS PLAT PERTAINING TO TAX KEY PARCEL # D-22-67 WAS
RECEMITTED ON 1/19/98. ALL RELATIVE MONUMENTS HAVE BEEN FOUND AND MARKED
AT THE CLIENTS REQUEST. NO OTHER PORTION OF THIS SURVEY IS AFFECTED BY THIS
RECEMITATION.

RECERTIFICATION OF TAX KEY NO D-22-67 ORDERED BY:
ROBERT L. WEBSTER JR.
C/O KEEFE REAL ESTATE
P.O. BOX 460
LAKE GENEVA, WI. 53147

PLAT OF SURVEY REVISED 1/19/98

REVISED 1/30/18



RECEIVED
MAR 20 1998

SCALE: 1" = 20 FEET

This survey certifies that the interests described in property have been surveyed by me or under my direction, and that the above map is a true and correct representation thereof and shows the size and location of the property to be surveyed. It extends boundaries, the location of all existing structures, all different sections of principal buildings thereon, boundary fences, all easements, roadways, and other encroachments, if any.

This survey is made for the use of the present owners of the property, and also those who purchase mortgage or guarantee the title there-within one year from date hereof.

KENNETH B. ABERNATHY, JR.
WISCONSIN REGISTERED LAND SURVEYOR.
S-1594

Date: FEB. 3, 1995 Job No. 95.116

216-2539