


GEORGE T. DUNHAM
SURVEYING & SUBDIVIDING
DELAVER, WISCONSIN

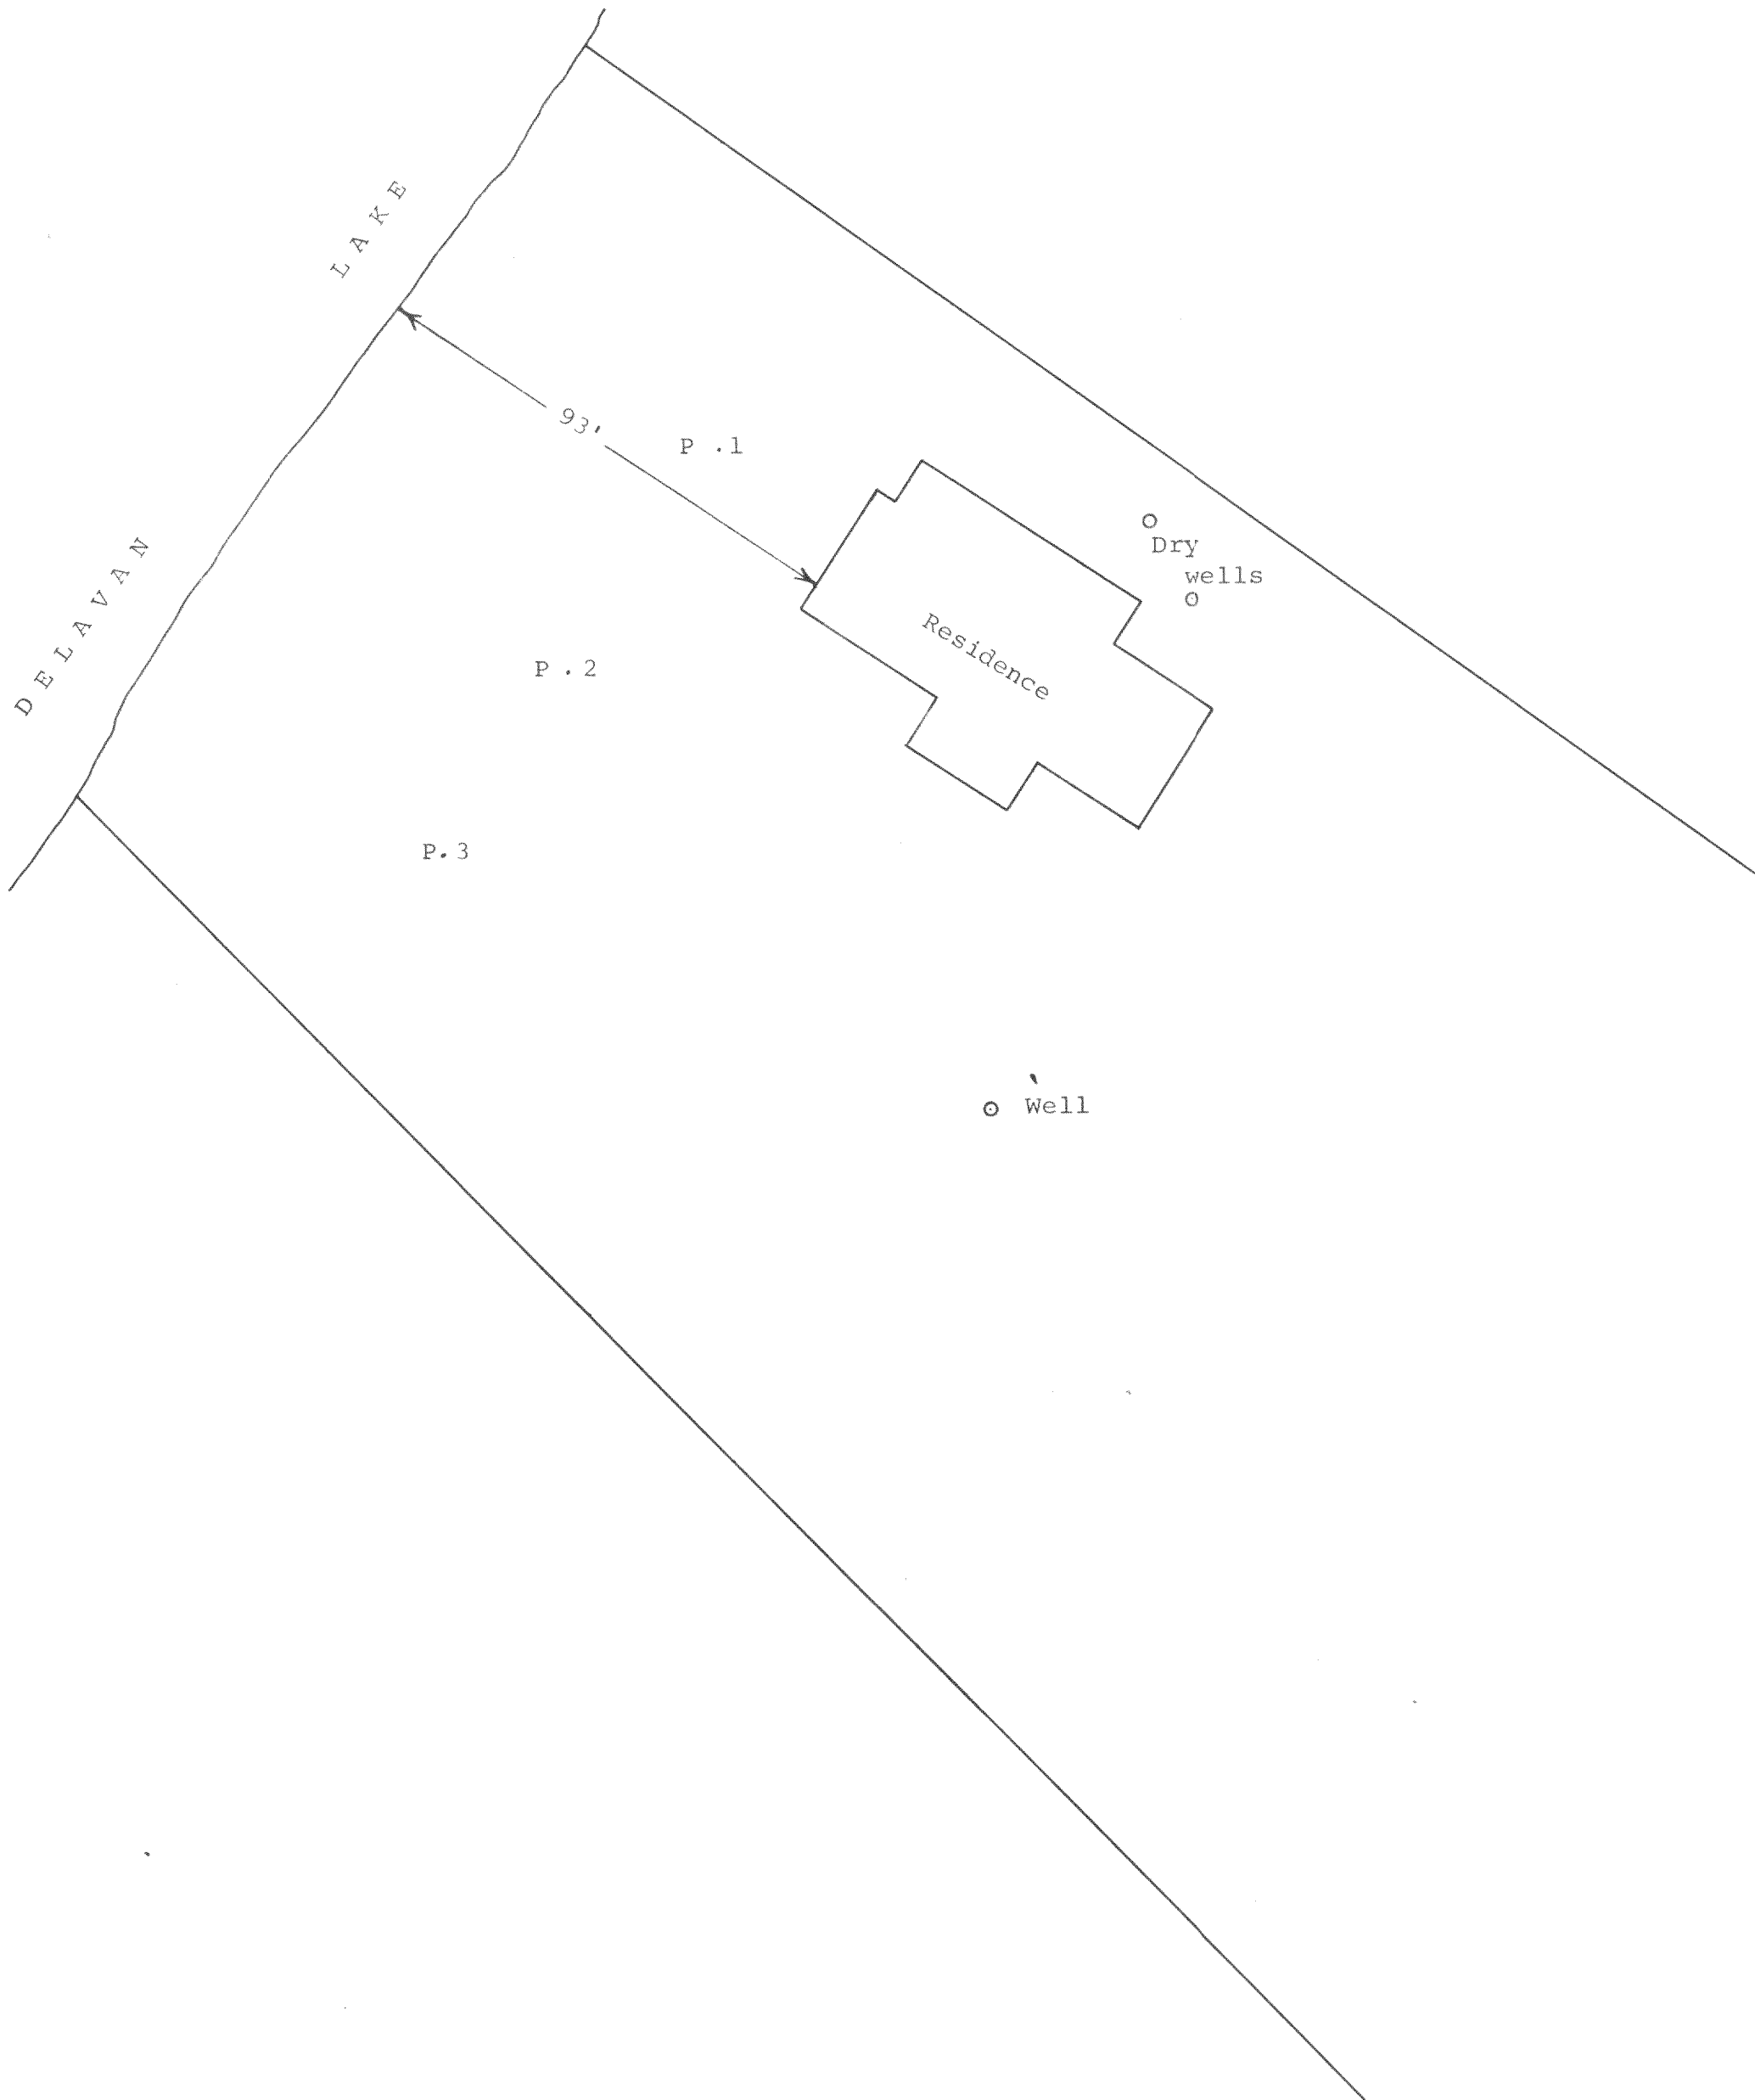

Scale - 1" = 30'

Plat showing the location of the Percolation tests
made on the E. P. Vanderwicken Property located in
Prospect Point Subdivision, Sections 28 & 33, T 2 N,
R 16 E, Walworth County, Wisconsin.
August 14, 1967

George T. Dunham
George T. Dunham, Surveyor

FLO-1
FPP-5
" 6