

CERTIFIED SURVEY NO. 2921


RECORDED IN VOLUME 15 OF CERTIFIED SURVEY
MAPS ON PAGE 178 AS
DOCUMENT NO. 368118

OWNER: KATHLEEN S. FOX
1530 NORTH STATE PARKWAY
CHICAGO, IL 60610

SOILS: MwD2, MyB, MwC2
ZONING: R-2

LOCATED IN PART OF THE NW 1/4 & SW 1/4 OF THE NE 1/4;
AND PART OF THE NE 1/4 & SE 1/4 OF THE NW 1/4 OF
SECTION 33, TOWN 2 NORTH, RANGE 16 EAST
WALWORTH COUNTY, WISCONSIN

NOTE: ALL LANDS IN THIS CSM FALL WITHIN
WALWORTH COUNTY SHORELAND ZONING.

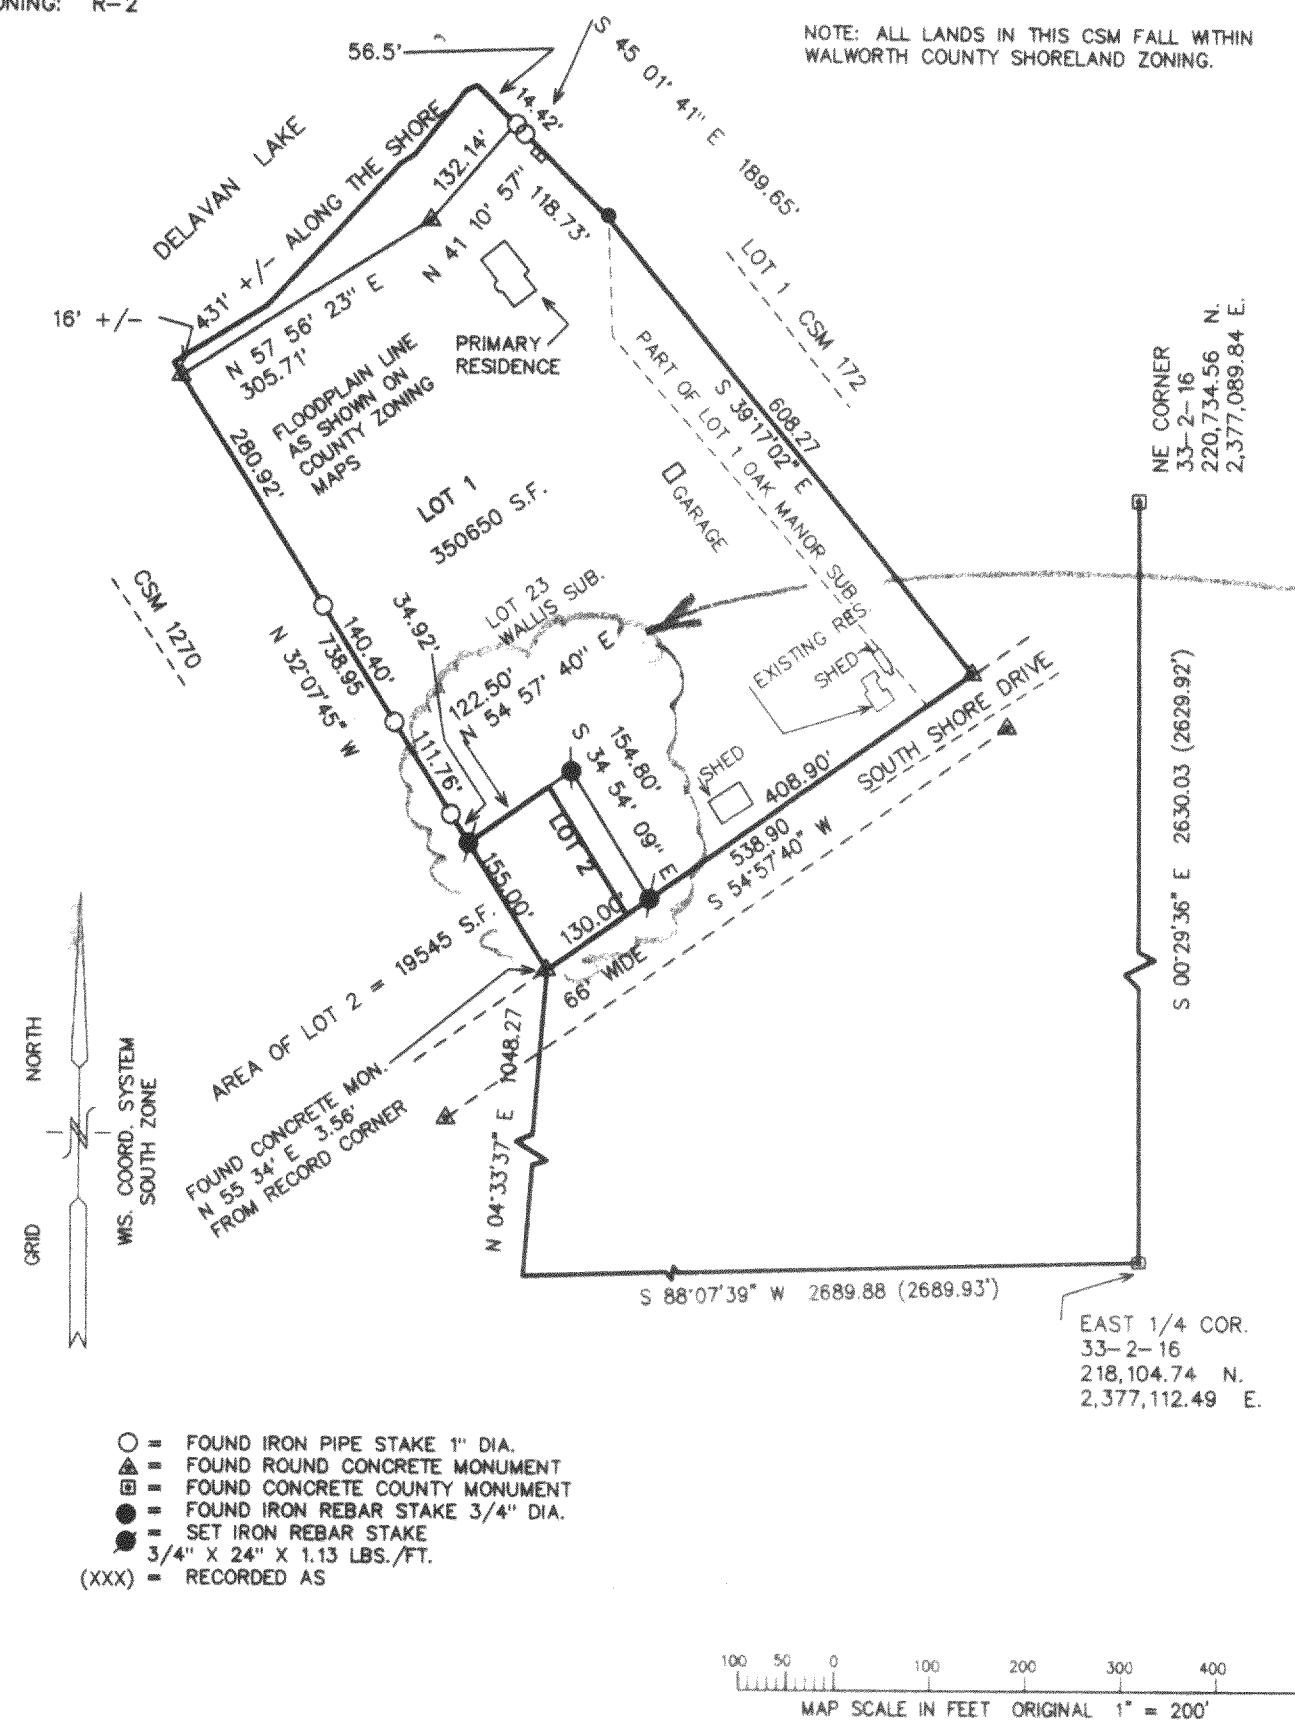
PLAT OF SURVEY
FOR LOT LINE ADJUSTMENT

PART OF CERTIFIED SURVEY MAP NO. 2921

LOCATED IN PART OF THE NW 1/4 & SW 1/4 OF THE NE 1/4;
AND PART OF THE NE 1/4 & SE 1/4 OF THE NW 1/4 OF
SECTION 33, TOWN 2 NORTH, RANGE 16 EAST
WALWORTH COUNTY, WISCONSIN

LEGAL DESCRIPTION
LOT LINE ADJUSTMENT PARCEL

A PART OF LOT 2 OF CERTIFIED SURVEY MAP NO. 2921, RECORDED IN VOLUME NO. 15 OF WALWORTH COUNTY CERTIFIED SURVEYS, ON PAGE NO. 8, AS DOCUMENT NO. 368118, TO BECOME A PART OF LOT 1 OF SAID CSM NO. 2921, LOCATED IN THE NORTHWEST AND SOUTHWEST 1/4'S OF THE NORTHEAST 1/4; AND PART OF THE NORTHEAST AND SOUTHEAST 1/4'S OF THE NORTHWEST 1/4 OF SECTION 33, TOWN 2 NORTH, RANGE 16 EAST, WALWORTH COUNTY, WISCONSIN, DESCRIBED AS FOLLOWS: BEGINNING AT THE SOUTHEAST CORNER OF LOT 2 OF SAID CERTIFIED SURVEY MAP NO. 2921 ON THE NORTHERLY LINE OF SOUTH SHORE DRIVE; THENCE S 54DEG 57MIN 40SEC W, 28.87 FEET ALONG SAID DRIVE; THENCE N 32DEG 07MIN 44SEC W, 155.00 FEET TO THE NORTH LINE OF SAID LOT 2; THENCE N 54DEG 57MIN 40SEC E, 21.37 FEET TO THE NORTHEAST CORNER OF SAID LOT 2; THENCE S 34DEG 54MIN 09SEC E, 11.80 FEET TO THE POINT OF BEGINNING. CONTAINING 3890 SQUARE FEET OF LAND (0.09 AC.) MORE OR LESS.

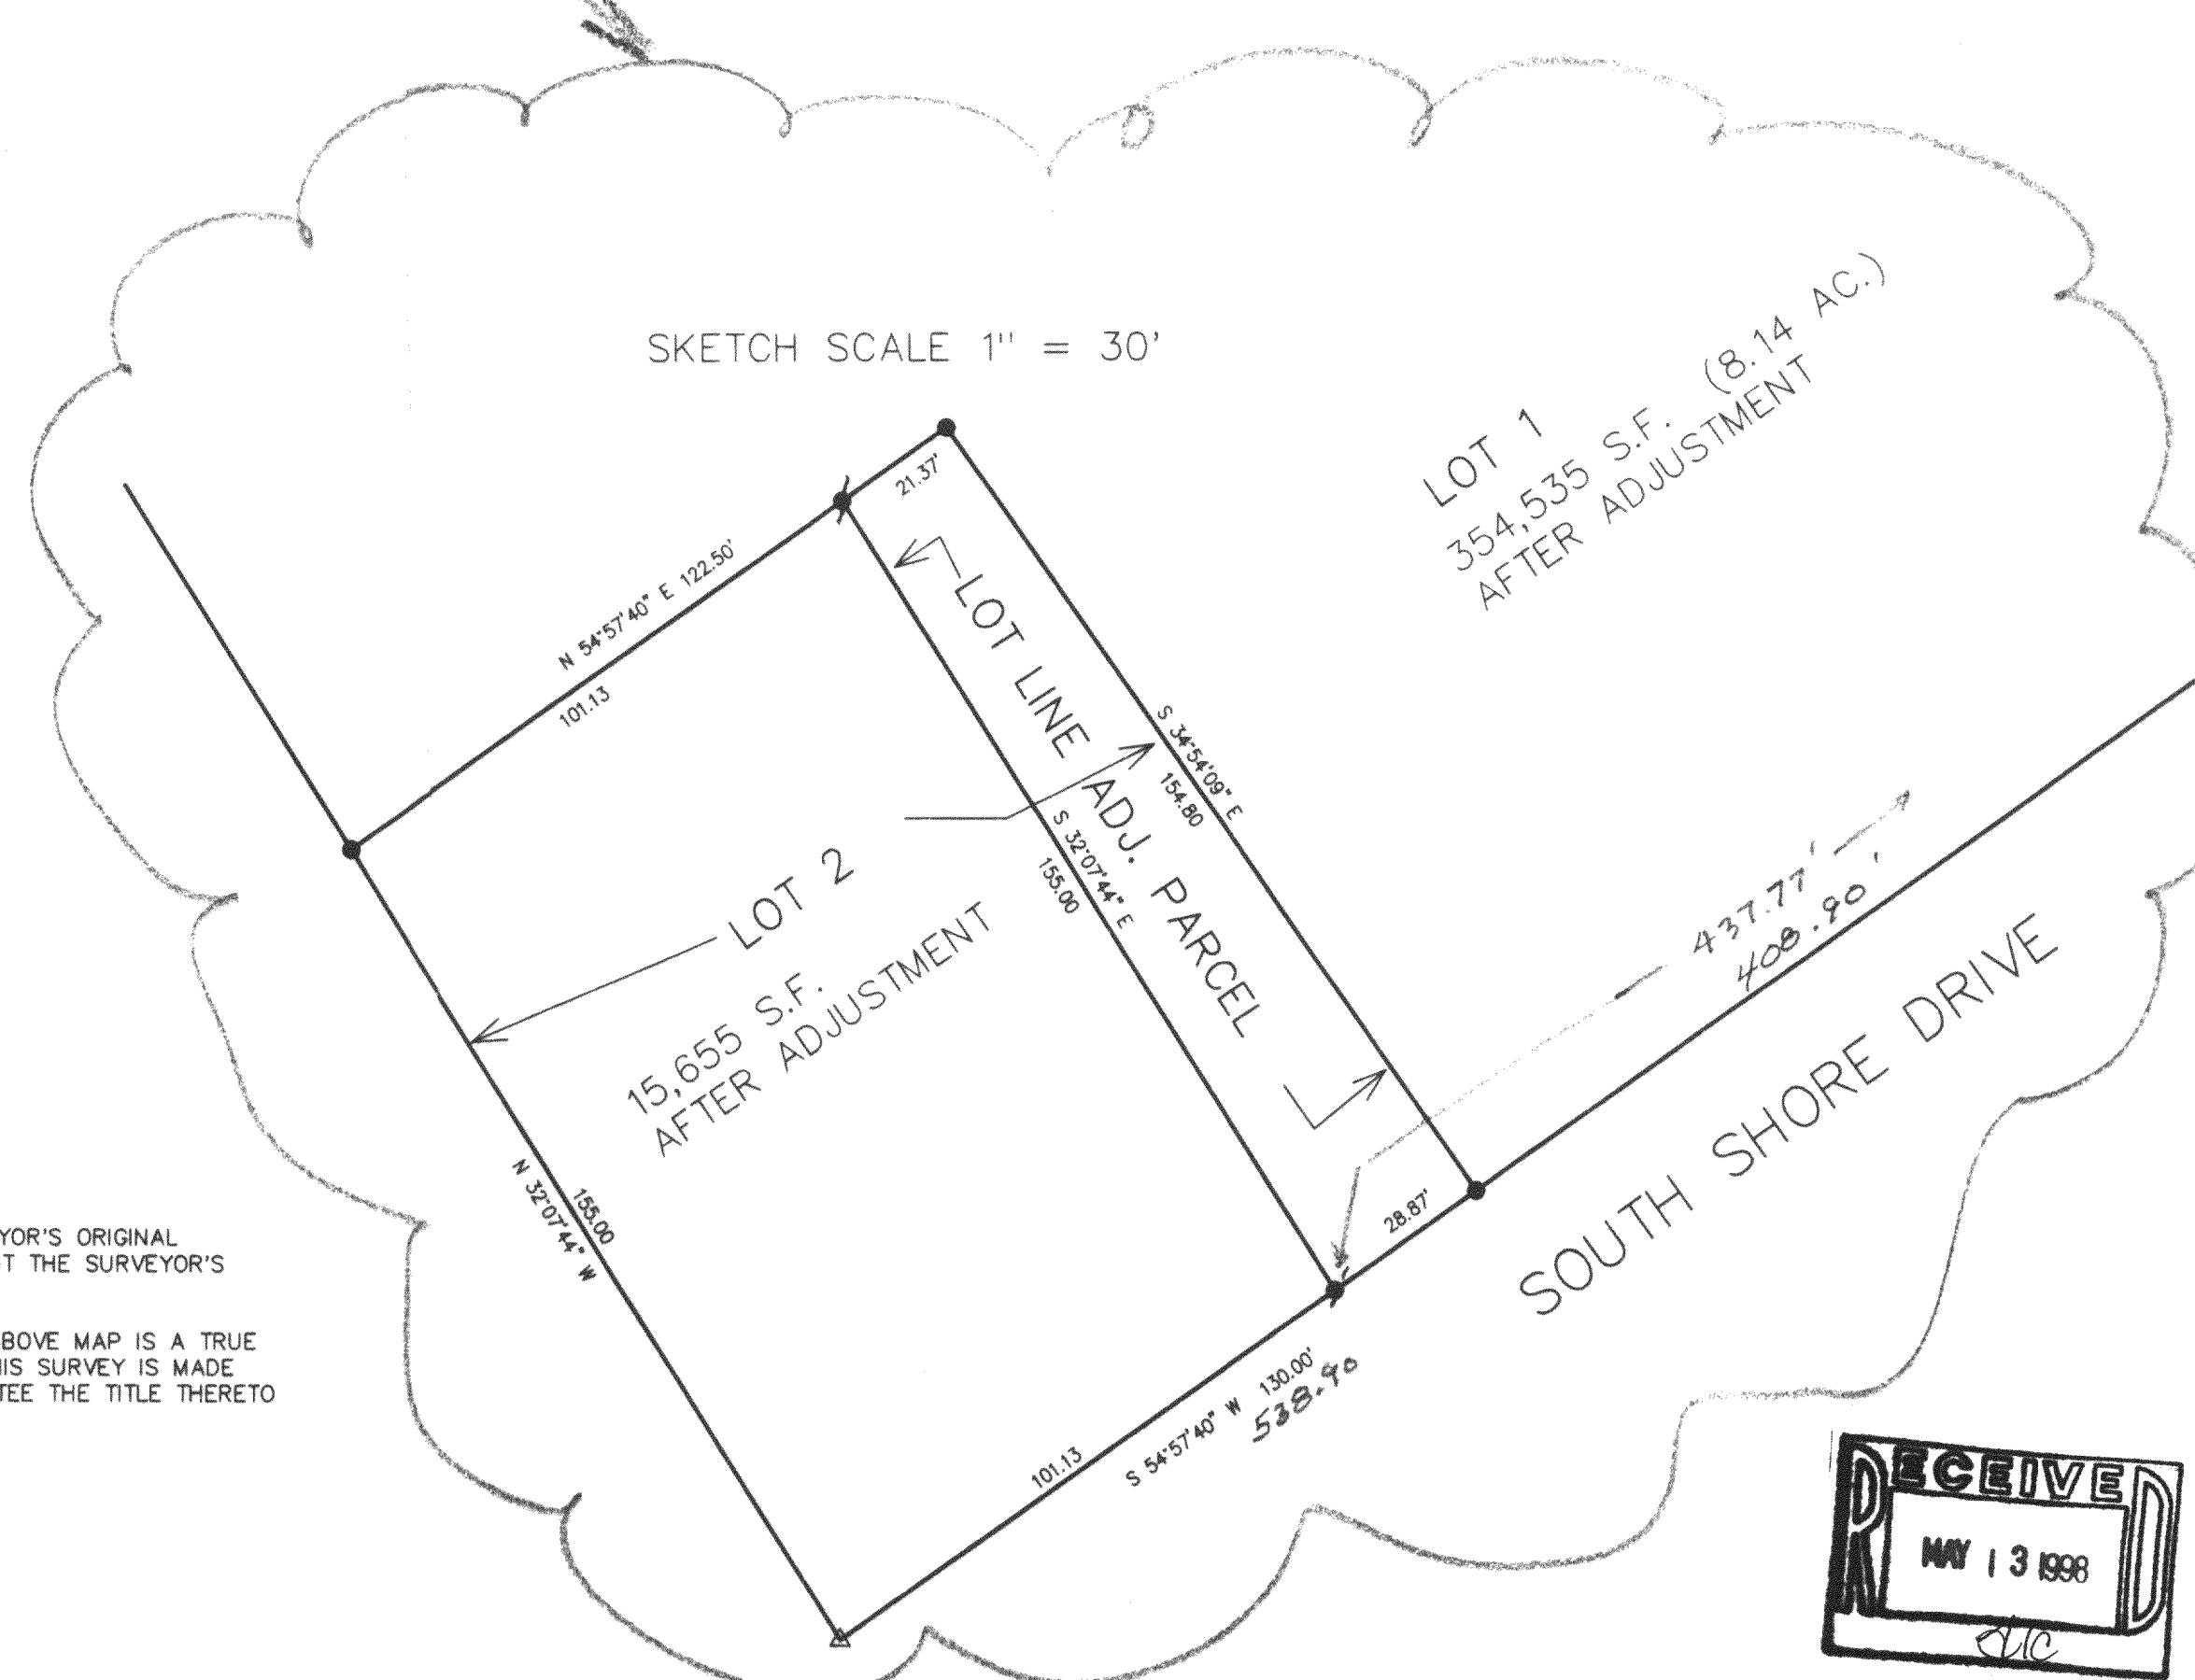

WORK ORDERED BY: KATHLEEN FOX
1530 NORTH STATE PARKWAY
CHICAGO, IL 60610

FARRIS, HANSEN & ASSOCIATES, INC
Engineering, Architecture, Surveying
7 Ridgeway Court, P.O. Box 437
ELKHORN, WISCONSIN 53121
Office: (414) 723-2098
Fax: (414) 723-5886

REVISIONS

PROJECT NO.
3507
DATE:
01-19-98
SHEET NO.
1 OF 1

FA-2921-1
FA-2921-2



DATED: 01-20-98

Peter S. Gordon
R.L.S. 2101
Elkhorn,
WI



216-2543