

ABELL
SURVEYING & MAPPING
DELAN, WISCONSIN 53115
414-728-6737

N




SCALE 1"=10'

LEGEND

- - IRON PIPE FOUND
- - IRON ROD FOUND
- - IRON PIPE SET
- - CONCRETE MONUMENT FOUND
- () - RECORDED AS

NOTE: BEARINGS ARE REFERENCED TO
EXISTING SURVEY RECORDS.

DUTCH MILL LANE

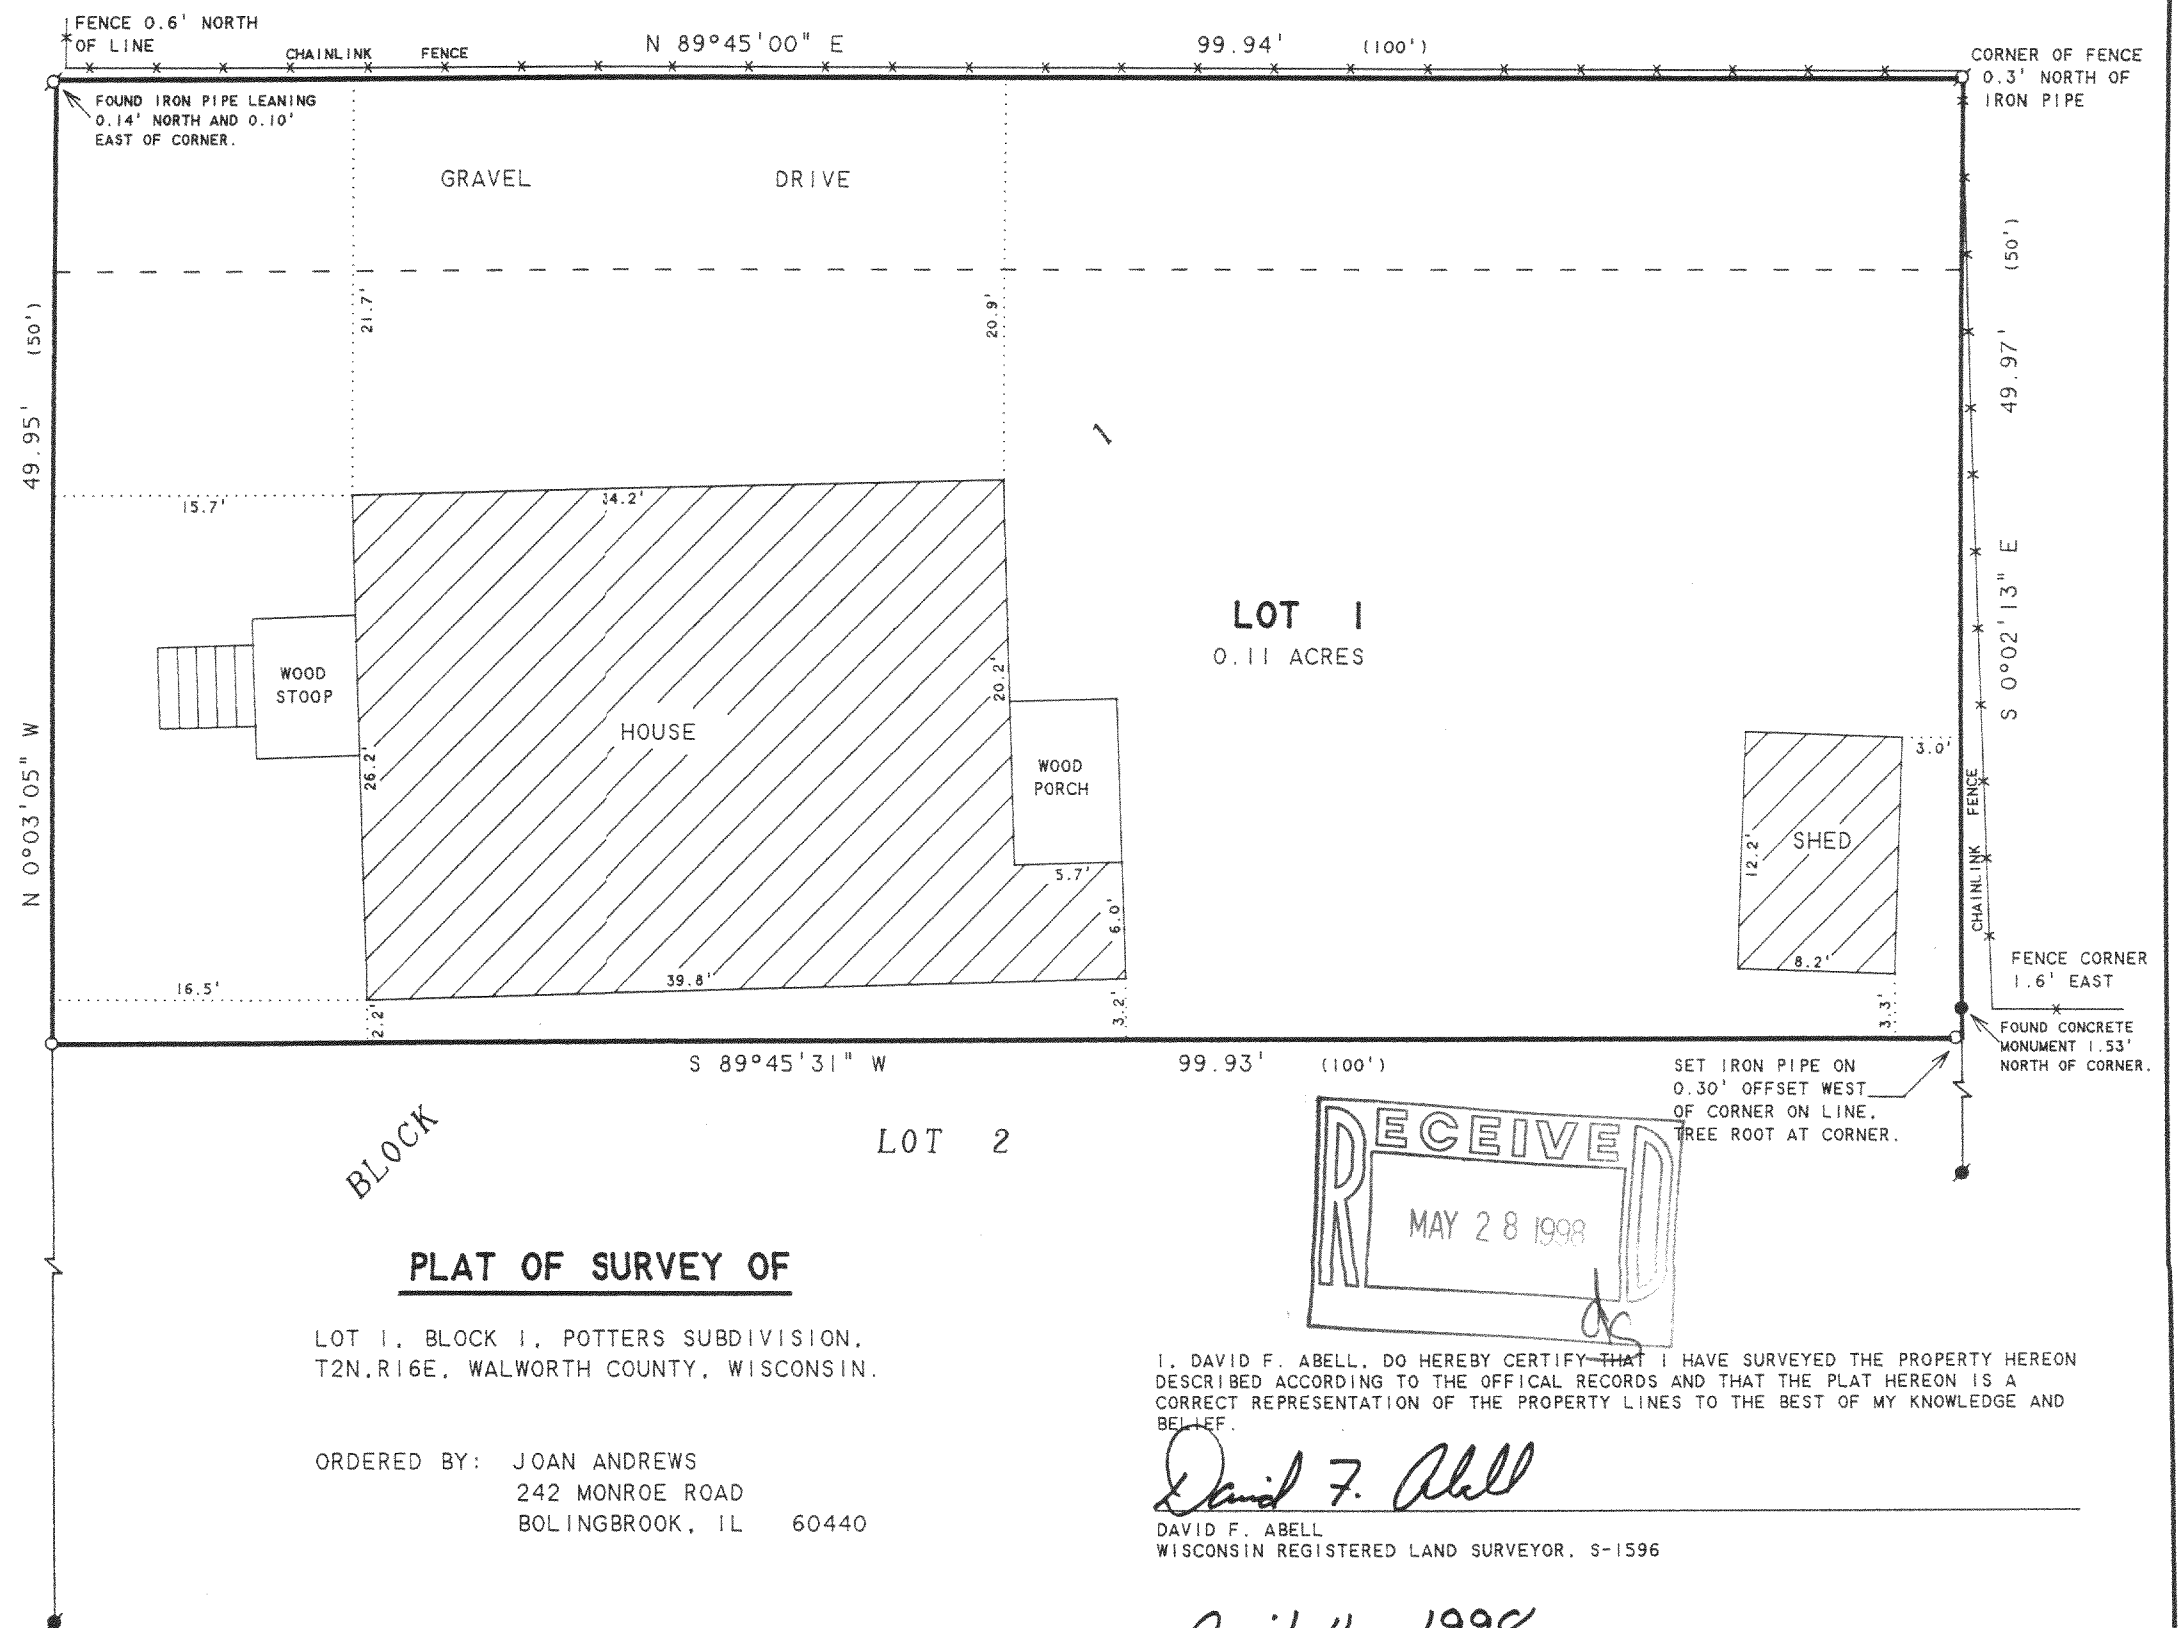

FPO-1
216-2558