

ABELL
SURVEYING & MAPPING
DELAVAN, WISCONSIN 53115
414-728-6737



SCALE 1"=30'


LEGEND

- - IRON PIPE FOUND
- - IRON PIPE SET
- * - WIRE FENCE
- - IRON ROD FOUND
- () - RECORDED AS

PLAT OF SURVEY OF

LOTS 15-17, BLOCK 4, INLET OAKS SUBDIVISION
NO. 4, T2N.R16E, WALWORTH COUNTY, WISCONSIN.

ORDERED BY: MARK BOSS
413 SCHROEDER AVE.
DELAVAN, WI 53115

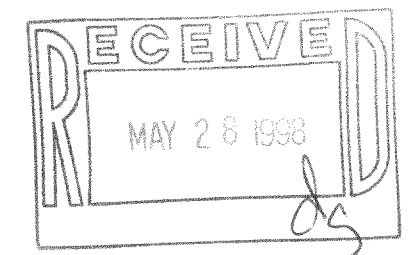


I, DAVID F. ABELL, DO HEREBY CERTIFY THAT I HAVE SURVEYED THE PROPERTY HEREON DESCRIBED ACCORDING TO THE OFFICIAL RECORDS AND THAT THE PLAT HEREON IS A CORRECT REPRESENTATION OF THE PROPERTY LINES TO THE BEST OF MY KNOWLEDGE AND BELIEF.

David F. Abell

DAVID F. ABELL
WISCONSIN REGISTERED LAND SURVEYOR, S-1596

May 4, 1998

DATE: May 4, 1998 JOB NUMBER - 98068
NOTE: THIS IS NOT A CERTIFIED COPY UNLESS SEALED.

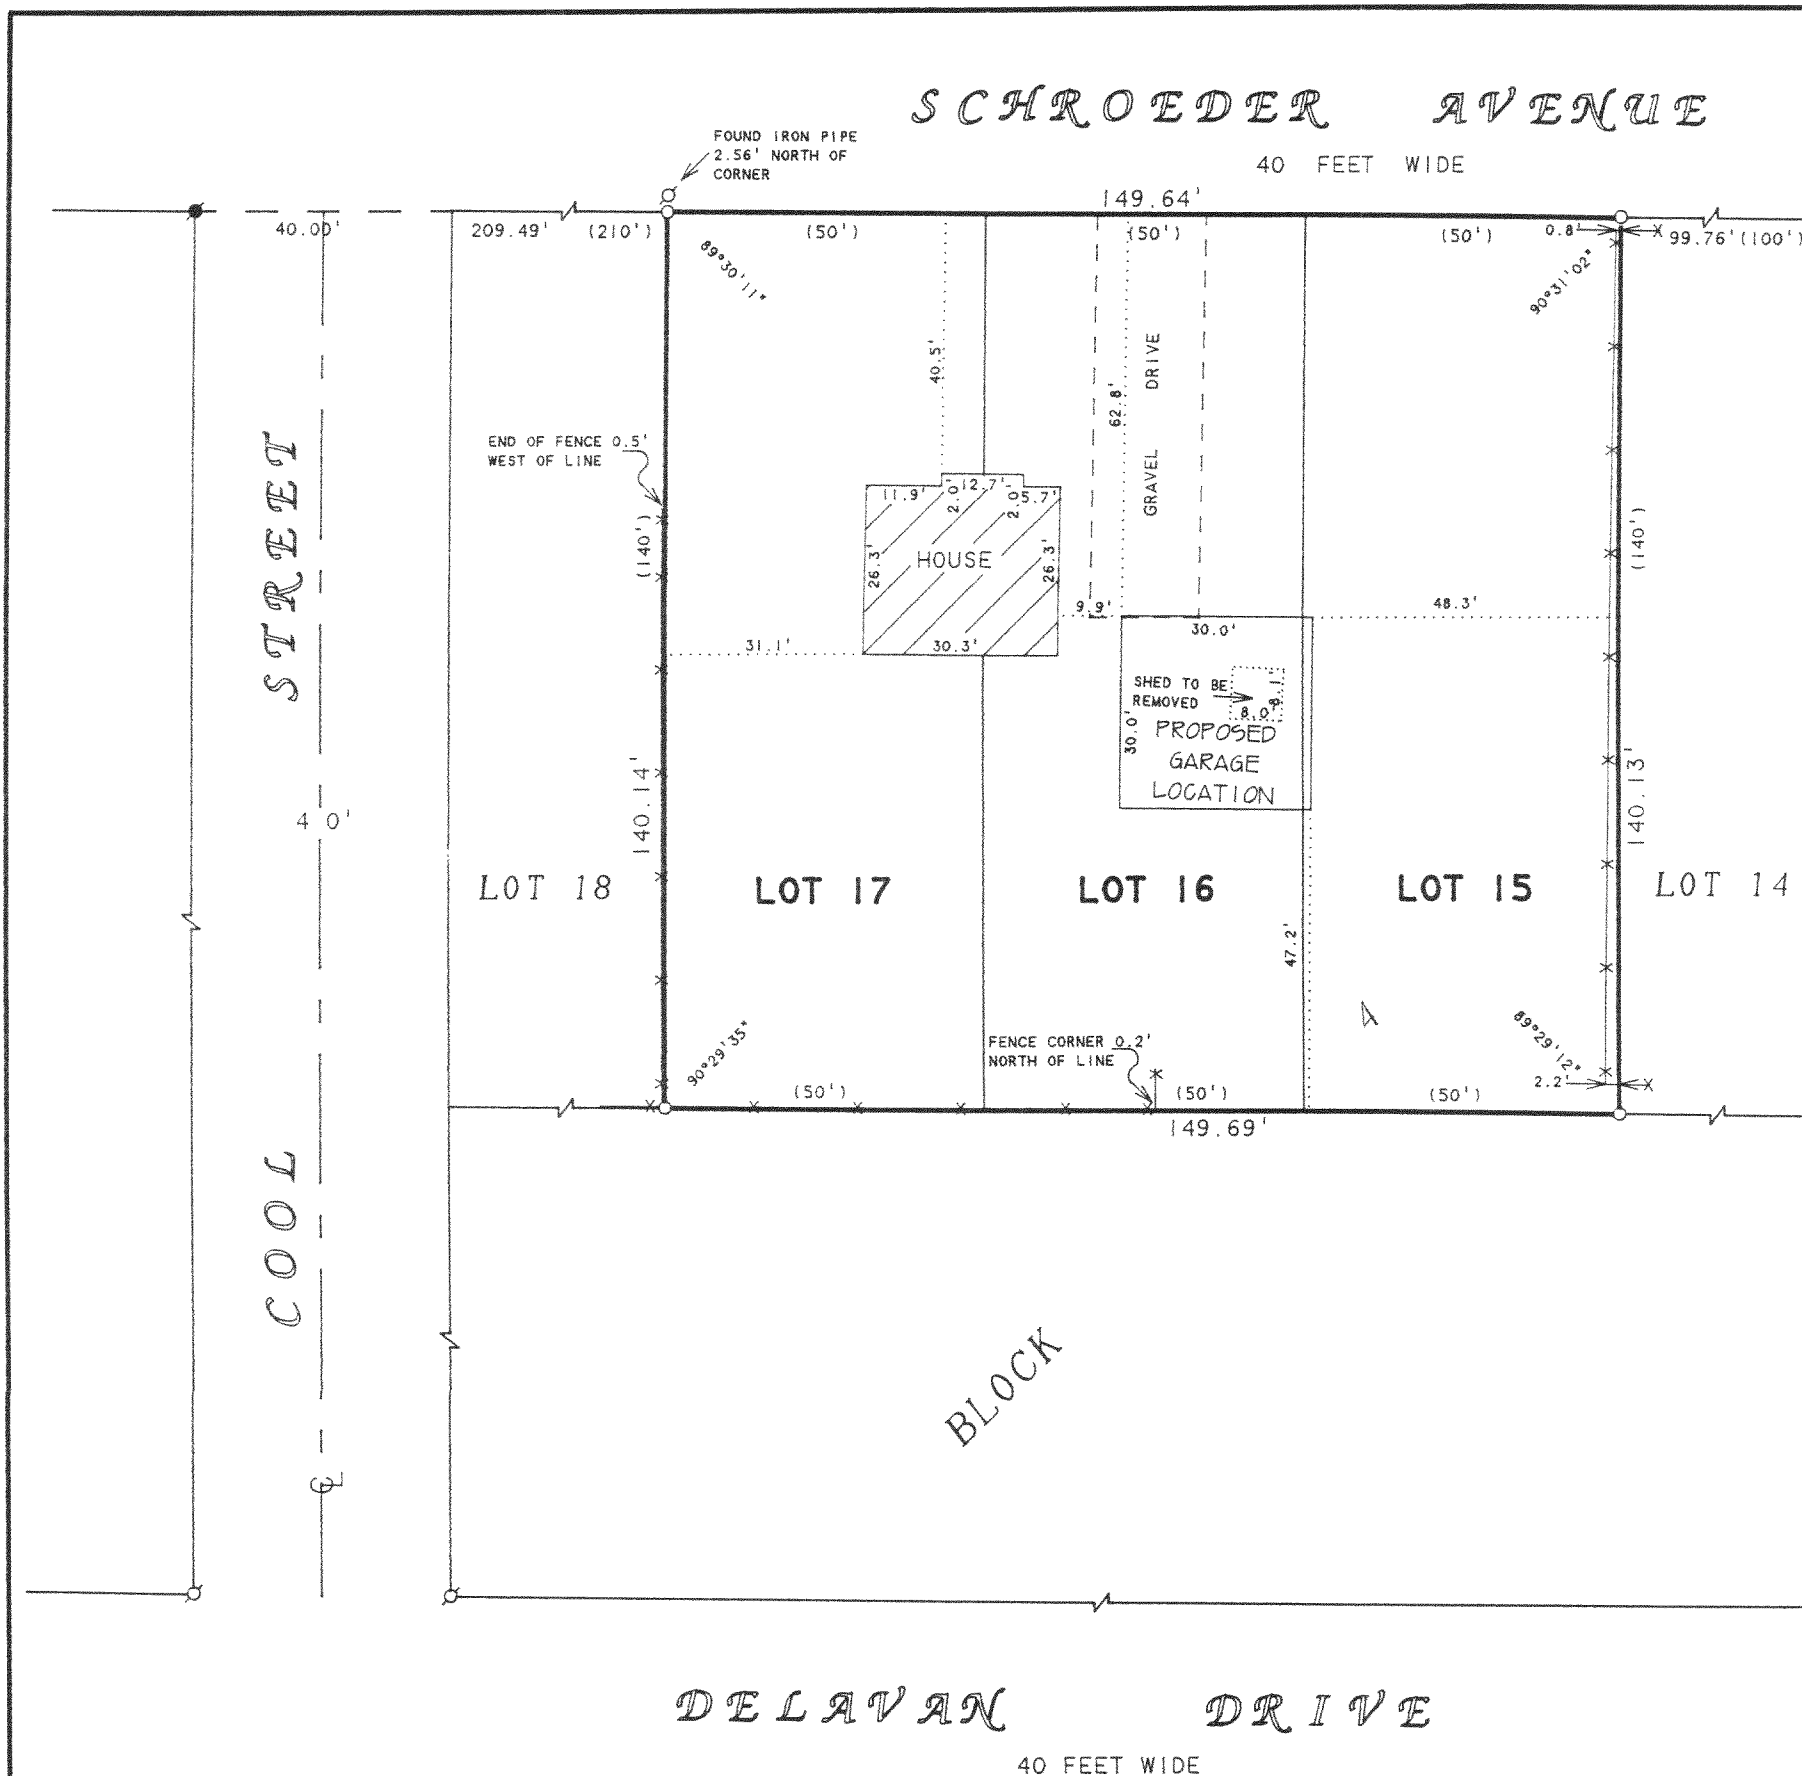

FIN4-31A
216-2562