


GEORGE T. DUNHAM
SURVEYING & SUBDIVIDING
DELAVAN, WISCONSIN

N



Scale - 1" = 20'

Tilden Avenue

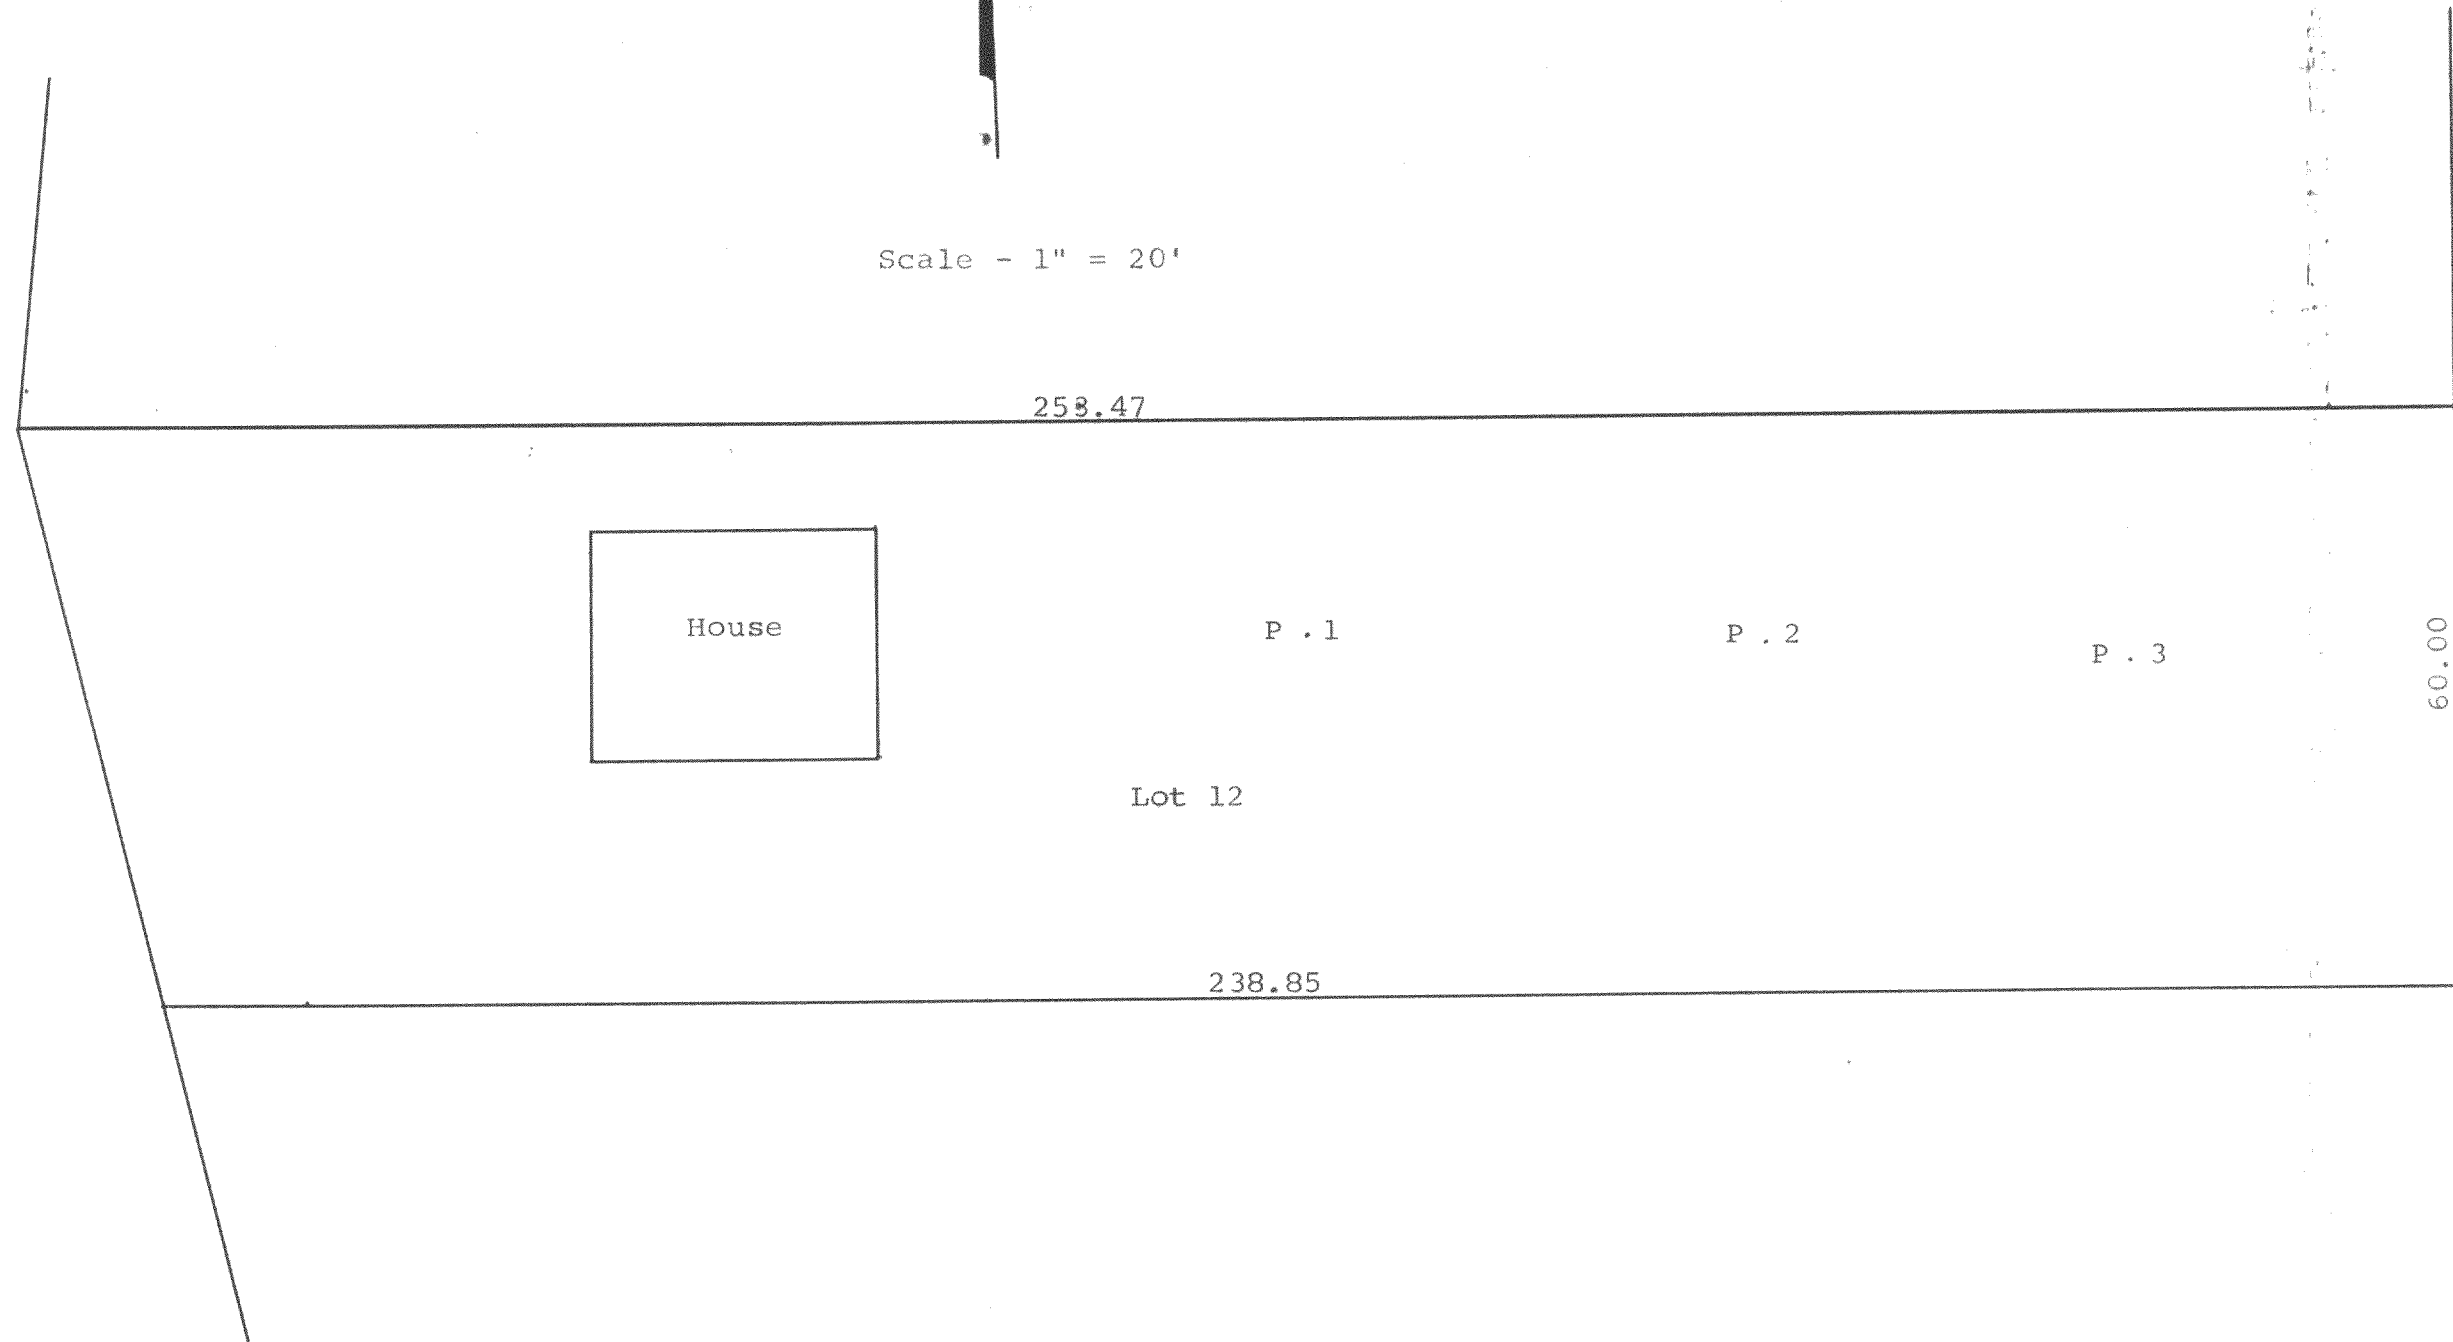

Plat showing the location of the percolation tests made
on Lot 12, Block 7, Delmar Subdivision, Town of Delavan,
Walworth County, Wisconsin. Bernard Kozel - Owner.
November 15, 1967

FDM-36

George T. Dunham
George T. Dunham, Surveyor

216-257