



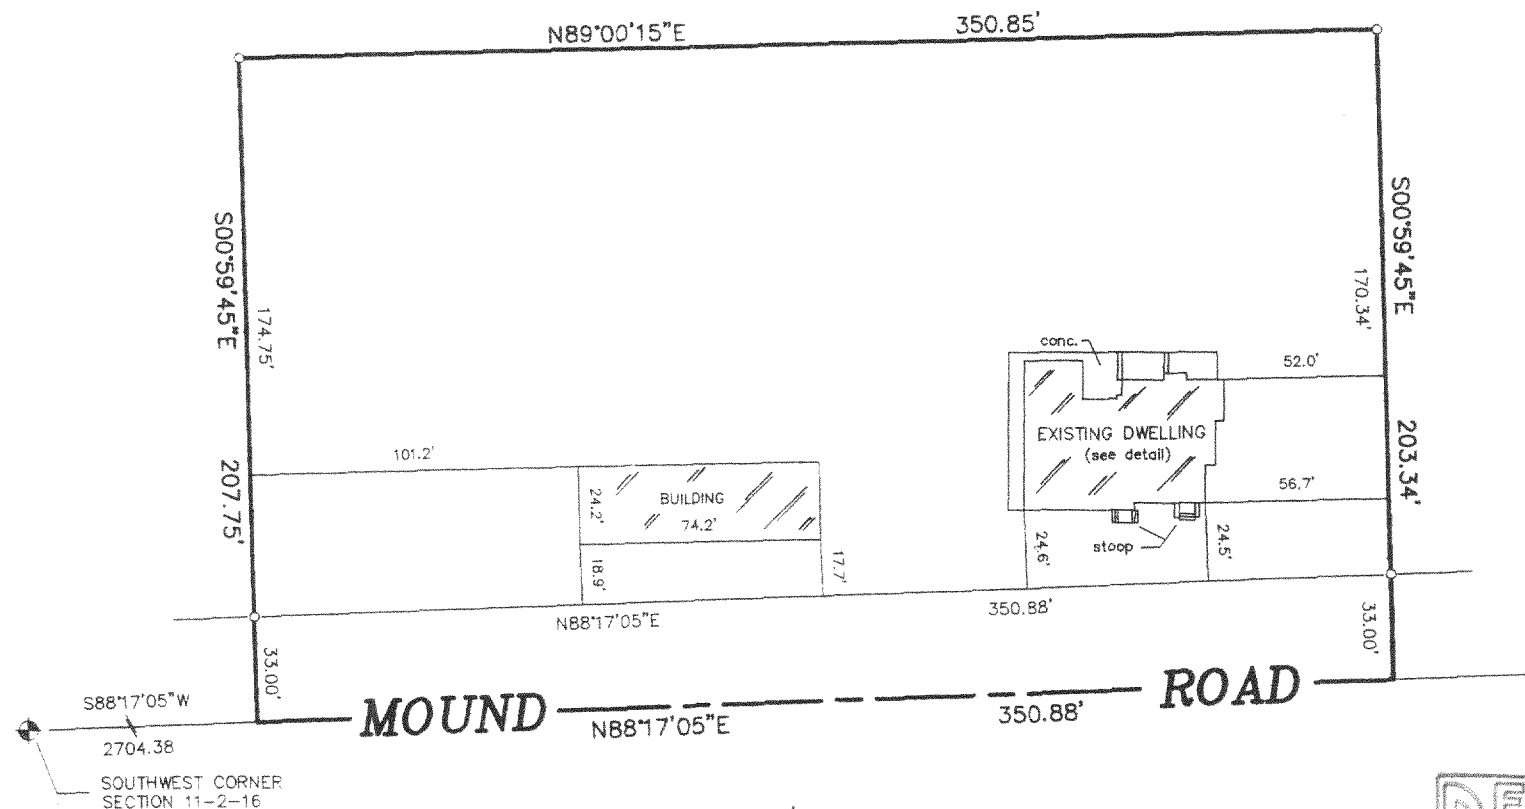

PLAT OF SURVEY
-OF-
LOT 1 OF CERTIFIED SURVEY AMP NO. 1449, LOCATED
IN THE SOUTHEAST 1/4 OF SECTION 11, TOWNSHIP 2
NORTH, RANGE 16 EAST, WALWORTH COUNTY,
WISCONSIN.

SURVEY FOR: DARLENE ROEN
SURVEY LOCATION: _____ MOUND ROAD

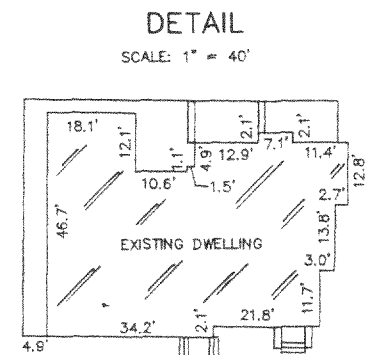

"I hereby certify that I have surveyed the above described property and that the above map is a correct representation thereof and shows the size and location of the property, its exterior boundaries, the location of all visible structures and dimensions of all principal buildings thereon, boundary fences, apparent easements, roadways and encroachments, if any."

"This survey is made for the use of the present owners of the property, and those who purchase, mortgage, or guarantee the title thereto within one year from date hereof."





B.W. SURVEYING

412 N. PINE STREET
BURLINGTON, WI 53105
(414)-767-0225

SCALE 1" = 60'

○ SET IRON PIPE

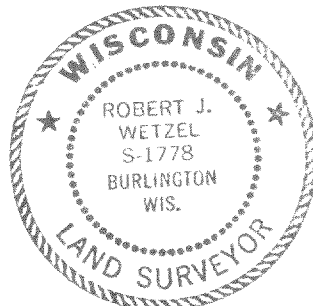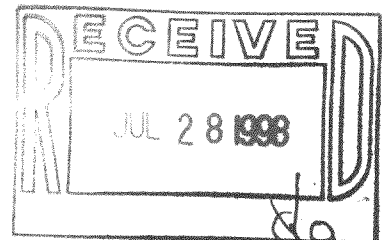

Robert J. Wetzel
ROBERT J. WETZEL S-1778

JUNE 15, 1998
DATE

3518
JOB NUMBER

FA-1449-1 216-2586