


GEORGE T. DUNHAM

SURVEYING & SUBDIVIDING
DELAVER, WISCONSIN

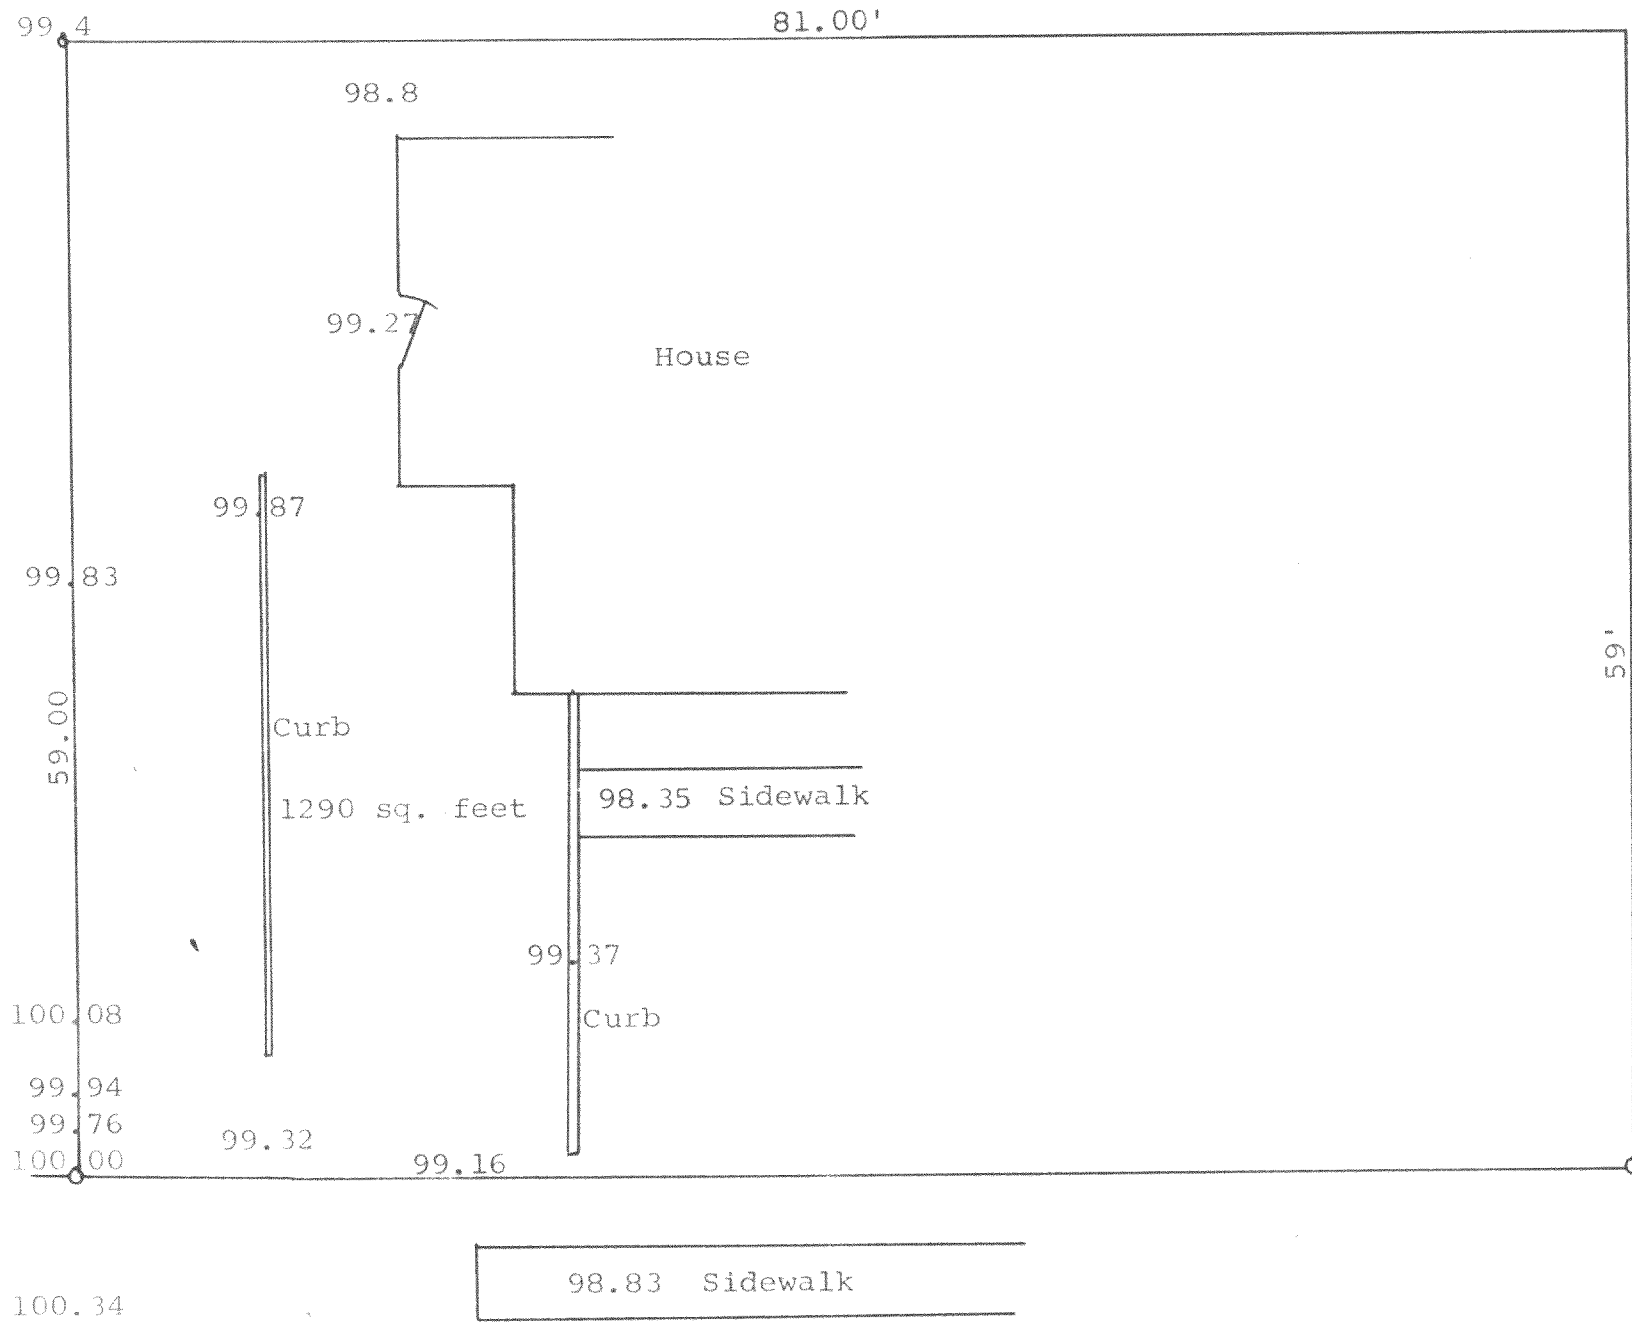

Scale - 1" = 10'

Elevations on Lots 1, 2, & the East 21' of Lot 3
in Block "A" of Jacksons Subdivision located in
Section 21, T 2 N, R 16 E, Walworth County, Wisc.
May 1, 1967

George T. Dunham
George T. Dunham, Surveyor

216-262