


GEORGE T. DUNHAM
SURVEYING & SUBDIVIDING
DELAVAN, WISCONSIN

N

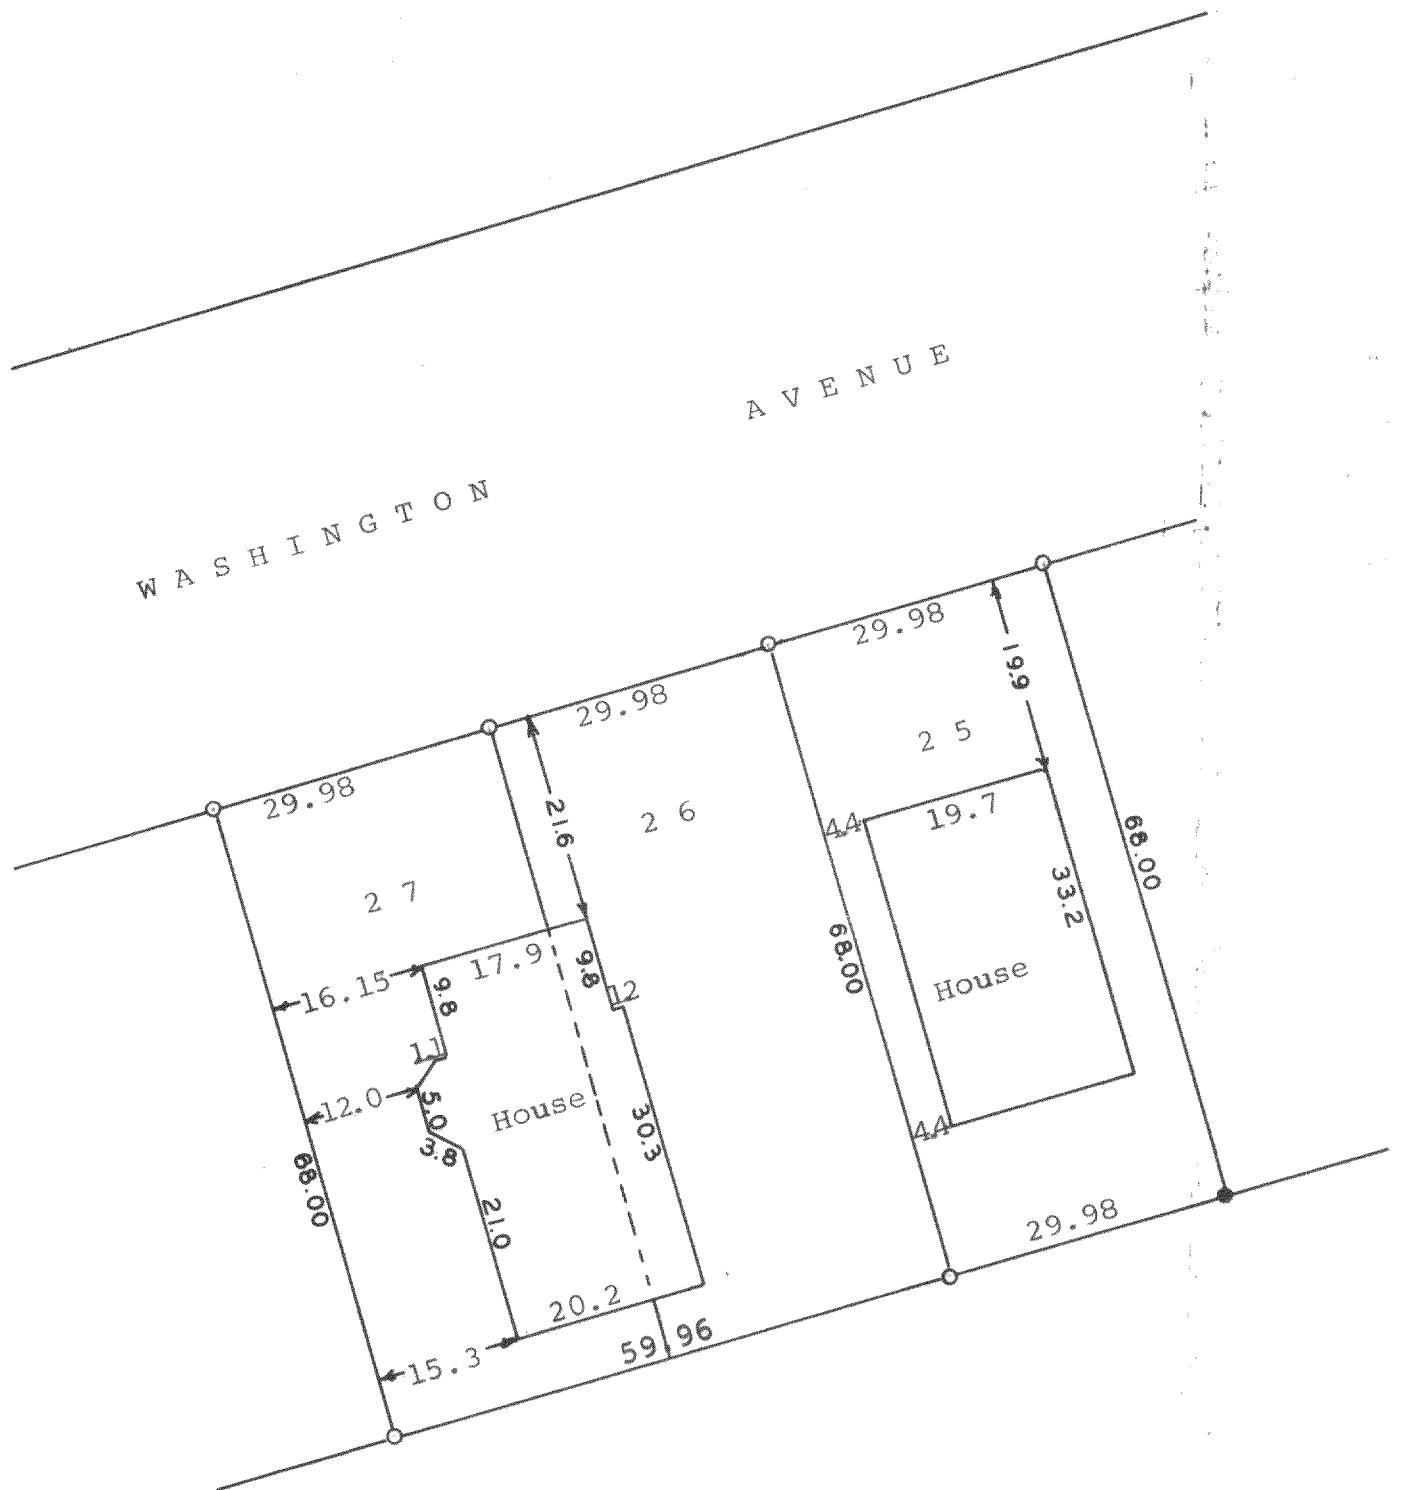

Scale - 1" = 20'

○ = Iron Pipe

● = Concrete Monument

Plat of survey of Lots 25, 26, & 27 in Block "A" of
Delavan Lake Assembly Grounds located in the Town of
Delavan, Walworth County, Wisconsin.
June 30, 1967

George T. Dunham
George T. Dunham, Surveyor

216-266

FDLA-198, 20