


GEORGE T. DUNHAM
SURVEYING & SUBDIVIDING
DELAVAN, WISCONSIN

N

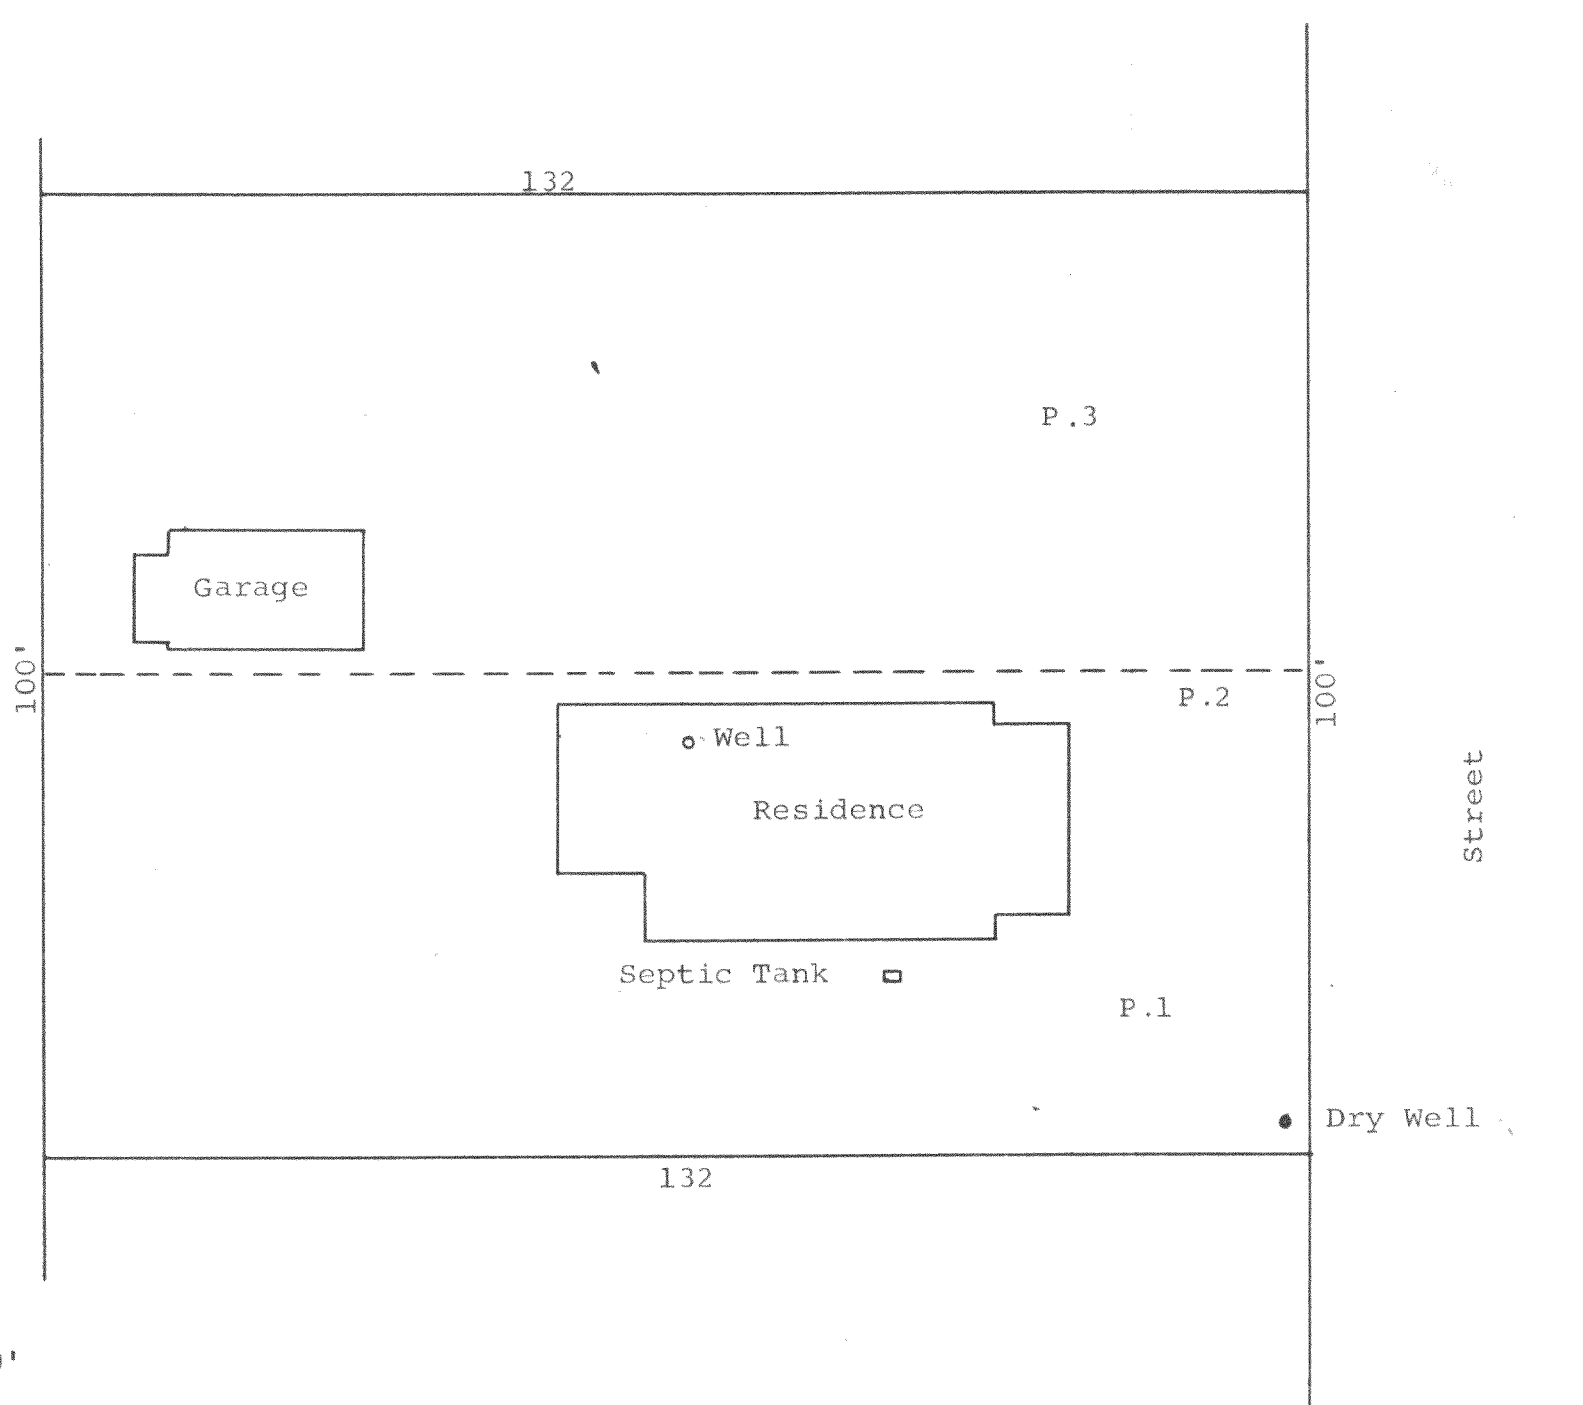

Front of Residence 230 feet from Delavan Lake
Inlet
Water Elevation 100.0
P.1 " 106.2
P.2 " 106.6
P.3 " 106.8

Scale - 1" = 20'

Plat of the George Greene Property consisting of Lots
18 & 19, Block 3, Inlet Oaks Subdivision, Town of
Delavan, Walworth County, Wisconsin.
April 24, 1967

George T. Dunham
George T. Dunham, Surveyor

216-267

FIN-42