

1140 SEQUOIA STREET • DELAVAN, WISCONSIN 53115
414-728-6737

LOT 14

2.6'

HOUSE

GUTTERS EXTEND 0.1' EAST OF LINE

LOT 13

CH=38.70'

106°10'38"±2.2'

129°22'17"

CH=19.20'

128°25'18"

13.9'

"H"

28.2'

HOUSE UNDER CONSTRUCTION

12-8-98

CONCRETE

LOT 12

57.50'

178°51'52"

CH=64.99'

EDGE OF BLACKTOP ROADWAY

IRON PIPE FOUND 0.37' WEST OF LINE

LOT 11

GRAVEL DRIVE

CH=30.12'

87°46'17"

10.0'

0.4'

58.58'

(58')

2.7'

HOUSE

LOT 10

58'

CH=30.00'

179°49'10"

30'

(35')

(56')

(30')

1.9'

WELL

12.8'

90°10'28"

BLACKTOP DRIVE

4.6'

0.3'

FOUND PK NAIL IN LANDSCAPE TIMBER. EDGE OF LANDSCAPE TIMBER EXTENDS 0.2' EAST OF LINE

BLOCK 12

LINCOLN AVENUE

SOUTH GABIZO DRIVE



EDGE OF BLACKTOP ROADWAY

DECEMBER 8, 1998. REVISED TO SHOW HOUSE UNDER CONSTRUCTION.

DESCHNER BUILDING CONTRACTORS

ORDERED BY: DESCHNER BUILDING CONTRACTORS
3338 N. SHORE DRIVE
DELAVER, WI 53115

LOTS 11-13, BLOCK "H", DELAVAN LAKE
ASSEMBLY GROUNDS, LOCATED IN T2N, R16E,
WALWORTH COUNTY, WISCONSIN.

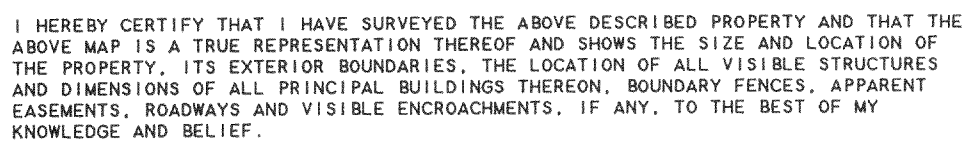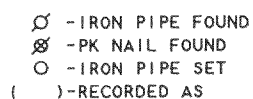

THIS SURVEY IS MADE FOR THE USE OF THE PRESENT OWNERS OF THE PROPERTY, AND ALSO THOSE WHO PURCHASE, MORTGAGE, OR GUARANTEE THE TITLE THERETO WITHIN ONE (1) YEAR FROM DATE HEREON.

DAVID F. ABELL
WISCONSIN REGISTERED LAND SURVEYOR, S-1596

DATE _____ JOB NUMBER - 98012
NOTE: THIS IS NOT A CERTIFIED COPY UNLESS SEALED.

FDLA-97
~~FDLA-9-1A~~