

I GEORGE T. DUNHAM, DO HEREBY CERTIFY THAT I HAVE SURVEYED THE PROPERTY DESCRIBED AS FOLLOWS:


REV 16 FD FEBRUARY 5, 1954

1000

total 8 + 9 of Austin + Golden

George T. Dunham
GEORGE T. DUNHAM, SURVEYOR
DELAWARE, WISCONSIN
216-27

216-27

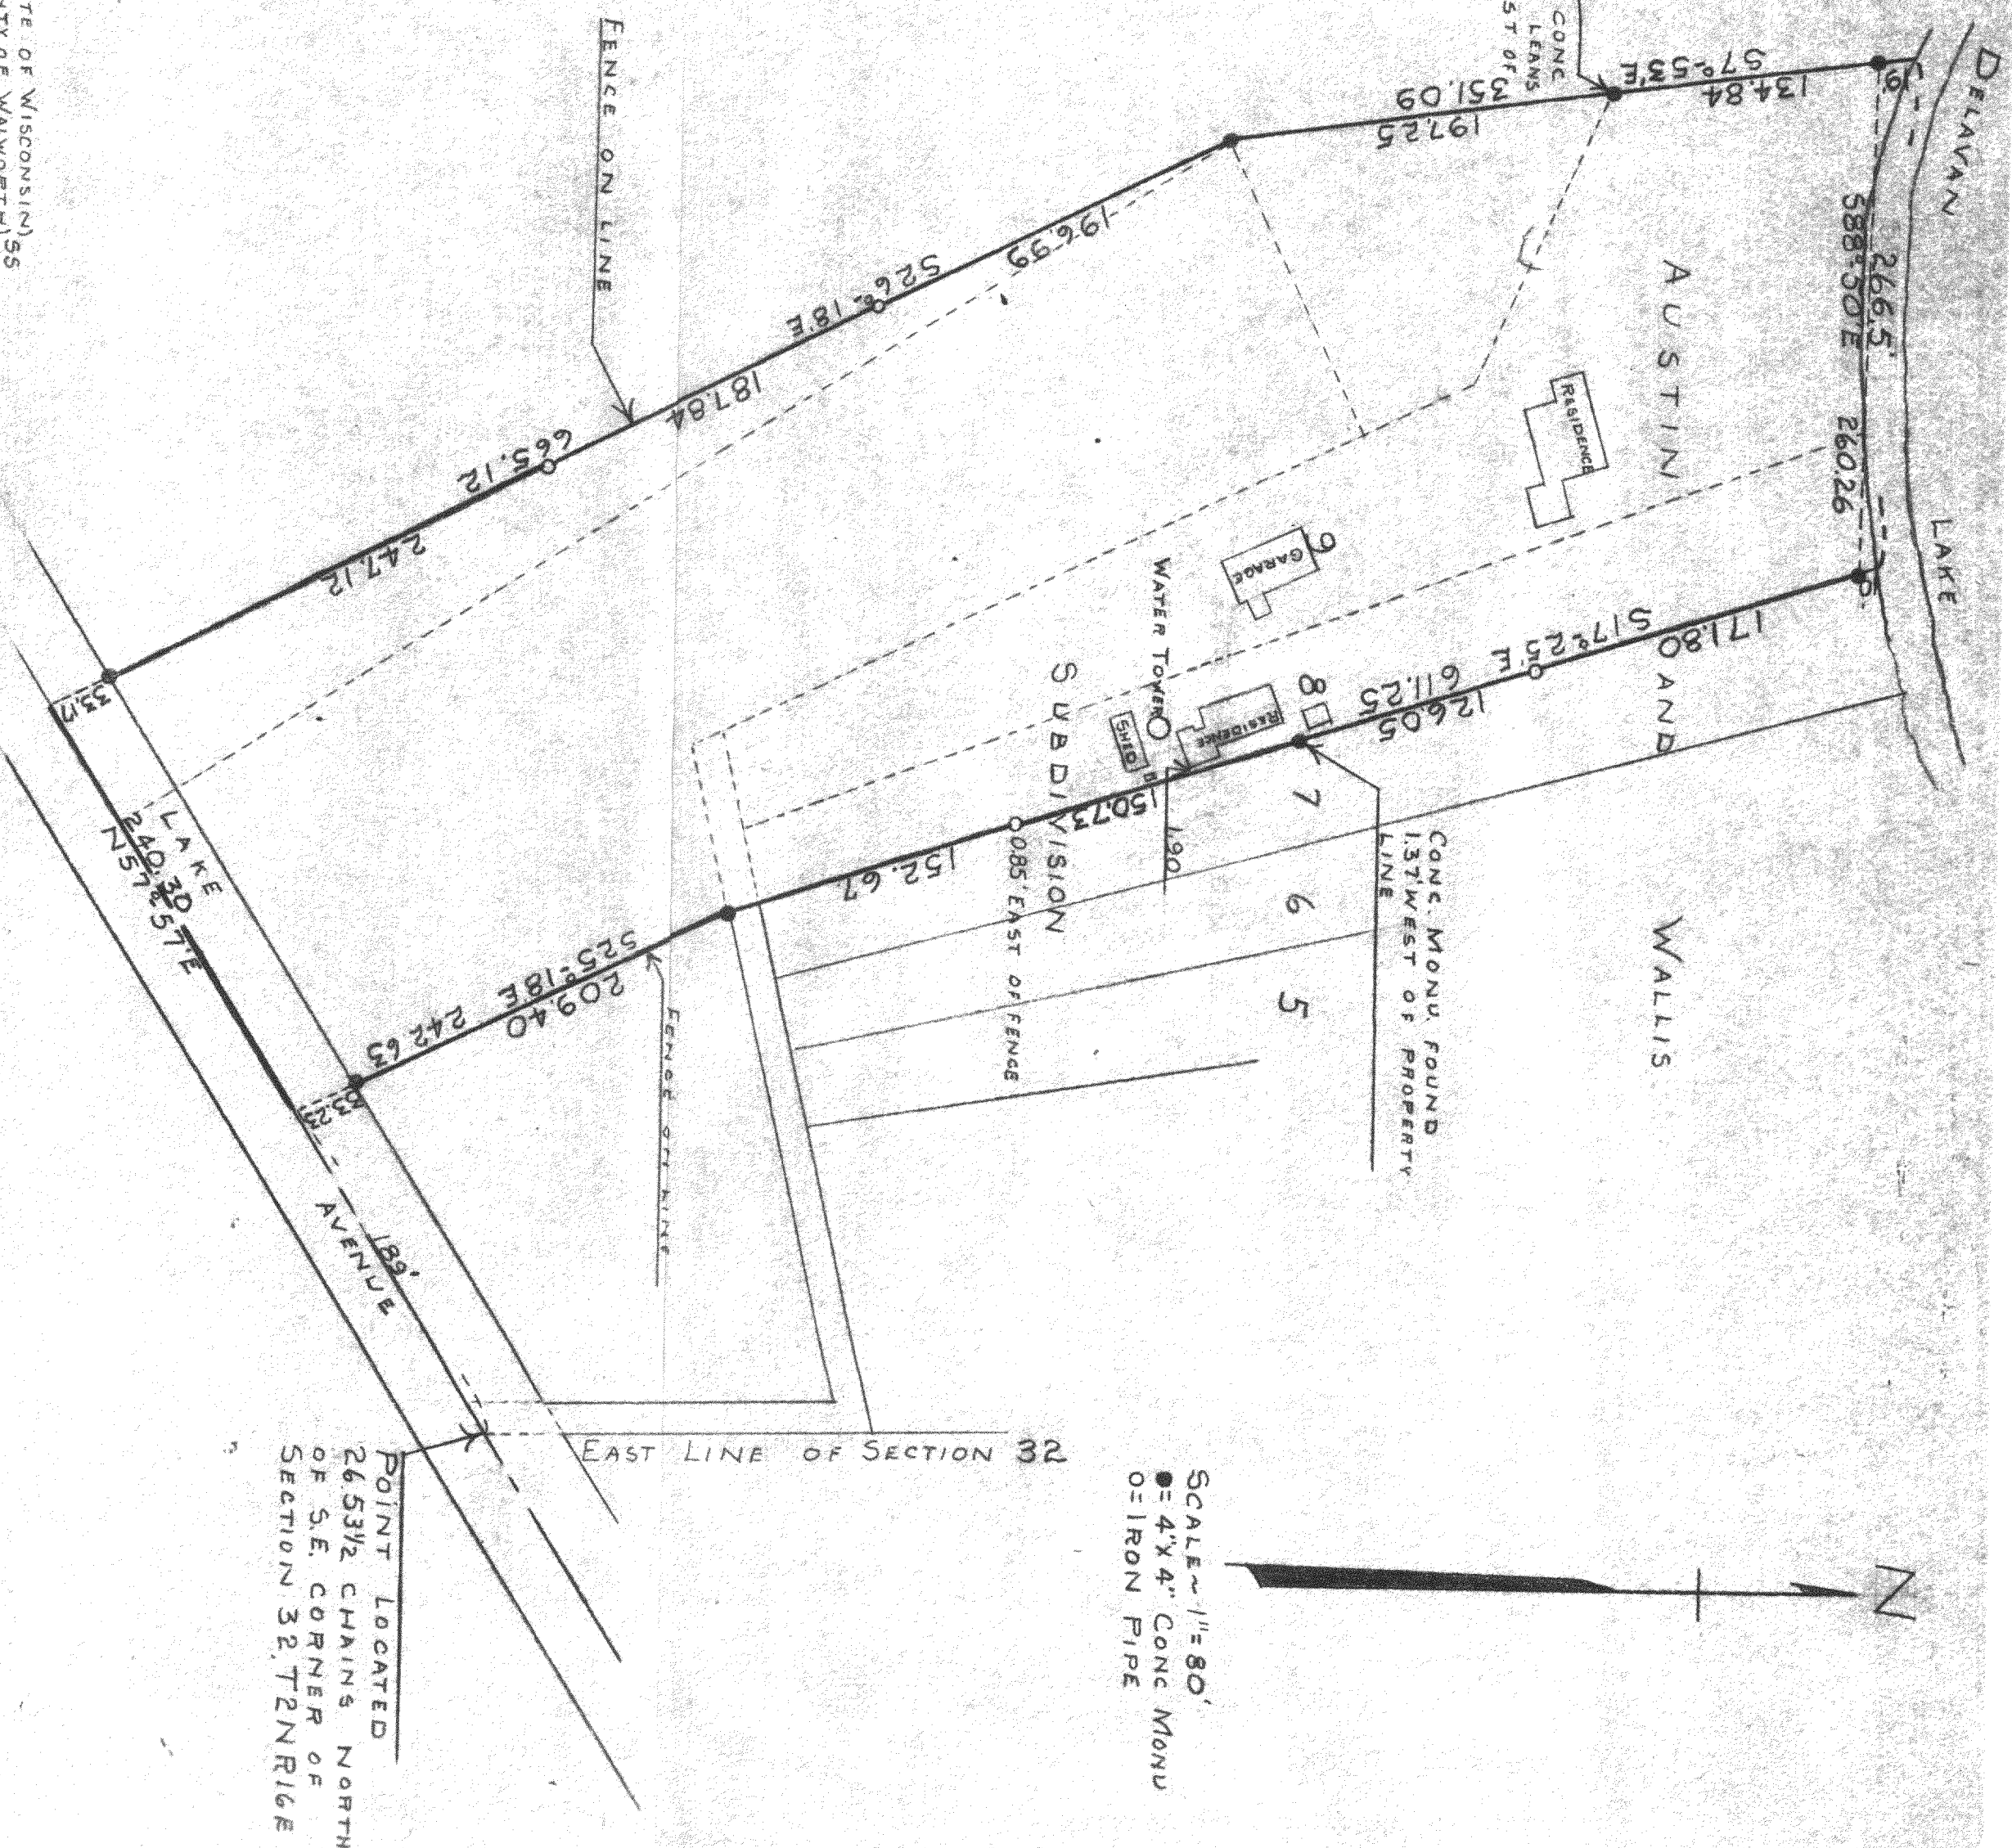

SCALE ~ 1" = 80'
● = 4" x 4" CONC MONU
○ = IRON PIPE