


PLAT OF SURVEY


EXISTING RESIDENCE ON LOT
1 OF CERTIFIED SURVEY MAP
NO. 2829.

ORDERED BY: PREFERRED HOMES
BILL BOHN, GRI
2903 BORG ROAD
DELAVER, WI. 53115

DETAIL OF LOT 1 WITH EXISTING RESIDENCE

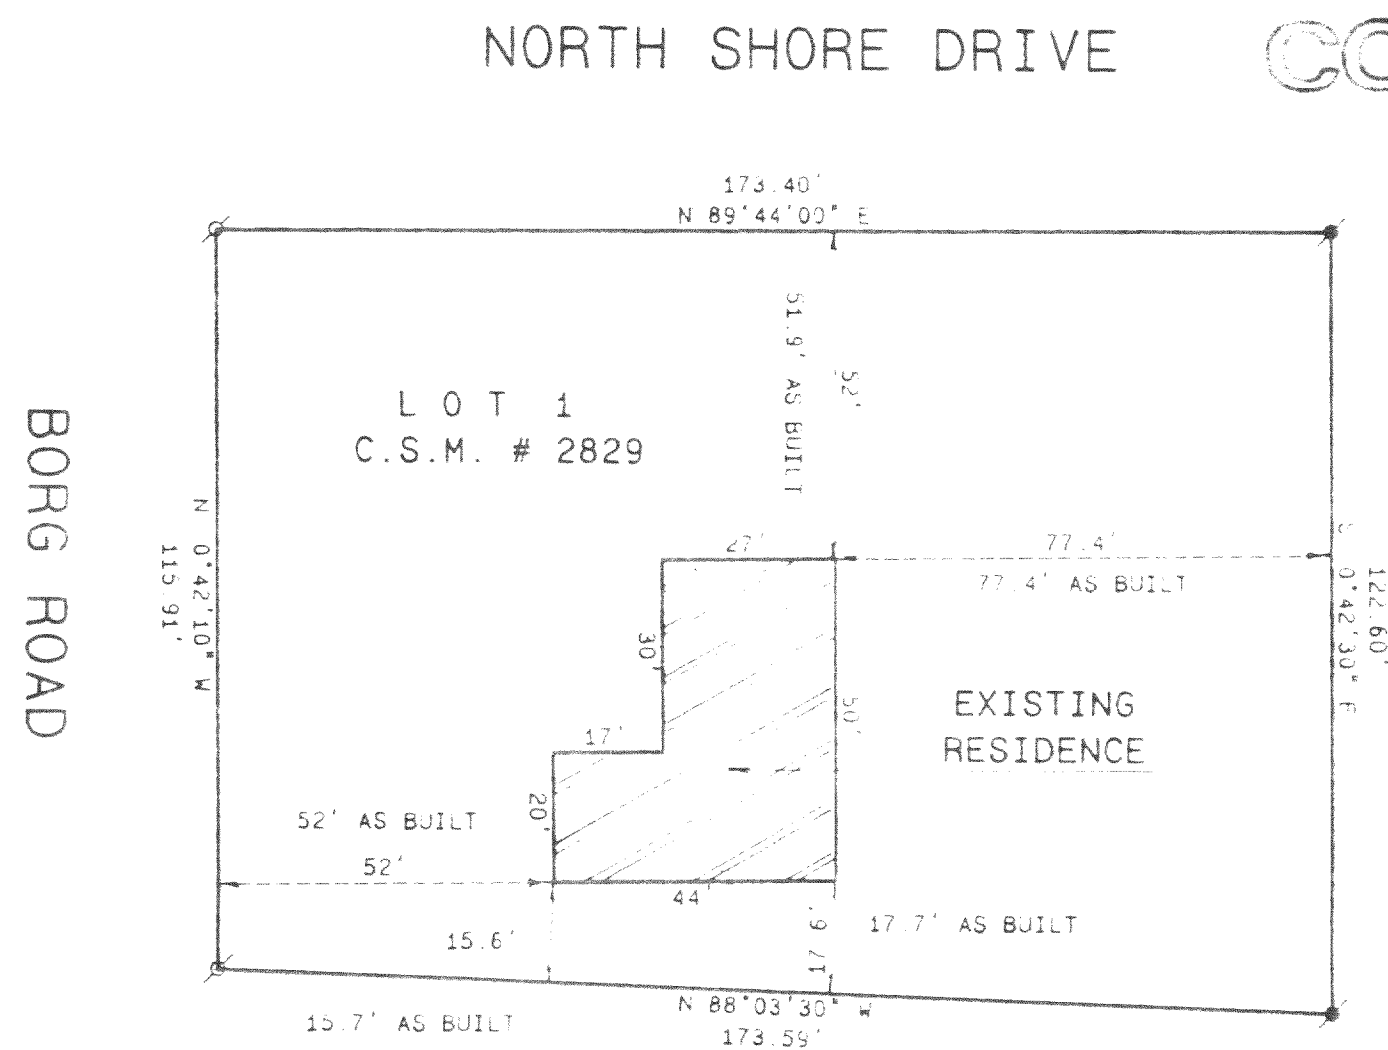


SCALE 1" = 30 FEET

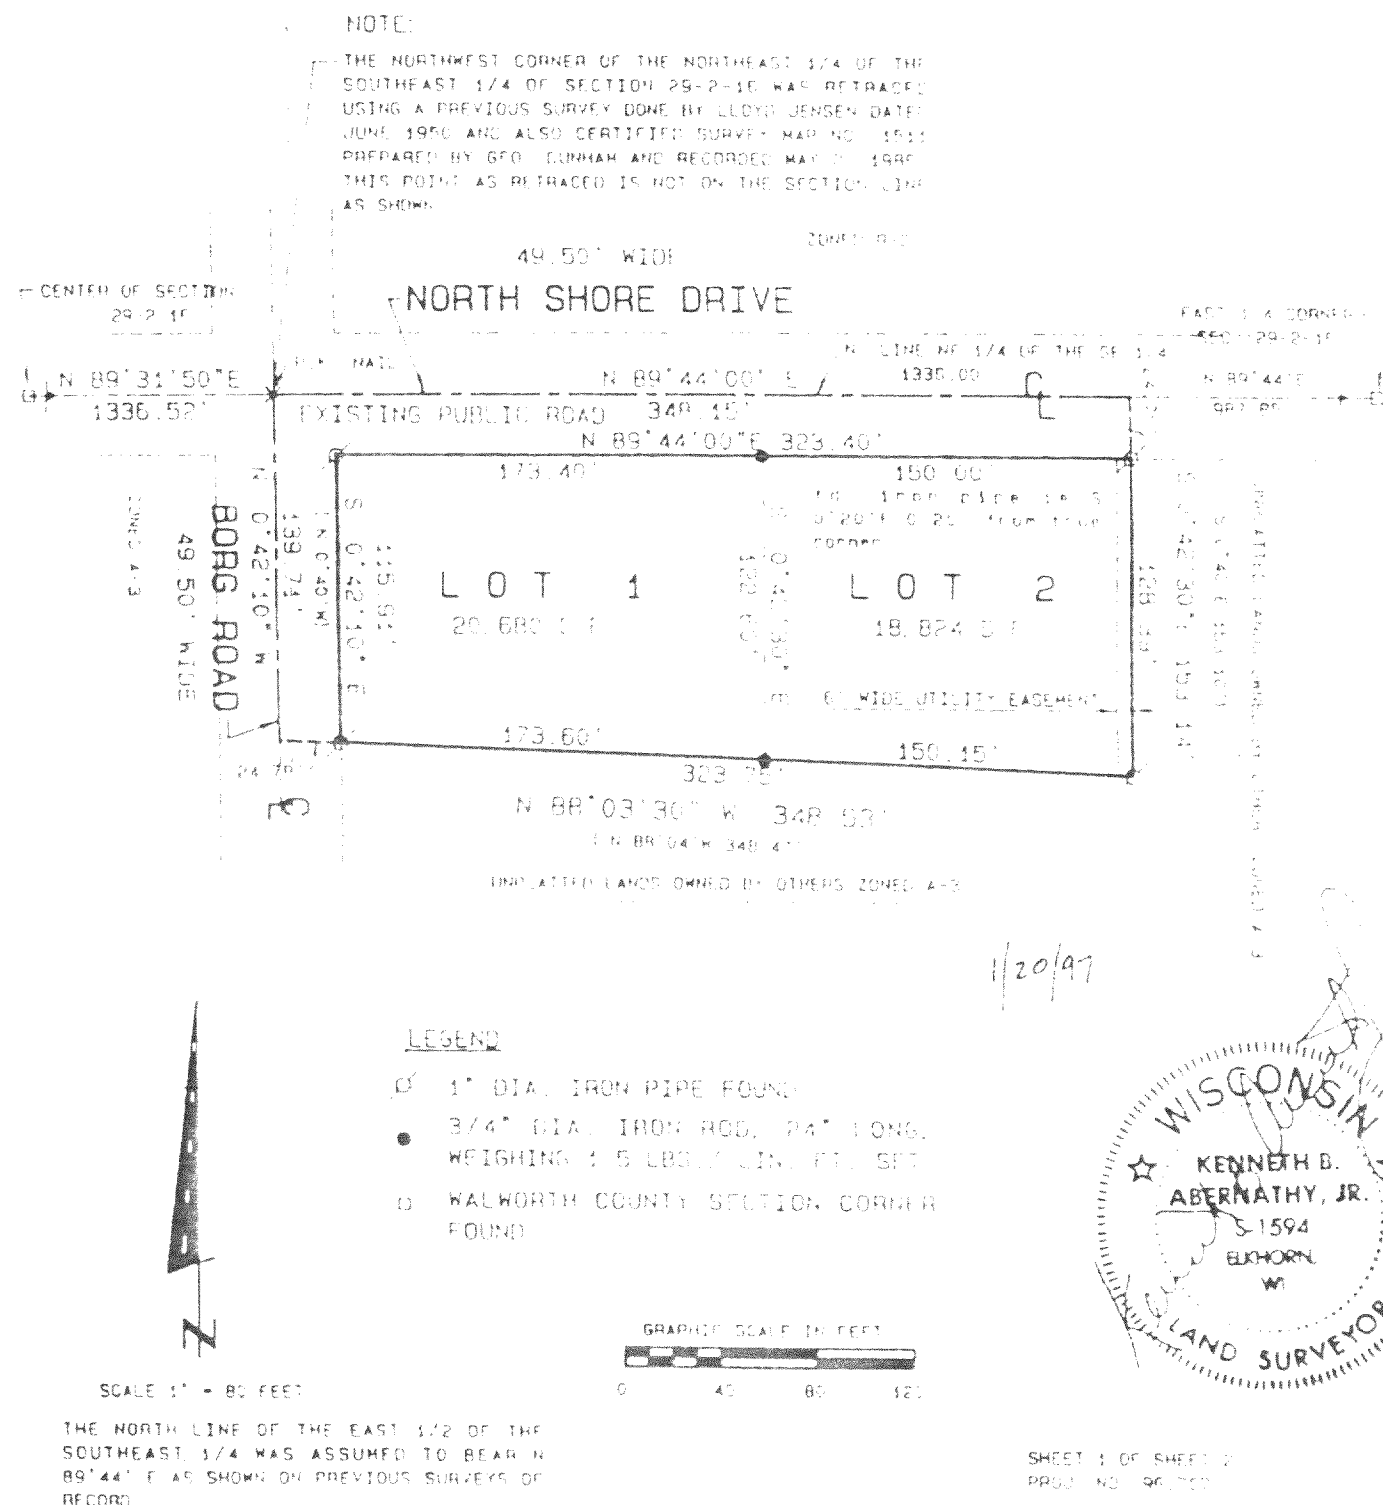

C.S. #2829

REVISED FOR "AS BUILT LOCATION"

VOLUME 14 PAGE 29

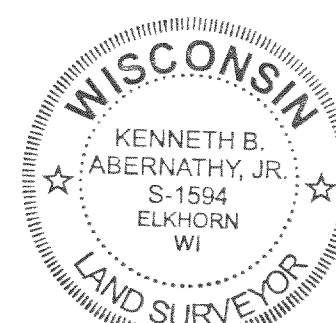

Kenneth B. Abernathy, Jr.
WISCONSIN REGISTERED LAND SURVEYOR
S-1594
Date: 7/2/99 Job No. 216-2739

FA-2829-1
FA-2829-2

216-2739