


Plat of Survey


of
Lots 145 through 150 of Krumhaar's 2nd
Addition to Ravenswood, a subdivision located in
the Southeast 1/4 of Section 31, Town 2 North, Range 16 East,
Town of Delavan, Walworth County, Wisconsin.

Surveyed for: **Don & Joyce Deichsel**
4021 Cardinal Lane
Delavan, Wisconsin. 53115

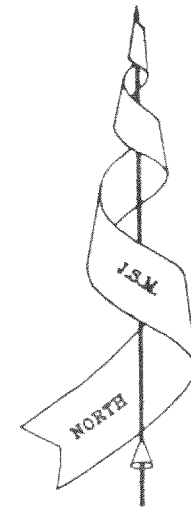

Bearings referenced to
Certified Survey Map
No. 2151.

**Ravenswood
Drive** (20' wide)

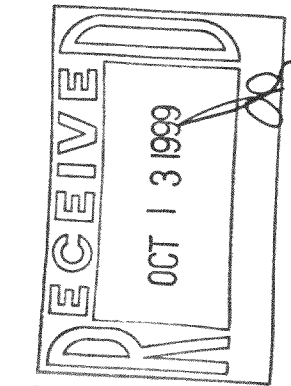

Cardinal Lane (20' Wide)

Lot 145

House
4021

Lot 146

Lot 147

Lot 148


Lot 149

Lot 150

Lot 151

Temporary Wood
Storage Shed

"Bay Road"
Outlot 1
C.S.M. 2151 (60' Wide)

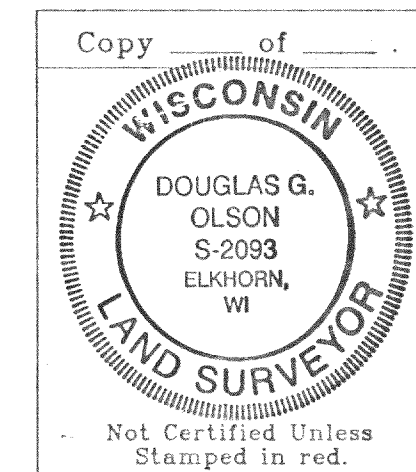

Note: This survey plat is not
certified unless signed
and sealed in red ink.

Note: This survey is subject to Wisconsin lien laws.
This Plat of Survey is the notice of intent
to file lien. Lien waiver required.

Copyright © 1999 by Jensen & Olson Land Surveying, LLC

All rights reserved. No part of this survey plat may be reproduced
or transmitted in any form by any means - graphic, electronic, or
mechanical, including photocopying, tracing, or information storage
and retrieval systems - without permission in writing from Douglas G.
Olson, Jensen & Olson Land Surveying, LLC.

I, Douglas G. Olson, Wisconsin Registered Land Surveyor, do
hereby certify that this survey was performed by me, or under my
direction in full compliance with the owner's / agent's instructions
and Chapter A-E 7 of the Wisconsin Administrative Code "Minimum
Standards for Property Surveys", and that this map is as accurate
representation thereof to the best of my knowledge and belief.

Date: 9-10-99


Douglas G. Olson

R.L.S. 2093

Mapping date: Sept. 10, 1999.

Revisions:

Scale in Feet

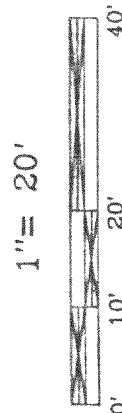

Jensen & Olson Land Surveying, LLC

45 South Wisconsin Street P.O. Box 322

Elkhorn, Wisconsin. 53121

Telephone: (414) 723-3434

Facsimile: (414) 723-8044

Legend

- Found Concrete Monument
- Found Iron Pipe
- Found Iron Rod
- Set Iron Rod
- Recorded Information
- Utility Pole - Asphalt Surface
- Concrete Surface

Sheet 1 of 1 Sheets

Job Reference Number

1999.056

1999.056

216-2802

FRA2-38
FRA2-39
FRA2-40