



Flat of Survey

WEERTS


Description: LOT 13 SUMMIT MEADOWS, lands located in part of all 1/4's of the N.W. 1/4 Section 31, Town 2 North, Range 16 East, Walworth County, Wisconsin.

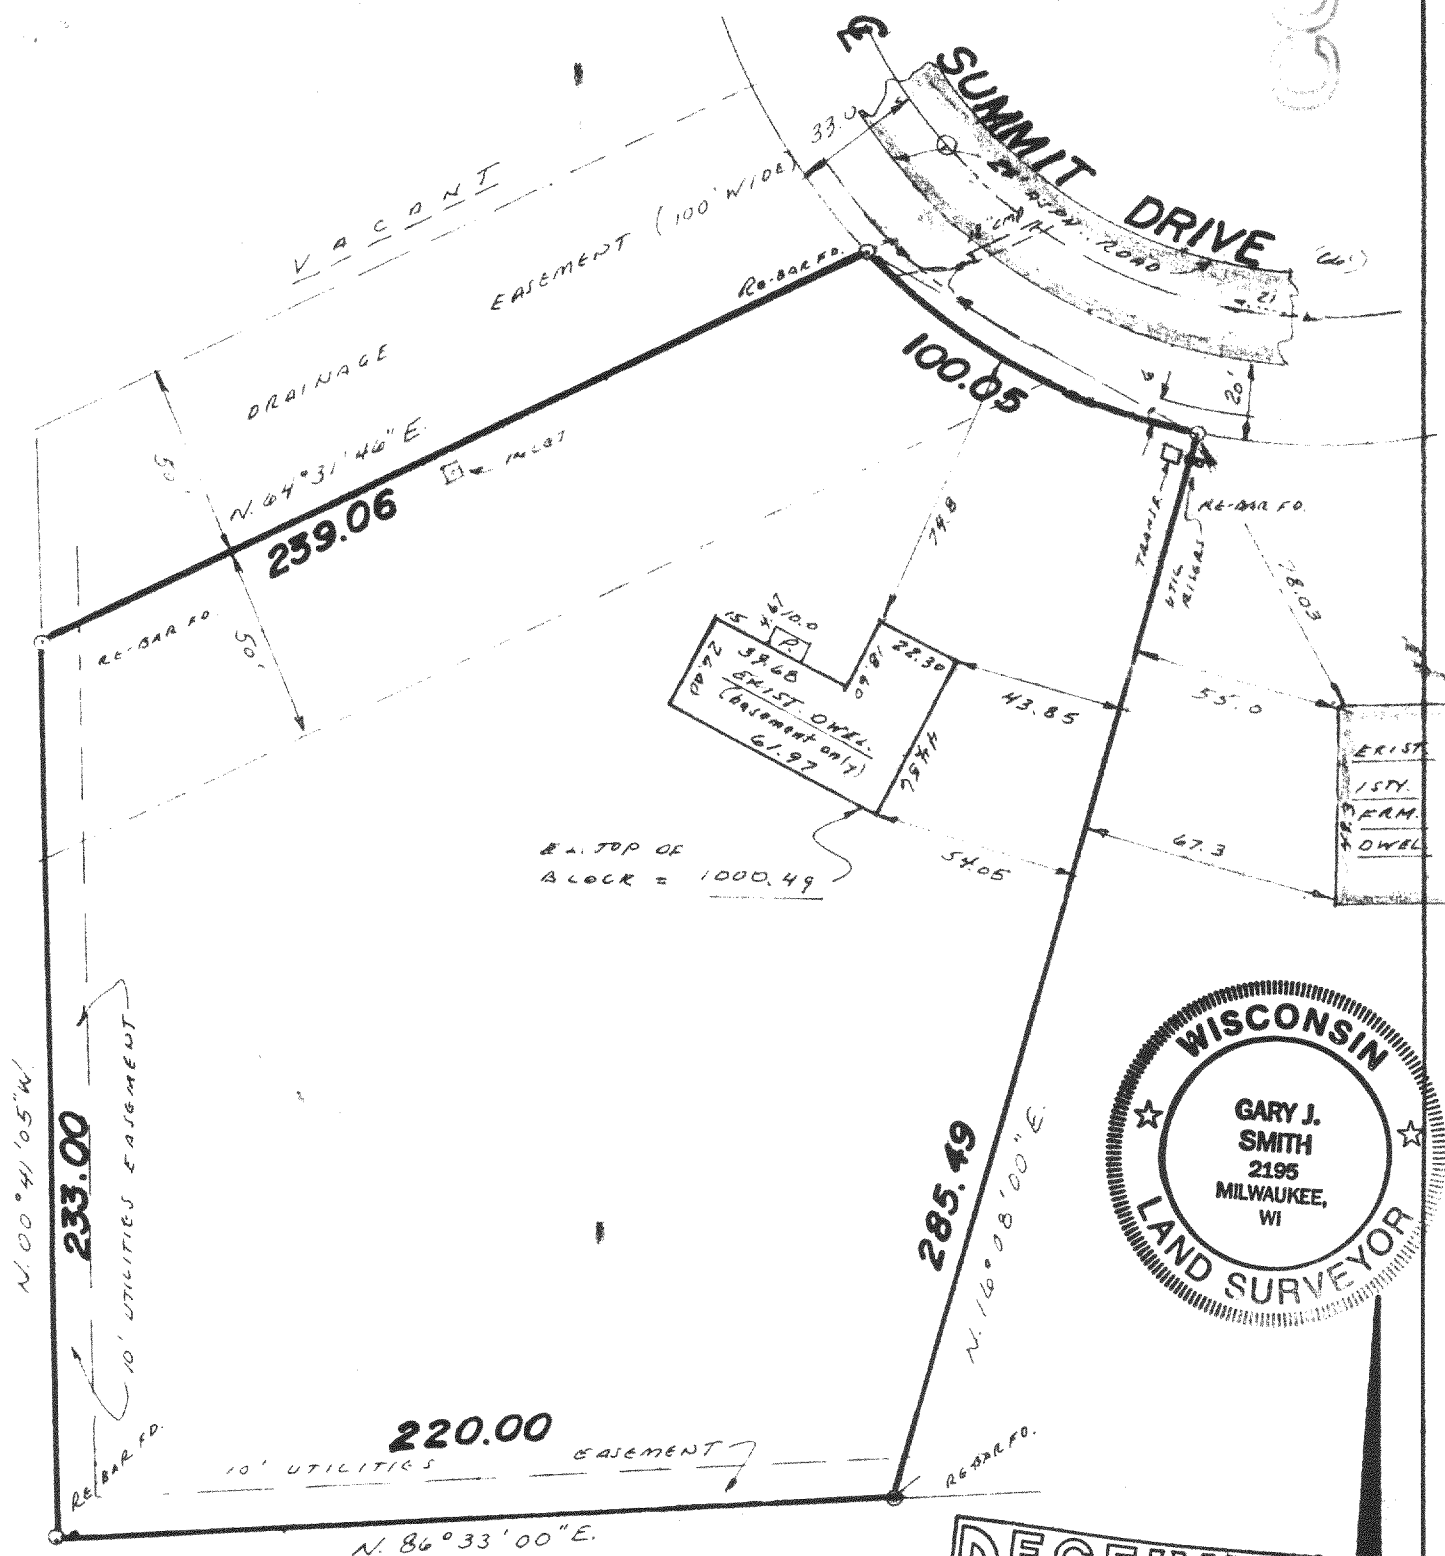

R4D. = 166.0
CHD. = 98.54
 $\Delta = 34^{\circ}31'58''$
BRG. = N. 60°39'04"W.
M.O. = 748

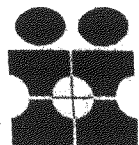

11221 W. FOREST HOME AVE.
FRANKLIN, WISCONSIN 53132
PHONE 425-2060

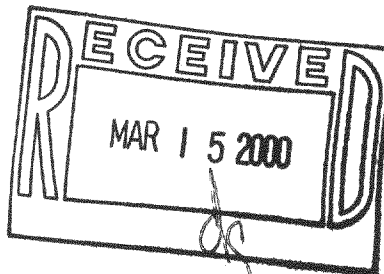

Scale: $\frac{1}{2}$ " = 50

SURVEY CERTIFICATE

This survey is made for the exclusive use of the present owners of the Property, and also those who purchase, mortgage, or guarantee the title thereto, within one (1) year from date hereof.

Date: 7/19/99
Job No.. 27044

N544031

ESIM-13