


STATE OF WISCONSIN
COUNTY OF RACINE

I HEREBY CERTIFY THAT I HAVE SURVEYED THE ABOVE DESCRIBED PROPERTY AND THE ABOVE
MAP IS A TRUE REPRESENTATION THEREOF AND SHOWS THE SIZE AND LOCATION OF THE
PROPERTY, ITS EXISTING BOUNDARIES, THE LOCATION OF ALL VISIBLE STRUCTURE AND
DIMENSIONS OF ALL PRINCIPAL BUILDINGS THEREON, BOUNDARY LINES, APPARENT
EASEMENTS, ROADWAYS AND VISIBLE ENCROACHMENTS, IF ANY.

THIS SURVEY IS MADE FOR THE PRESENT OWNERS OF THE PROPERTY, AND ALSO THOSE WHO
PURCHASED, MORTGAGED, OR GUARANTEED THE TITLE THEREOF WITHIN ONE (1) YEAR FROM THE
DATE THEREOF.

DATED AT NORTH CAPE, WISCONSIN, THIS 03RD DAY OF OCTOBER, 1999.



AMERICAN SURVEYING COMPANY, INC.
PETE L. BAILEY, RLS NO. 1398
RECEIVED this 10TH day of DECEMBER, 1999.

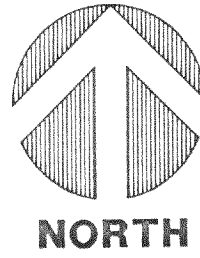


SCALE
0 30 60
FEET

LEGAL DESCRIPTION:

LOT 2 OF CERTIFIED SURVEY MAP NO. 2918, BEING A PART OF THE NORTHEAST 1/4 OF
THE NORTHEAST 1/4 OF SECTION 24, TOWN 2 NORTH, RANGE 16 EAST OF THE FOURTH
PRINCIPAL MERIDIAN, IN THE TOWN OF DELEVAN COUNTY OF WALWORTH, STATE OF
WISCONSIN.

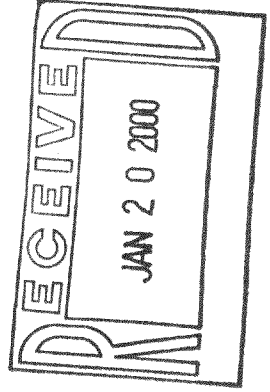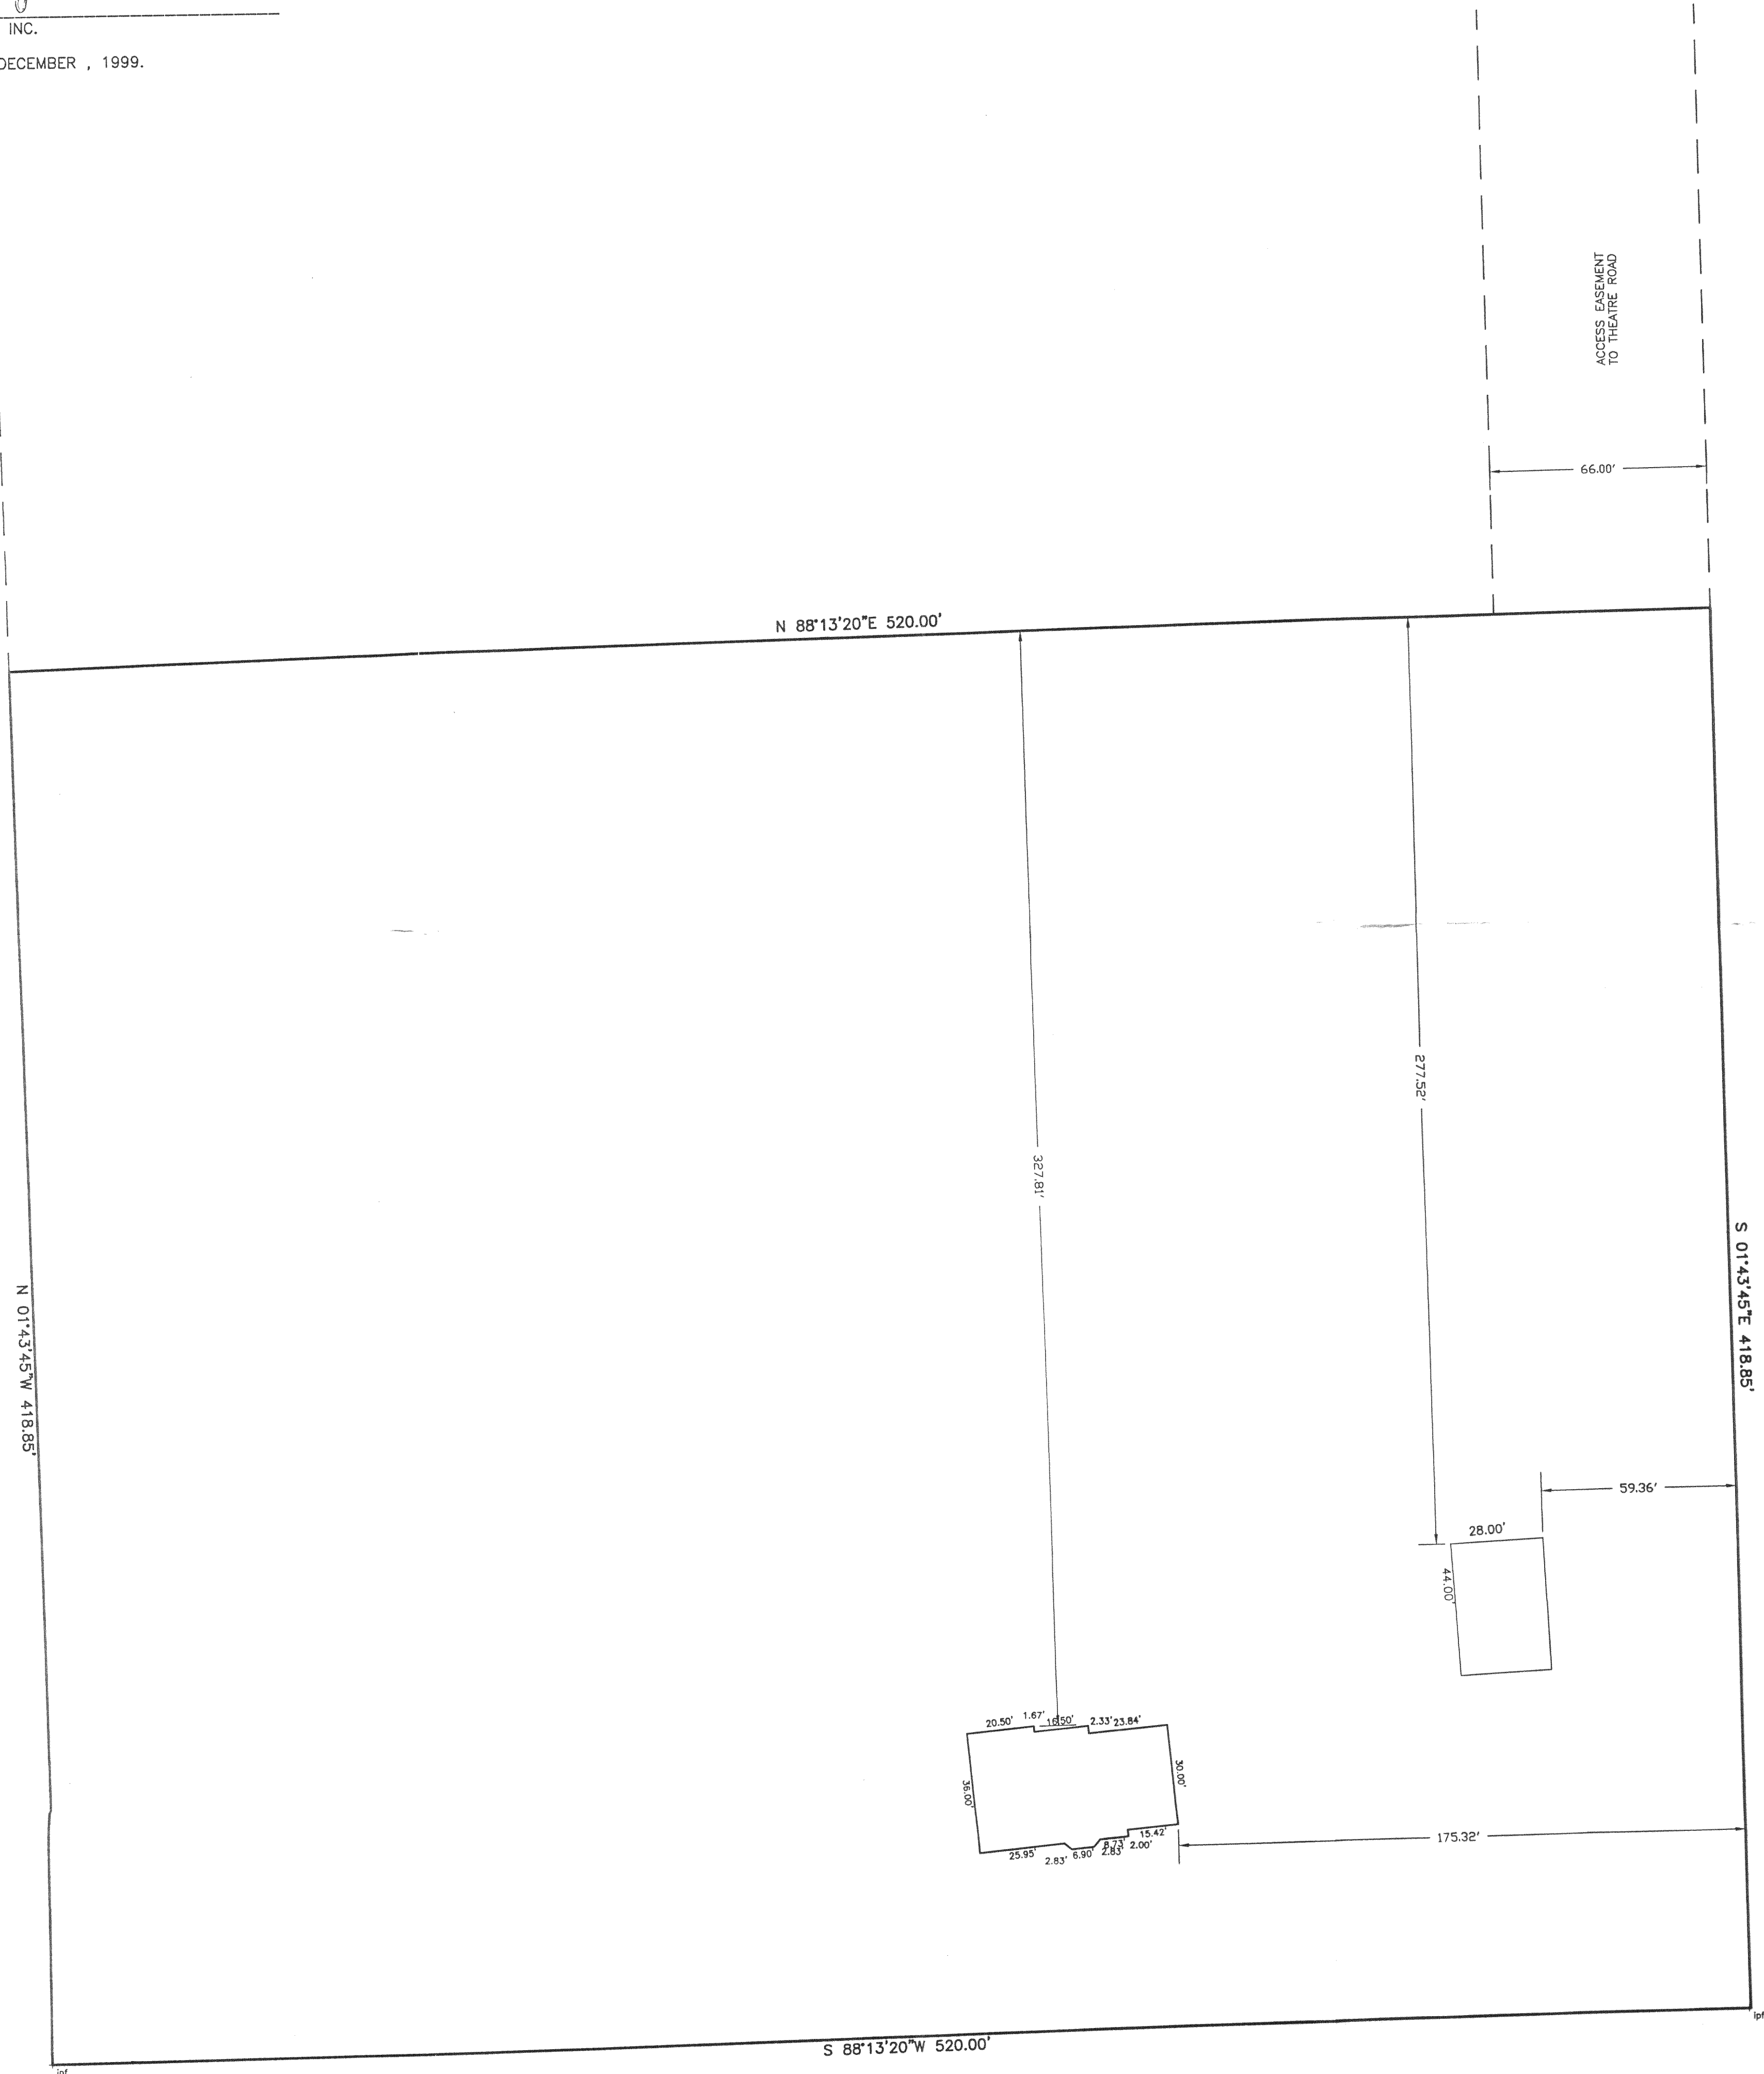

AMERICAN
SURVEYING
COMPANY, INC.

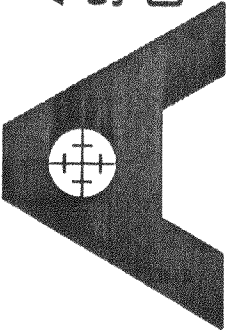

12207 C.T.H. "K" FRANKSVILLE, WISCONSIN 53126
TEL. (414) 835-4774 FAX: (414) 835-2379

DRAWN BY:	PLB	REVISIONS:	DATE
CHECKED BY:	PLB		
PLOT SCALE:	1 = 30		
DATE:	10/03/99		
JOB NO.:	99.073		
DWG. FILE:	JN99263A		

TOWN OF DELEVAN

PROJECT:
PLAT OF SURVEY/STAKE OUT SURVEY

PREPARED FOR: BADGER HOME BUILDERS, INC.
OWNERS: JOSEPH AND MARY LEE

Sheet
1
of
1