


GEORGE T. DUNHAM
SURVEYING & SUBDIVIDING
DELAVER, WISCONSIN

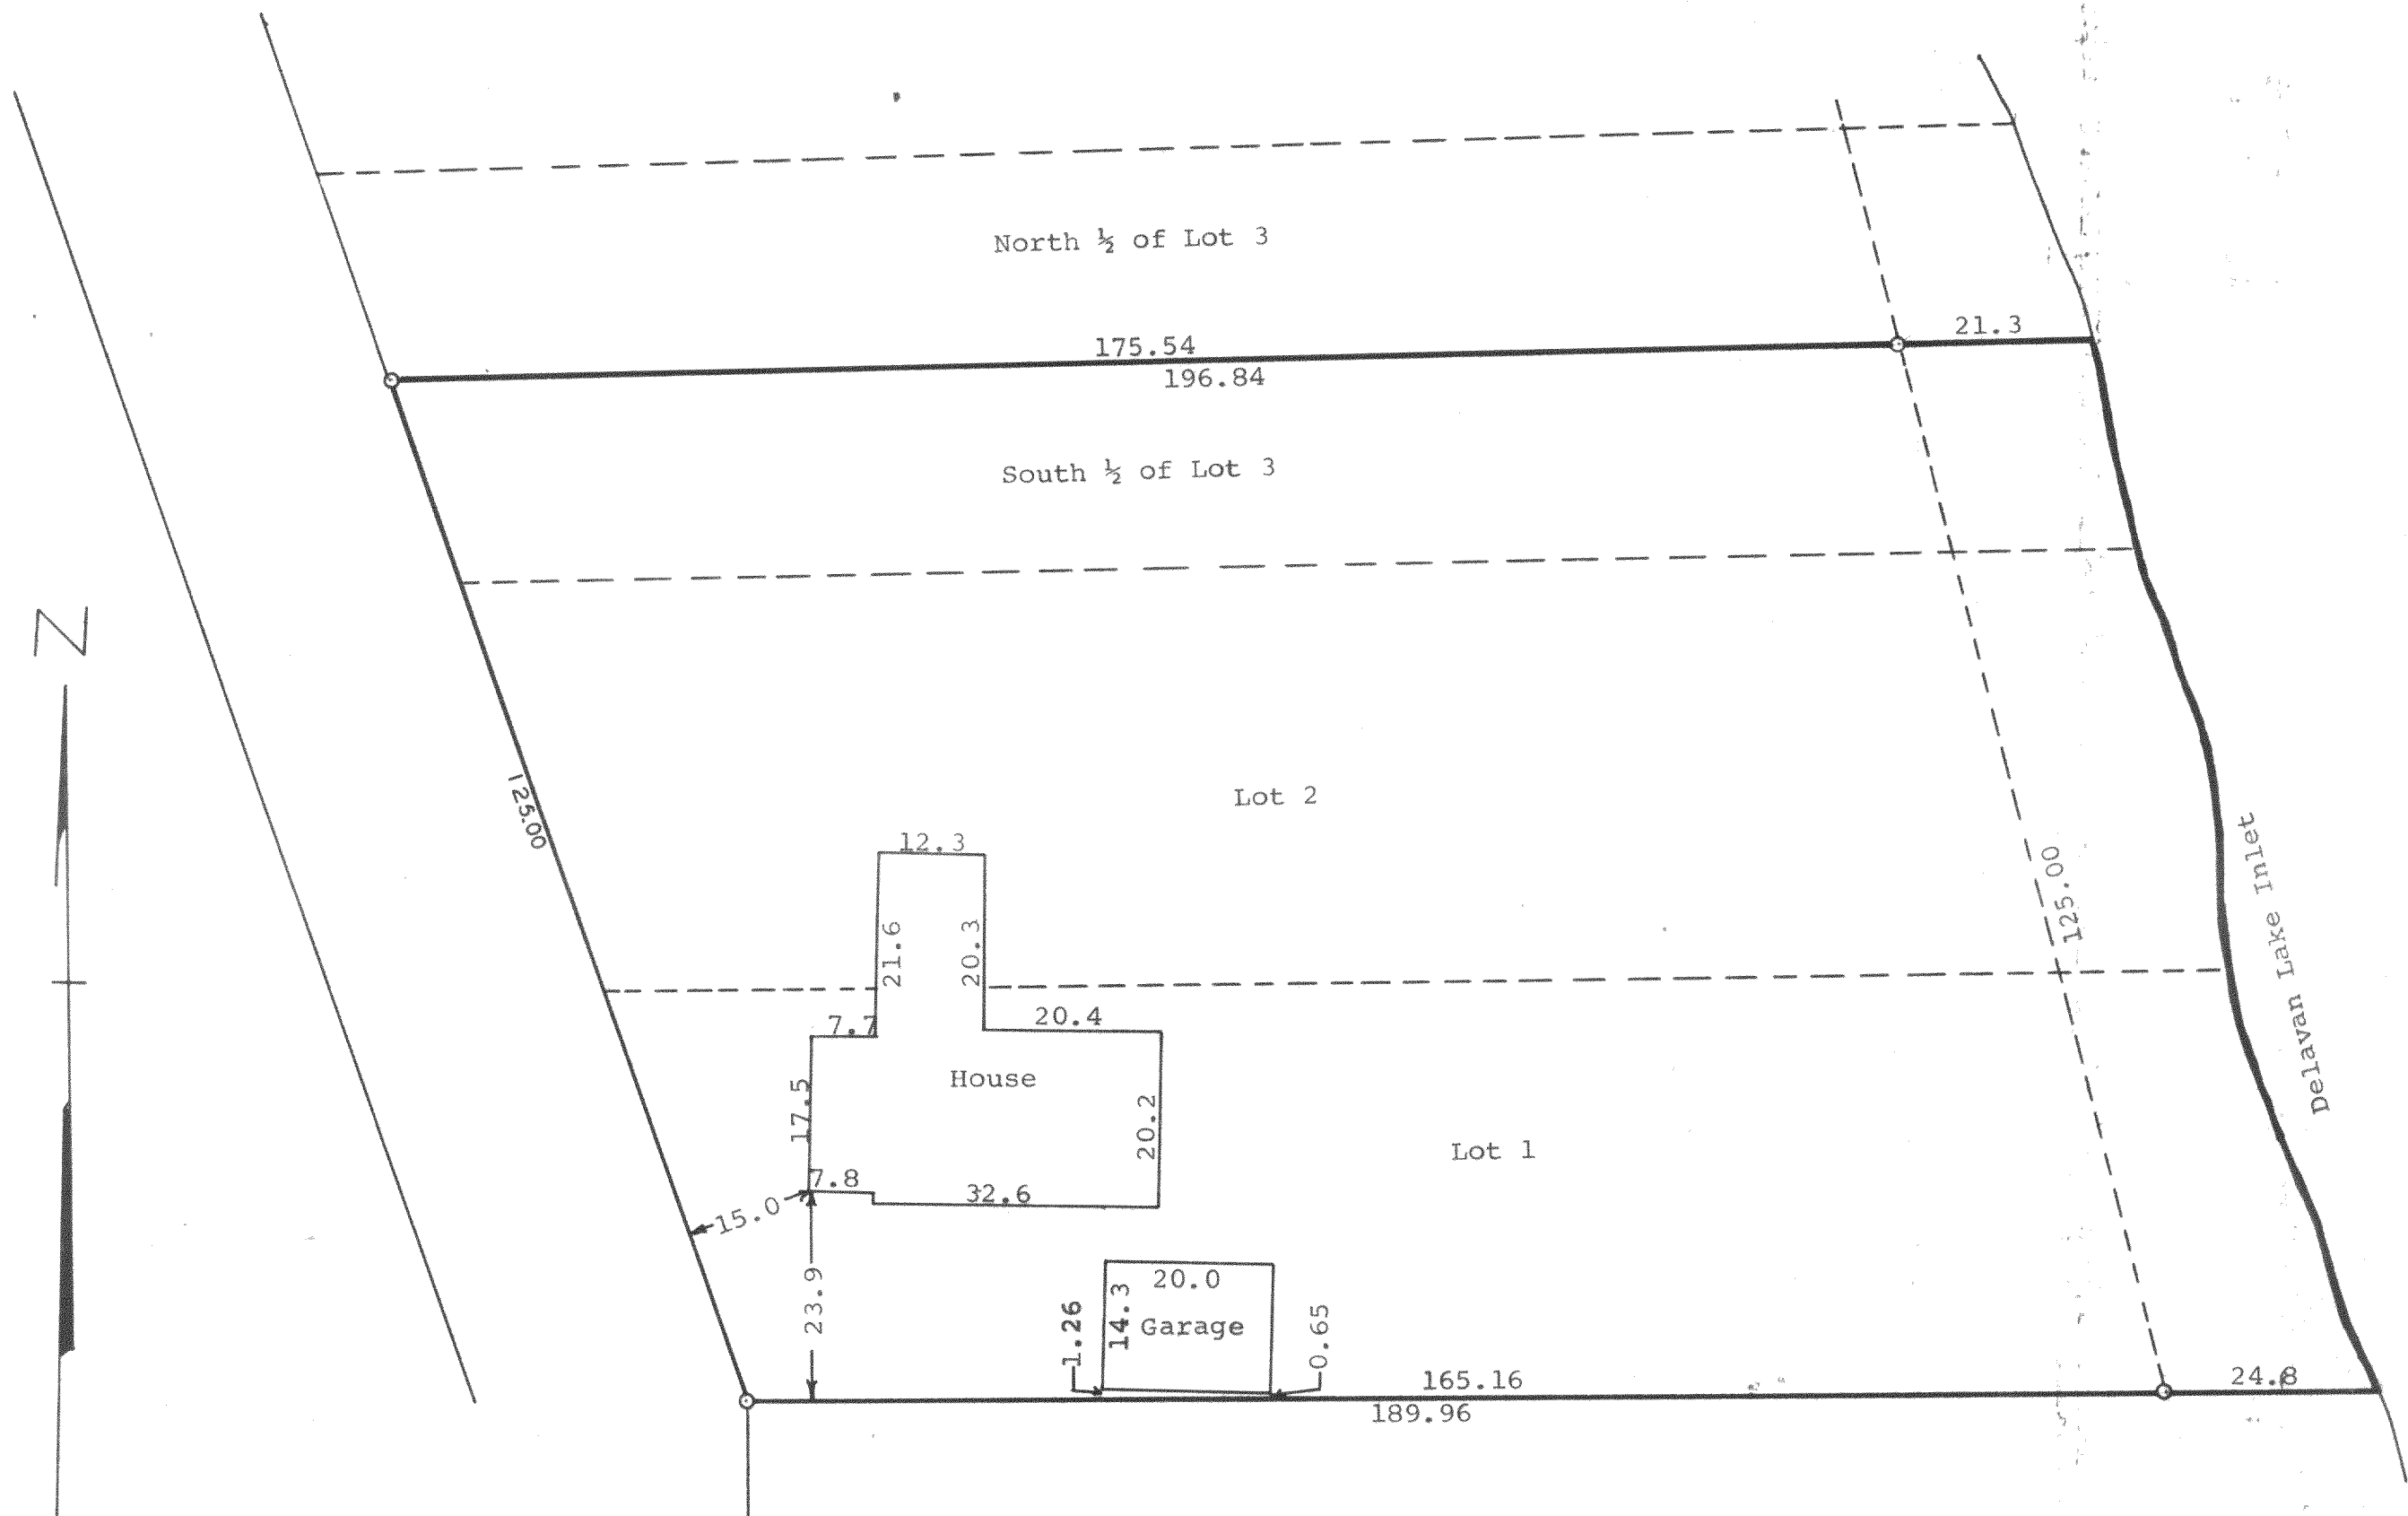

Plat of survey of Lots 1, 2, and the South 1/2 of Lot 3 in the
Annex to Inlet Oaks, Town of Delavan, Walworth County, Wisconsin.
July 26, 1968

George T. Dunham
George T. Dunham, Surveyor

216-285

F 1A-1
VL 2A