


GEORGE T. DUNHAM
SURVEYING & SUBDIVIDING
DELAVAN, WISCONSIN

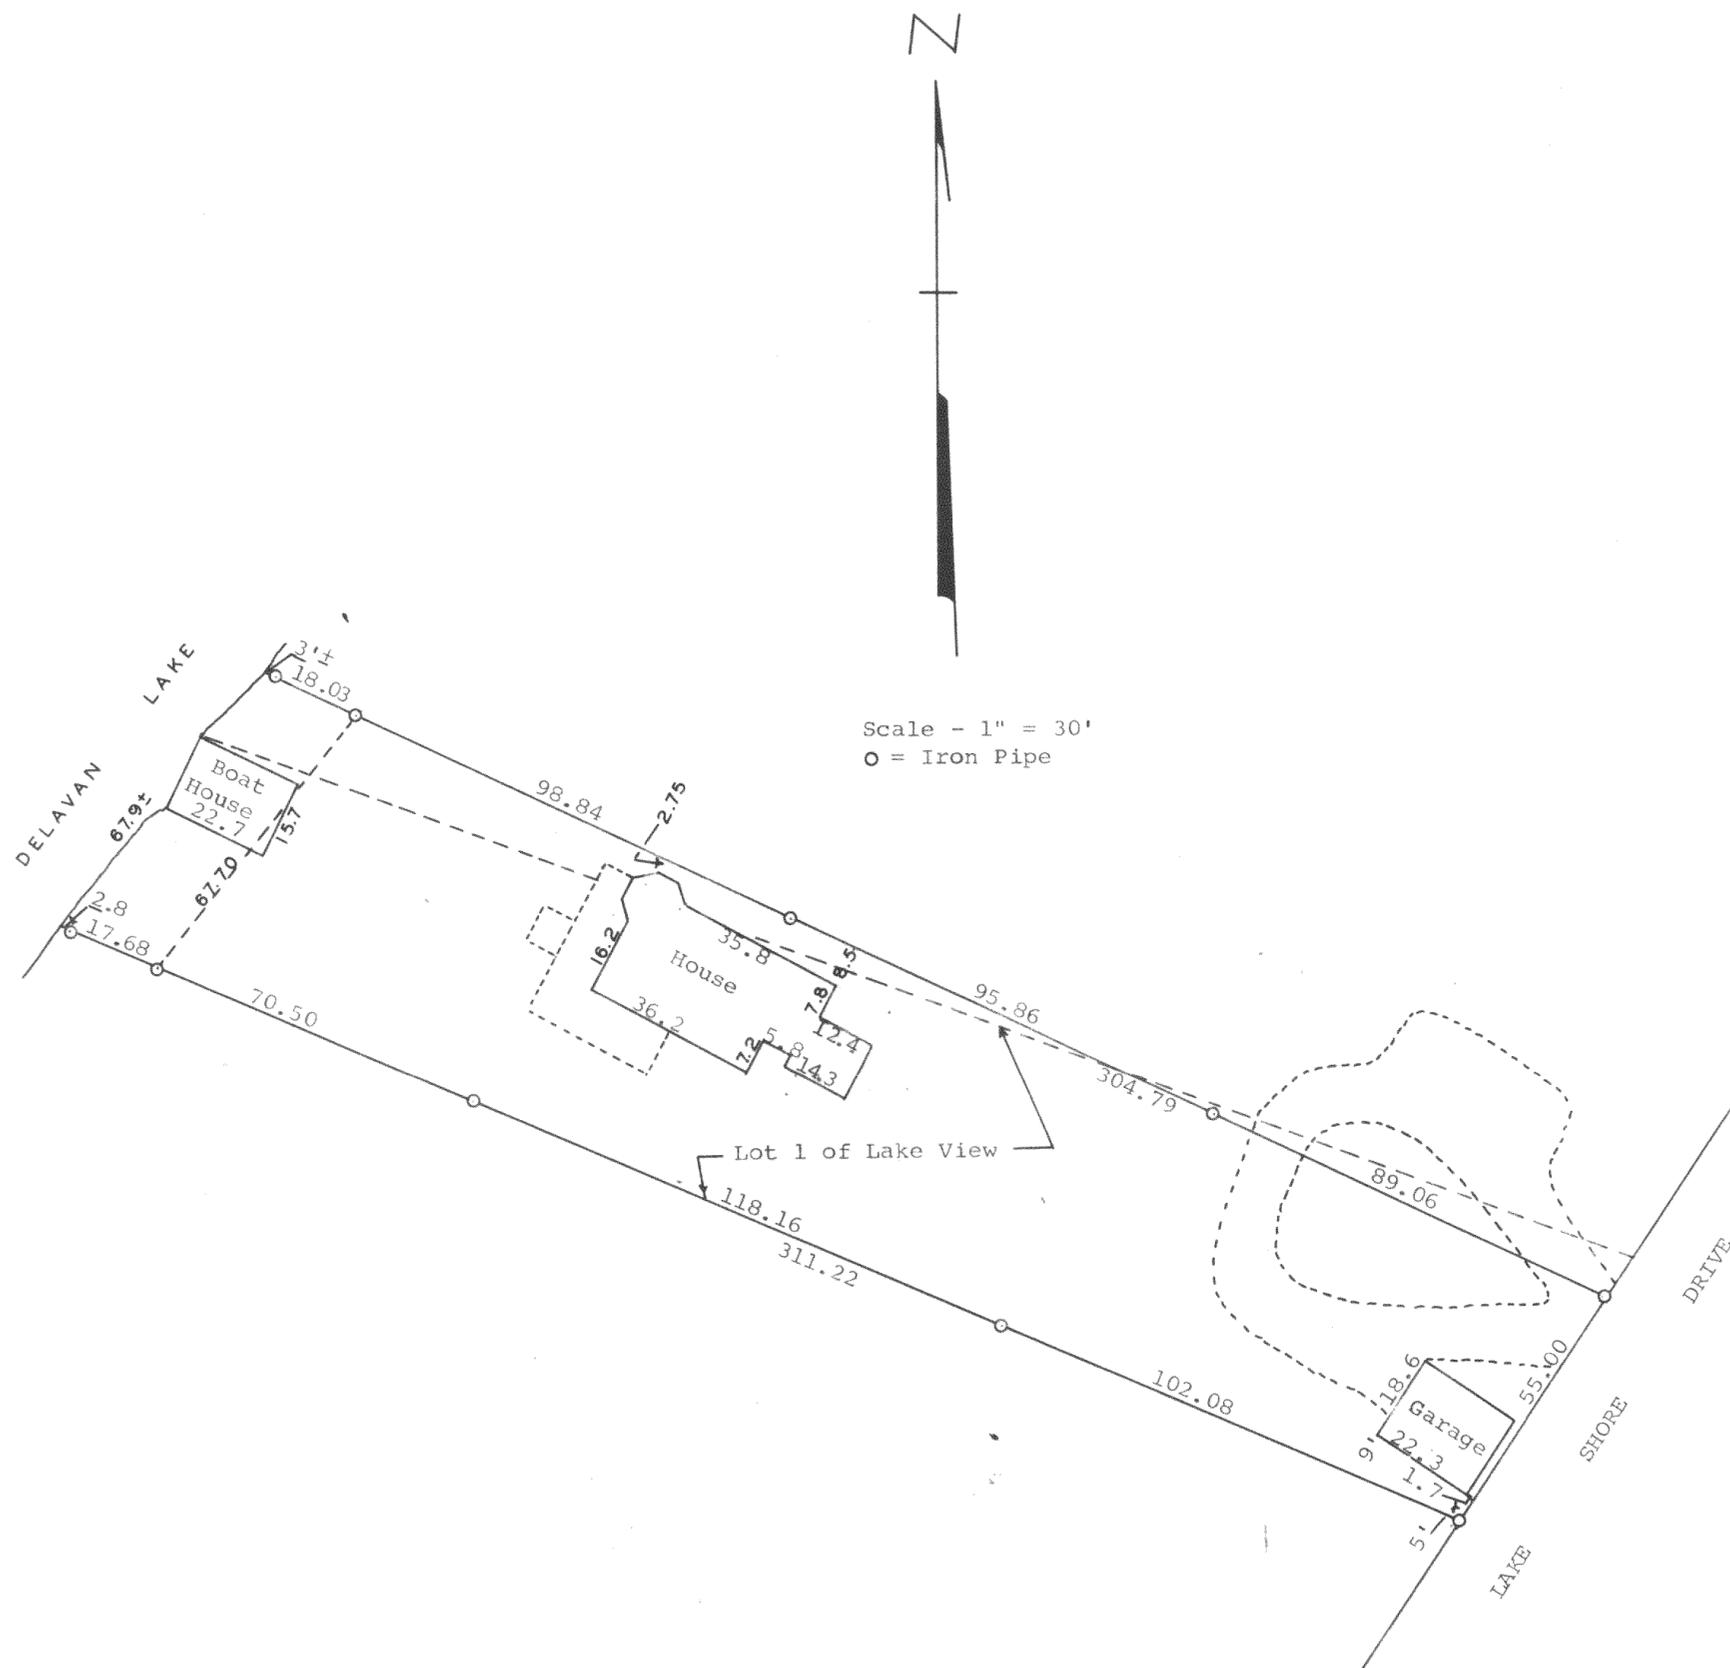

Plat of survey of the Cassius MacDiarmid Property located in part of Lot 1 of Lake View and of a parcel of land adjoining said lot in Section 27, T 2 N, R 16 E, Walworth County, Wisconsin.
March 7, 1969

George T. Dunham
George T. Dunham, Surveyor

216-286

PLAT 1