



PLAT OF SURVEY

DATE: 4-7-2000

PATHFINDER SURVEYING
FORMERLY KOLB LAND CONSULTING
929 WILLIAMS STREET LAKE GENEVA, WI. 53147
(262) 248-3697

ORDERED BY: JAMES JESK
110 DEER HAVEN CT,
CRETE, IL 60417

DESCRIPTION: LOT 11, THE ANNEX TO THE INLET OAKS, LOCATED
IN T2N, R16E, WALWORTH COUNTY, WISCONSIN.

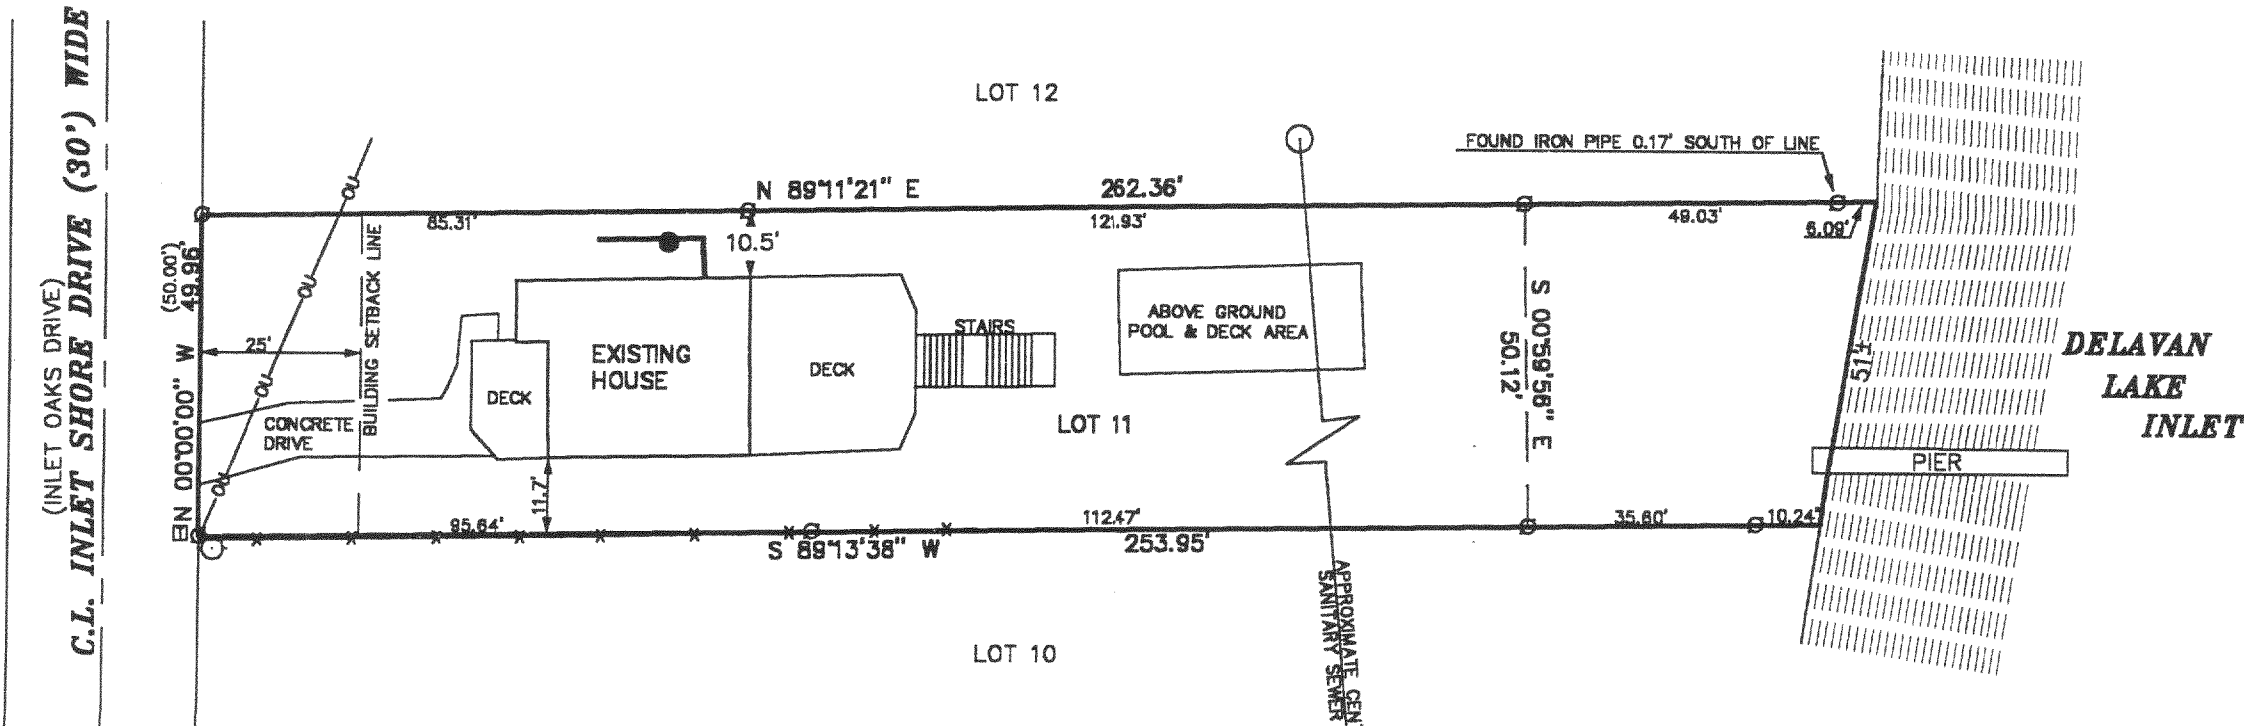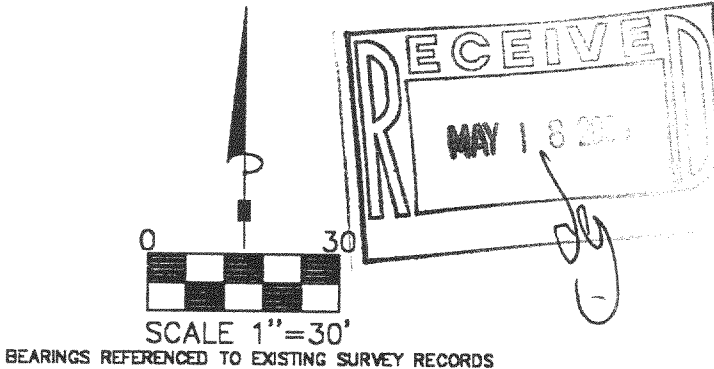


- LEGEND
- FOUND IRON PIPE
 - TELEPHONE PEDESTAL
 - MANHOLE
 - (XXXX) RECORDED AS
 - POWER POLE
 - ou— OVERHEAD UTILITY LINE
 - WELL
 - x— FENCE

THE ABOVE MAP IS A TRUE REPRESENTATION THEREOF AND
SHOWS THE SIZE AND LOCATION OF ALL THE PROPERTY,
EXTERIOR BOUNDARIES, THE LOCATION OF ALL VISIBLE
BOUNDARY FENCES, APPARENT EASEMENTS, ROADWAYS
AND VISIBLE ENCROACHMENTS, IF ANY

THIS SURVEY IS MADE FOR THE USE OF THE PRESENT
OWNERS OF THE PROPERTY, AND ALSO THOSE WHO
PURCHASE, MORTGAGE OR GUARANTEE TITLE THERETO
WITHIN ONE (1) YEAR FROM DATE HERETO.

John P. Krott
JOHN P. KROTT, R.L.S. 2258

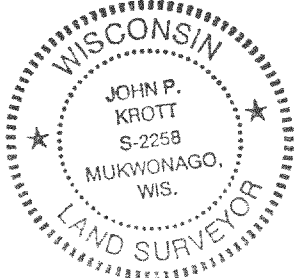

NOTE: THIS IS NOT A CERTIFIED COPY
UNLESS SEAL IS IN RED.
JOB NUMBER #00067 2-16-FIA 00010

216-2868

EN-10