

SITE GRADING, DRAINAGE & EROSION CONTROL PLAN

LOT 2 OF CERTIFIED SURVEY MAP NO. 3138
PART OF SECTION 33, TOWN 2 NORTH, RANGE 16 EAST
WALWORTH COUNTY, WISCONSIN

ASSUMPTIONS:

1. ALL EXISTING ELEVATIONS ARE BASED ON THE 1985 DATUM.
2. ALL ELEVATIONS ARE IN FEET.
3. ALL ELEVATIONS ARE MEAN SEA LEVEL.
4. ALL ELEVATIONS ARE MEAN SEA LEVEL.
5. ALL ELEVATIONS ARE MEAN SEA LEVEL.
6. ALL ELEVATIONS ARE MEAN SEA LEVEL.
7. ALL ELEVATIONS ARE MEAN SEA LEVEL.
8. ALL ELEVATIONS ARE MEAN SEA LEVEL.



AREA TO BE SURVEYED IS SHOWN ON THE ATTACHED MAP. THE AREA TO BE SURVEYED IS SHOWN ON THE ATTACHED MAP. THE AREA TO BE SURVEYED IS SHOWN ON THE ATTACHED MAP.

NO LARGE, PERMANENT, OBSTACLES ARE SHOWN ON THE ATTACHED MAP.

AREA TO BE SURVEYED IS SHOWN ON THE ATTACHED MAP. THE AREA TO BE SURVEYED IS SHOWN ON THE ATTACHED MAP. THE AREA TO BE SURVEYED IS SHOWN ON THE ATTACHED MAP.

NO LARGE, PERMANENT, OBSTACLES ARE SHOWN ON THE ATTACHED MAP.

AREA TO BE SURVEYED IS SHOWN ON THE ATTACHED MAP. THE AREA TO BE SURVEYED IS SHOWN ON THE ATTACHED MAP. THE AREA TO BE SURVEYED IS SHOWN ON THE ATTACHED MAP.

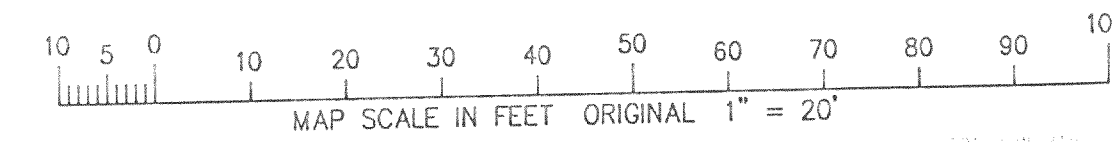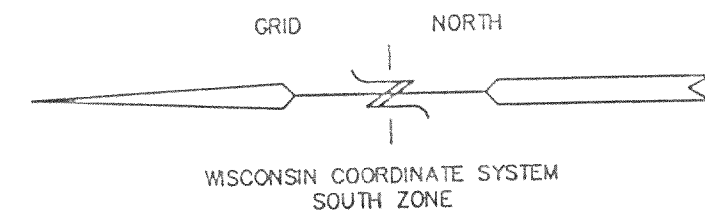

AS BUILT FOUNDATION
LOCATED 06-09-2000

AS BUILT FOUNDATION

SOUTH SHORE DRIVE


DELAVAN LAKE
LAKE ELEVATION = 927.9'

NOTE: COPIES OF THIS MAP TO WHICH THE FOLLOWING
CERTIFICATE WILL APPLY SHOW SURVEYOR'S ORIGINAL SEAL AND
SIGNATURE IN RED INK. COPIES BY ANY OTHER MEANS MAY HAVE
ALTERATIONS WHICH DO NOT REPRESENT THE SURVEYOR'S WORK
PRODUCT.

I HEREBY CERTIFY THAT THE ABOVE DESCRIBED PROPERTY HAS
BEEN SURVEYED UNDER MY DIRECTION AND THAT THE ABOVE MAP
IS A TRUE REPRESENTATION THEREOF AND SHOWS THE SIZE AND
LOCATION OF THE PROPERTY AND ITS EXTERIOR BOUNDARIES.
THIS SURVEY IS MADE FOR THE USE OF THE PRESENT OWNERS OF
THE PROPERTY, AND ALSO THOSE WHO PURCHASE, MORTGAGE, OR
GUARANTEE THE TITLE THERETO WITHIN ONE YEAR FROM THE DATE
HEREOF.

DATED: 6-12-2000

PETER S. GORDON R.L.S. 2101

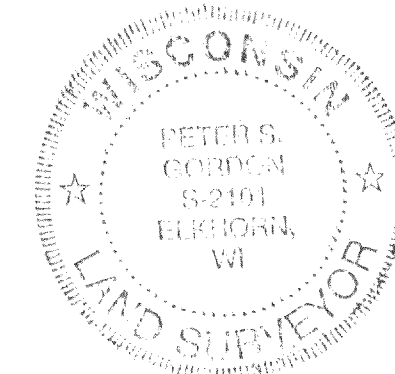

JUL 13 2000

PROJECT NO.
3507.2

DATE
10-14-99

SHEET NO.
1 OF 1

FARRIS, HANSEN & ASSOCIATES, INC.
ENGINEERING - ARCHITECTURE - SURVEYING
7 RIDGWAY COURT P.O. BOX 437
ELKHORN, WISCONSIN 53121
OFFICE: (262) 723-2098 FAX: (262) 723-5886

WORK ORDERED BY: KEITH ROT
P.O. BOX 298
NAPERVILLE, IL 60566



FA-3138-2

216-2876