



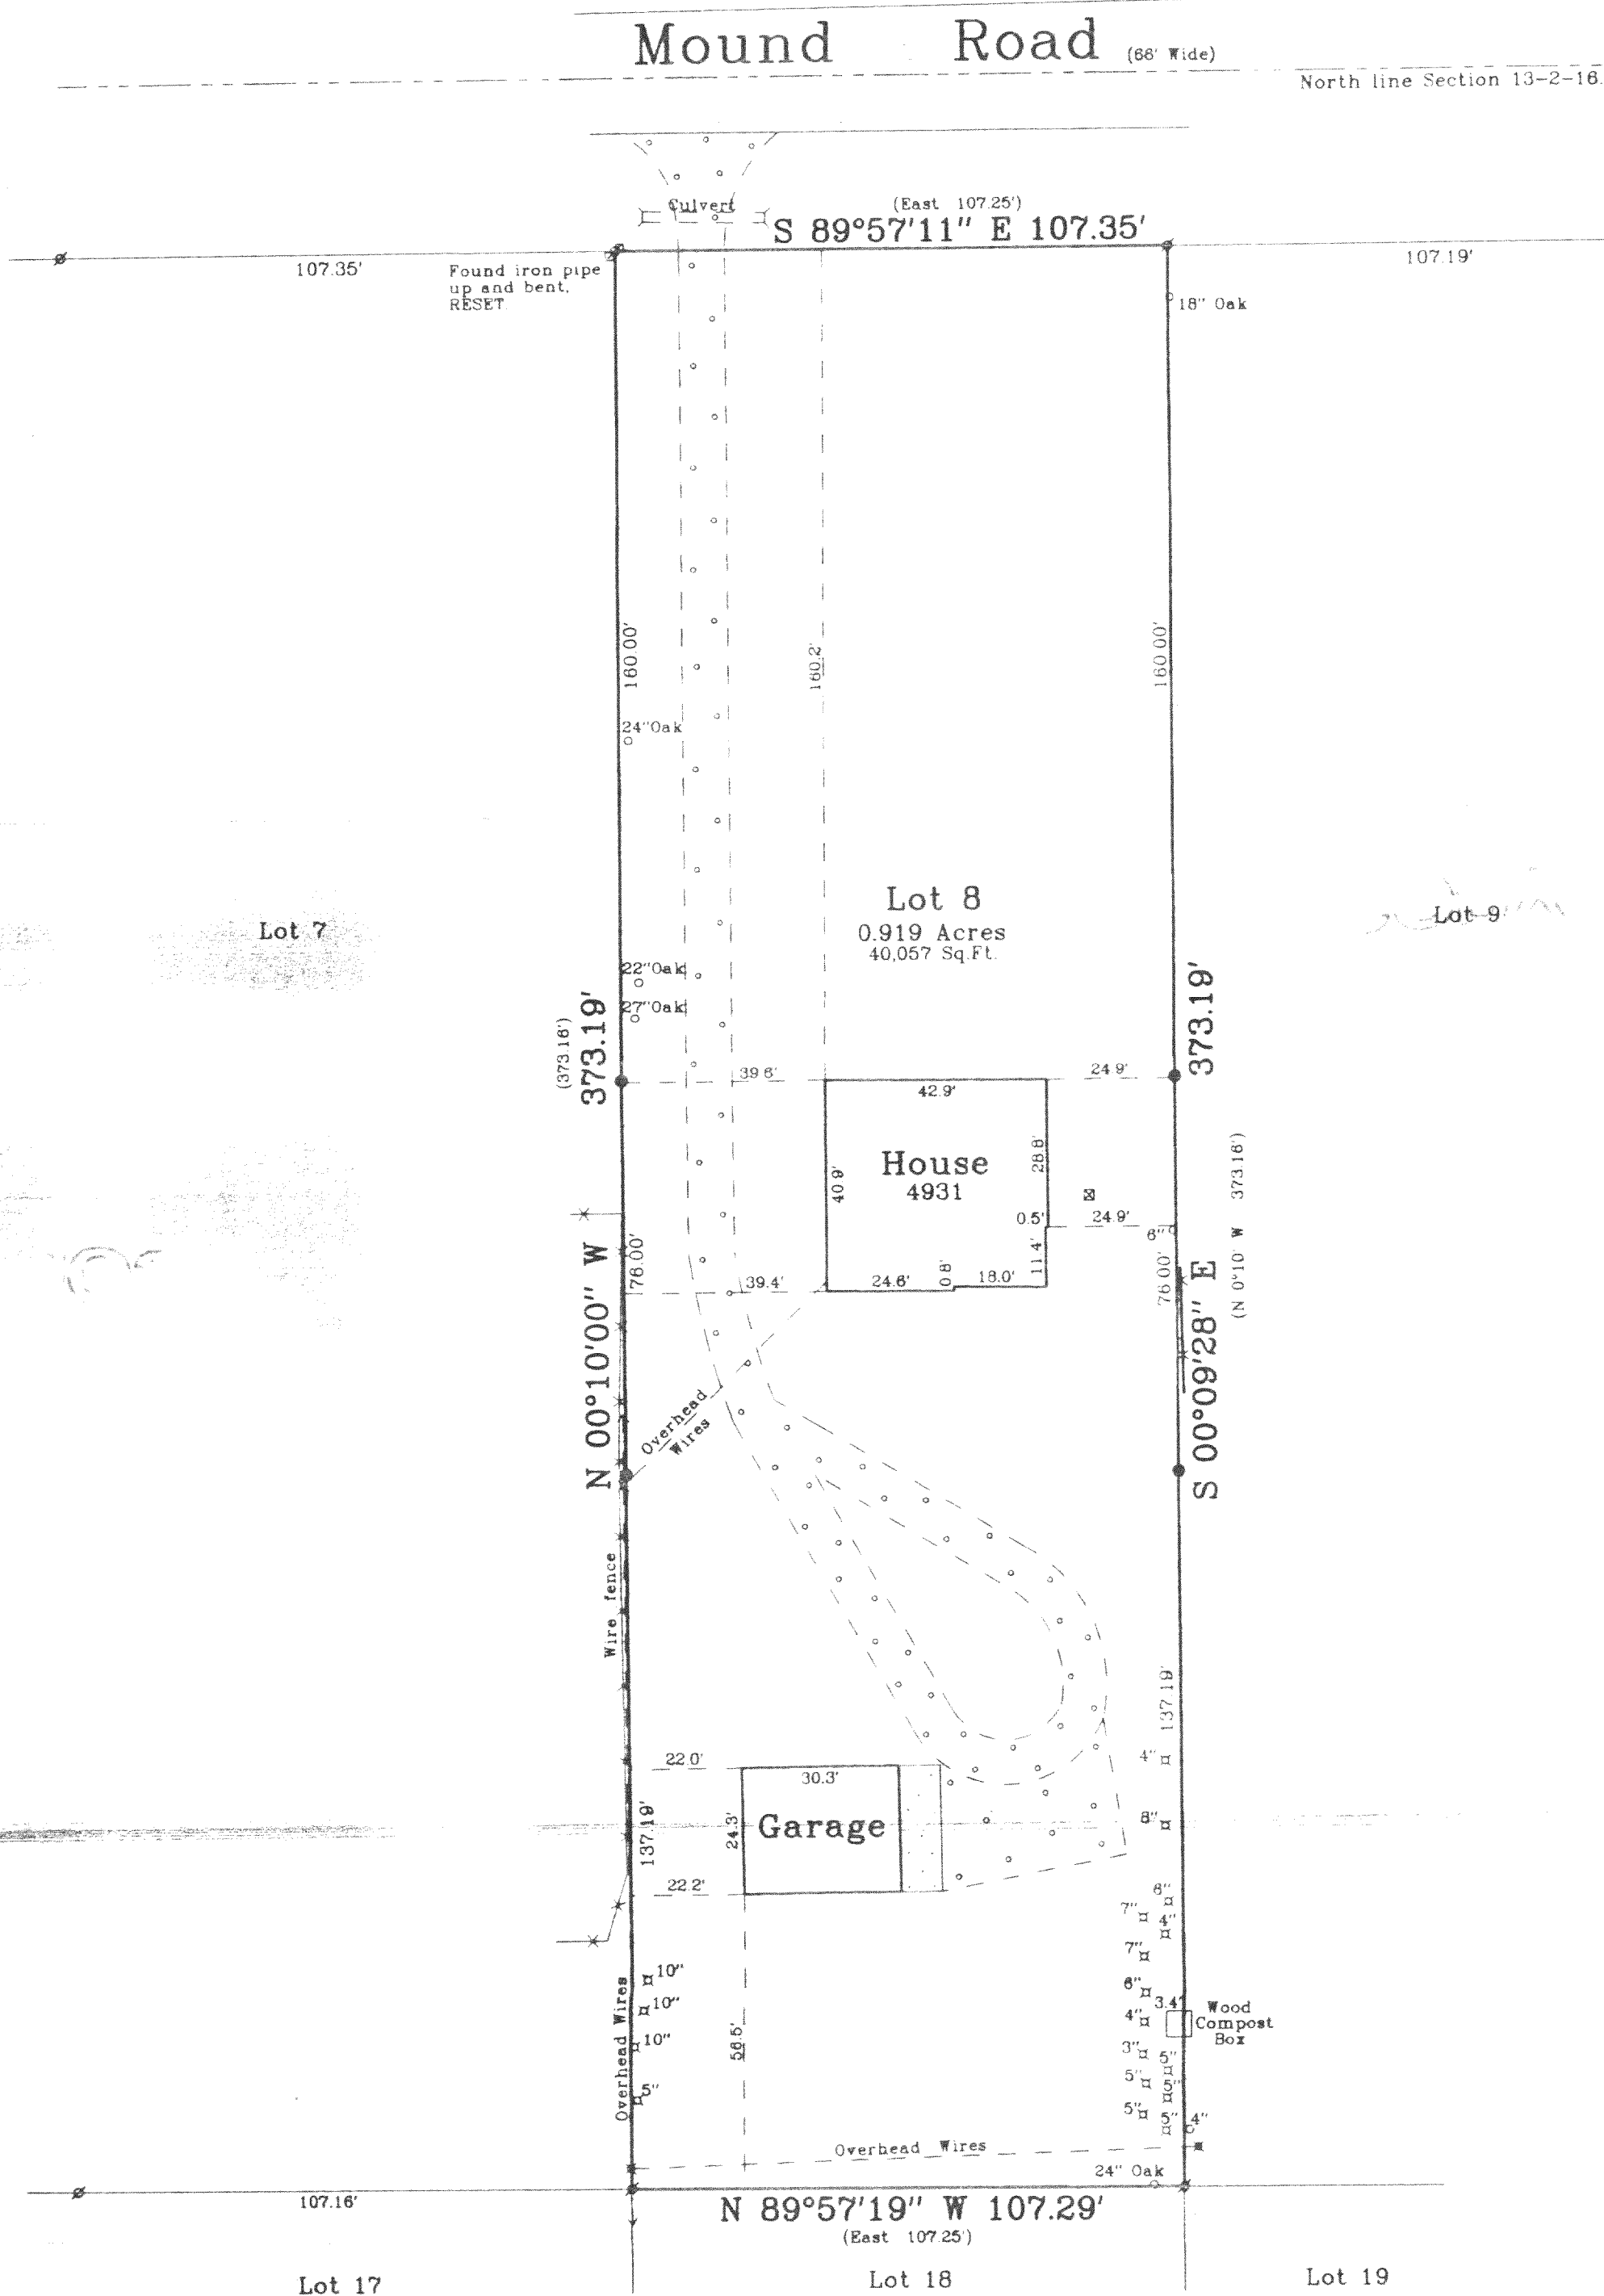

Plat of Survey

of
Lot 8 of Elkwood,
a subdivision located in the Northeast 1/4 of Section 13, Town 2 North,
Range 16 East, Town of Delavan, Walworth County, Wisconsin.

Surveyed for: **Robert Schnitzler**
4931 Mound Road
Elkhorn, Wisconsin 53121

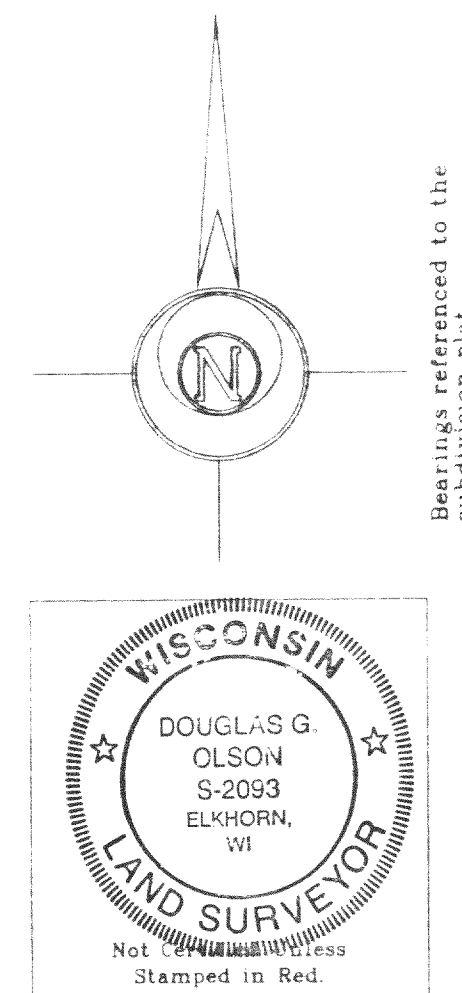

Bearings referenced to the
subdivision plat

- Notes: 1) This survey plat is not
certified unless signed
and sealed in red ink.
- 2) This survey is subject to Wisconsin lien laws.
This Plat of Survey is the notice of intent
to file lien. Lien waiver required.


Copyright © 1999 by Jensen & Olson Land Surveying, LLC.

All rights reserved. No part of this survey plat may be reproduced
or transmitted in any form by any means - graphic, electronic, or
mechanical, including photocopying, tracing, or information storage
and retrieval systems - without permission in writing from Douglas G.
Olson, Jensen & Olson Land Surveying, LLC.

I, Douglas G. Olson, Wisconsin Registered Land Surveyor,
do hereby certify that this survey was performed by me or under
my direction in full compliance with owners / agents instructions
and Chapter A-E 7 of the Wisconsin Administrative Code Minimum
Standards for Property Surveys, and that this map is an accurate
representation thereof to the best of my knowledge and belief.

Date: 12-18-99

Douglas G. Olson
Wisconsin Registered Land Surveyor - 2093

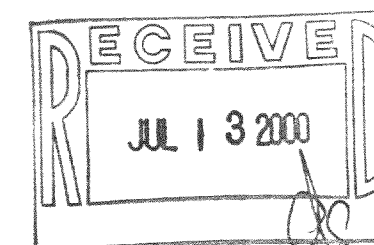

Survey Date: Dec. 16, 1999.
Revisions:

Scale in Feet
1" = 30'

Jensen & Olson Land Surveying, LLC
45 South Wisconsin Street
Elkhorn, Wisconsin 53121
P.O. Box 322
Telephone: (262) 799-4394

Legend
Found County Section Corner
Found Iron Pipe
Set Iron Rod 3/4" diameter
Recorded Information
Utility Pole
Concrete Foundation
Asphalt Surface

Sheet 1 of 1 Sheets
Job Reference Number
1000 1 48

1999.148

FEW-8

216-2880