


ABELL
SURVEYING & MAPPING
1140 SEQUOIA STREET • DELAVAN, WISCONSIN 53115
262-728-6737

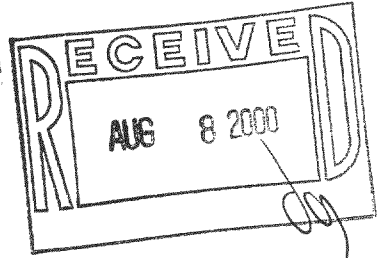

ORDERED BY: PHIL KLINE
2306 SOUTH SHORE DRIVE
DELAVAN, WI 53115

N

SCALE 1"=20'

LEGEND

- -IRON PIPE FOUND
- -IRON ROD FOUND
- -1" DIA. IRON PIPE SET
- -3/4" DIA. IRON ROD SET IN BLACKTOP ROADWAY
- X—X— WOOD FENCE
- () -RECORDED AS

PLAT OF SURVEY OF

LOTS 1-2, BLOCK 2, ROBBINS SUBDIVISION,
LOCATED IN T2N, R16E, WALWORTH COUNTY,
WISCONSIN.


I, DAVID F. ABELL, DO HEREBY CERTIFY THAT I HAVE SURVEYED THE PROPERTY HEREON DESCRIBED ACCORDING TO THE OFFICAL RECORDS AND THAT THE PLAT HEREON IS A CORRECT REPRESENTATION OF THE PROPERTY LINES TO THE BEST OF MY KNOWLEDGE AND BELIEF.

David F. Abell

DAVID F. ABELL
WISCONSIN REGISTERED LAND SURVEYOR, S-1596

July 6, 2000

DATE: JOB NUMBER - 00038
NOTE: THIS IS NOT A CERTIFIED COPY UNLESS SEALED.

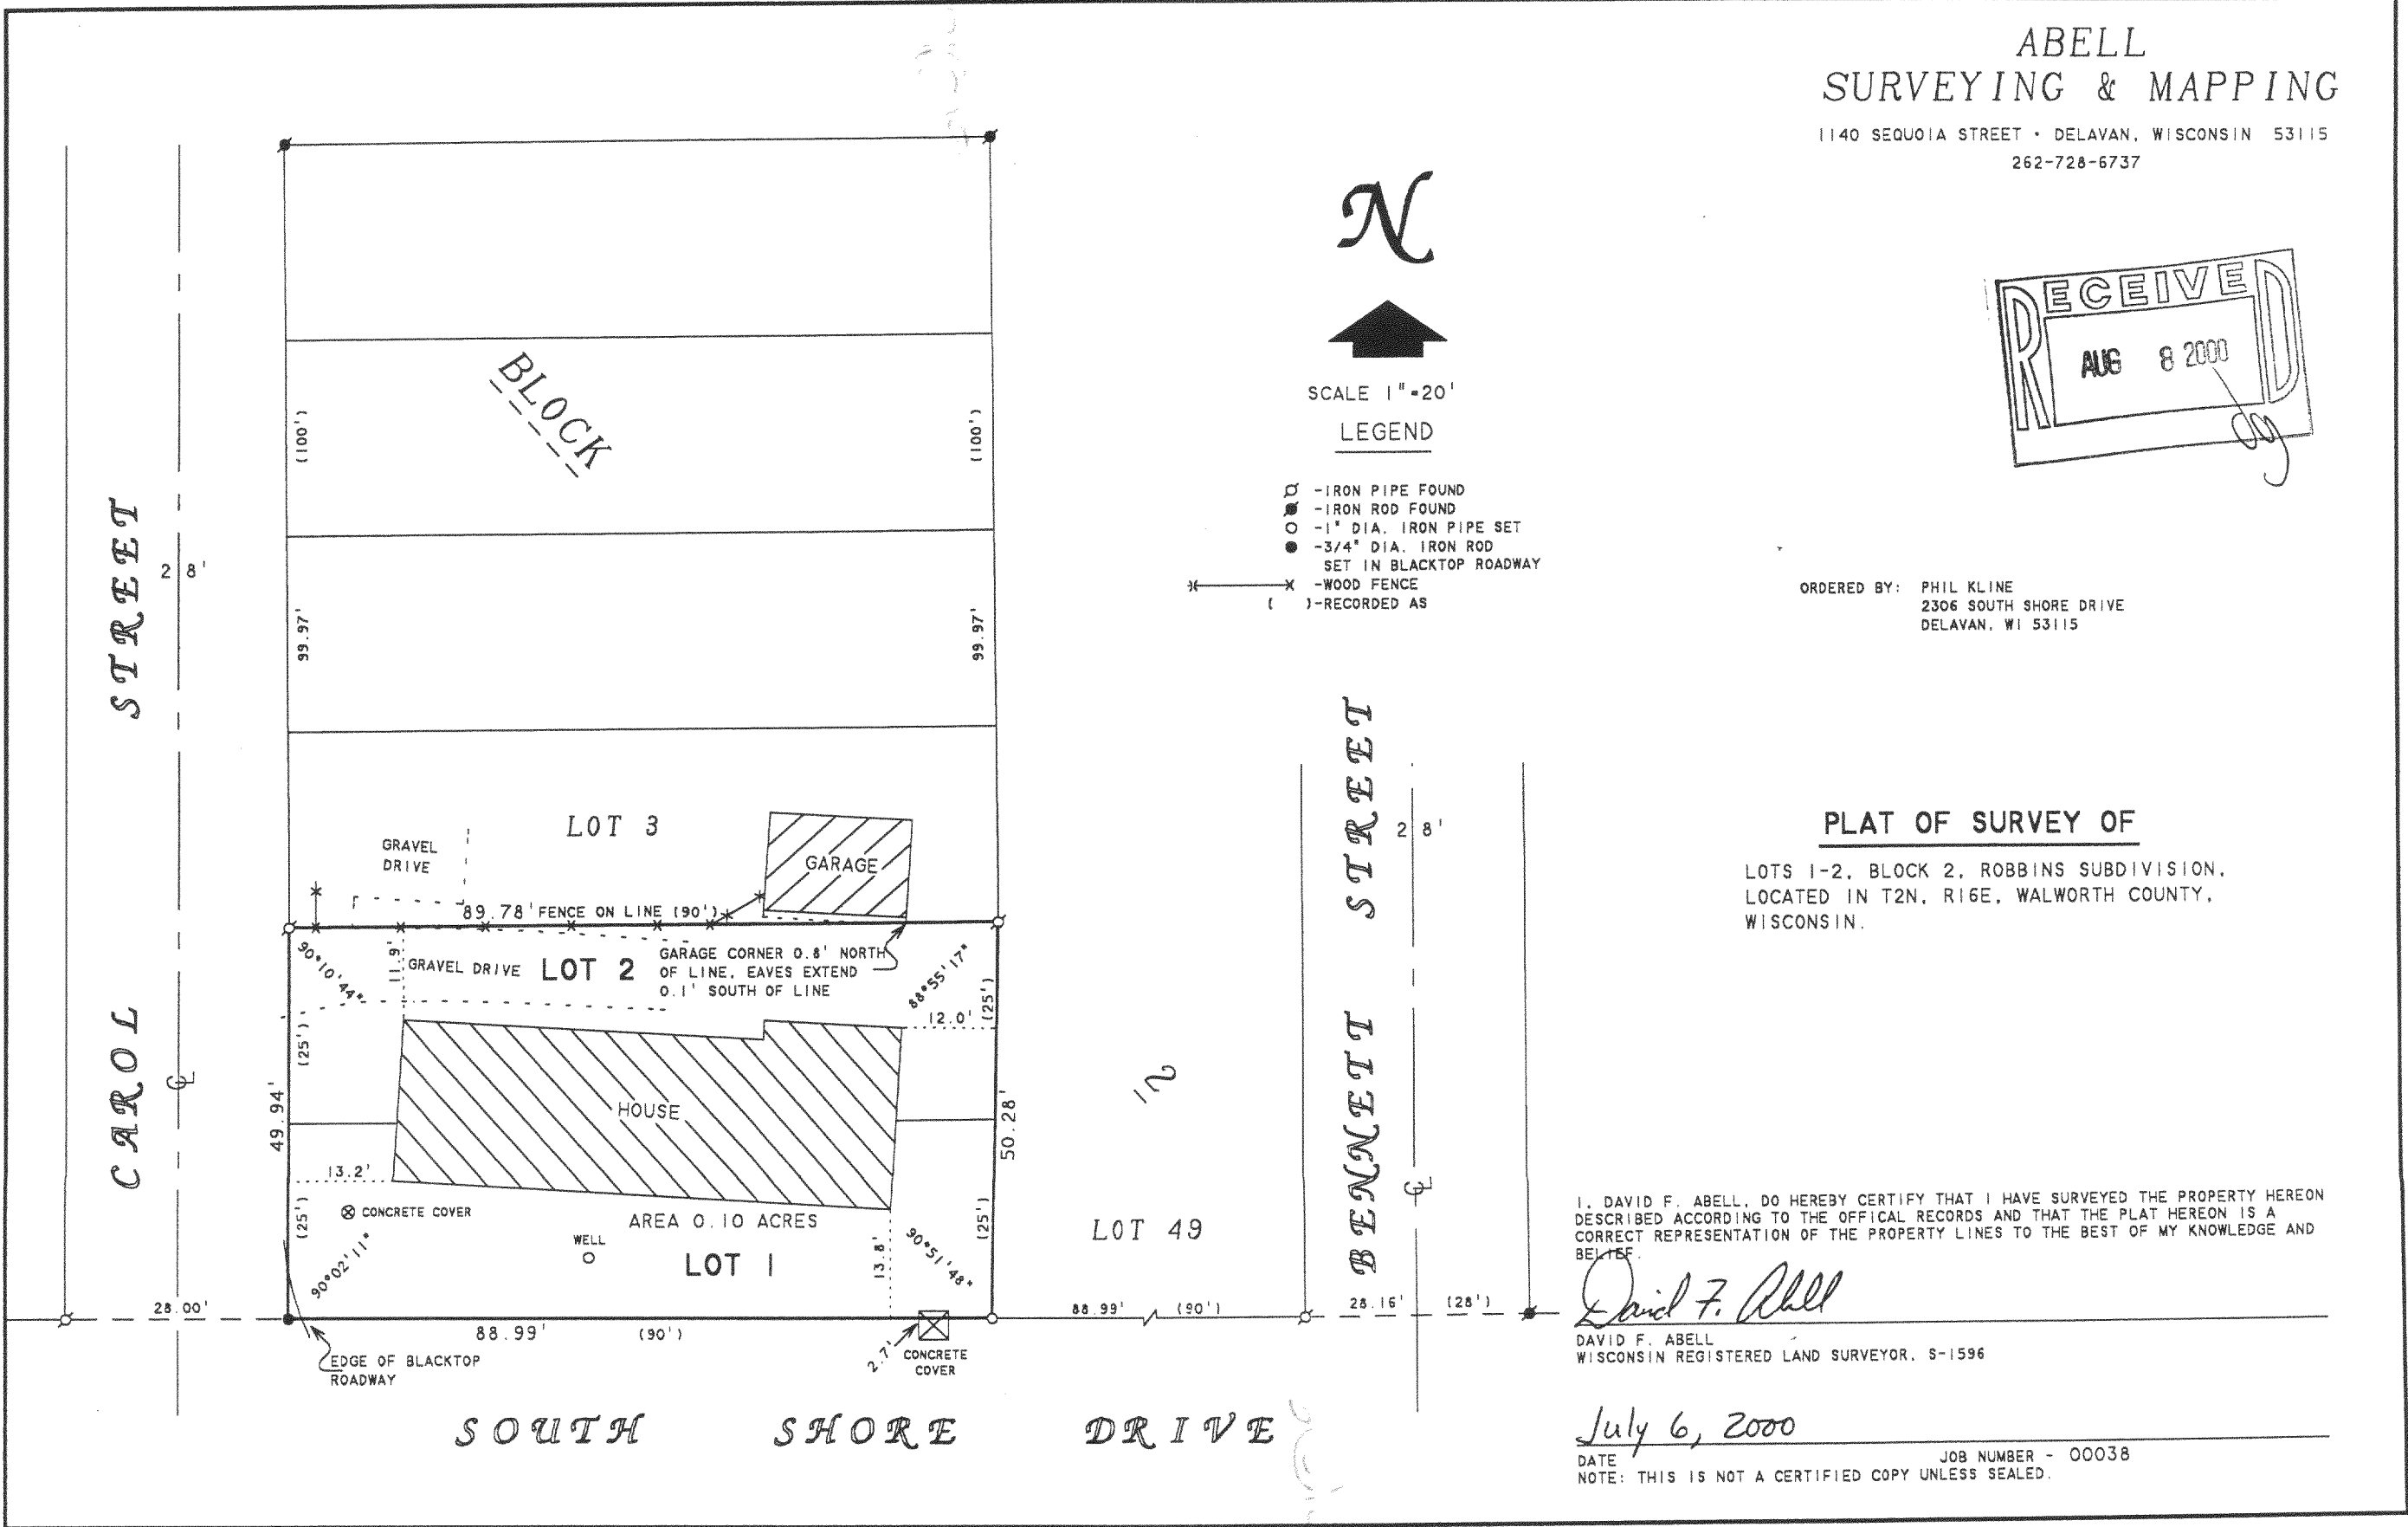

FRO-7

216-2891