


WEST 1/4 CORNER
SECTION 25-2-16

ABELL
SURVEYING & MAPPING
1140 SEQUOIA STREET • DELAVAN, WISCONSIN 53115
262-728-6737

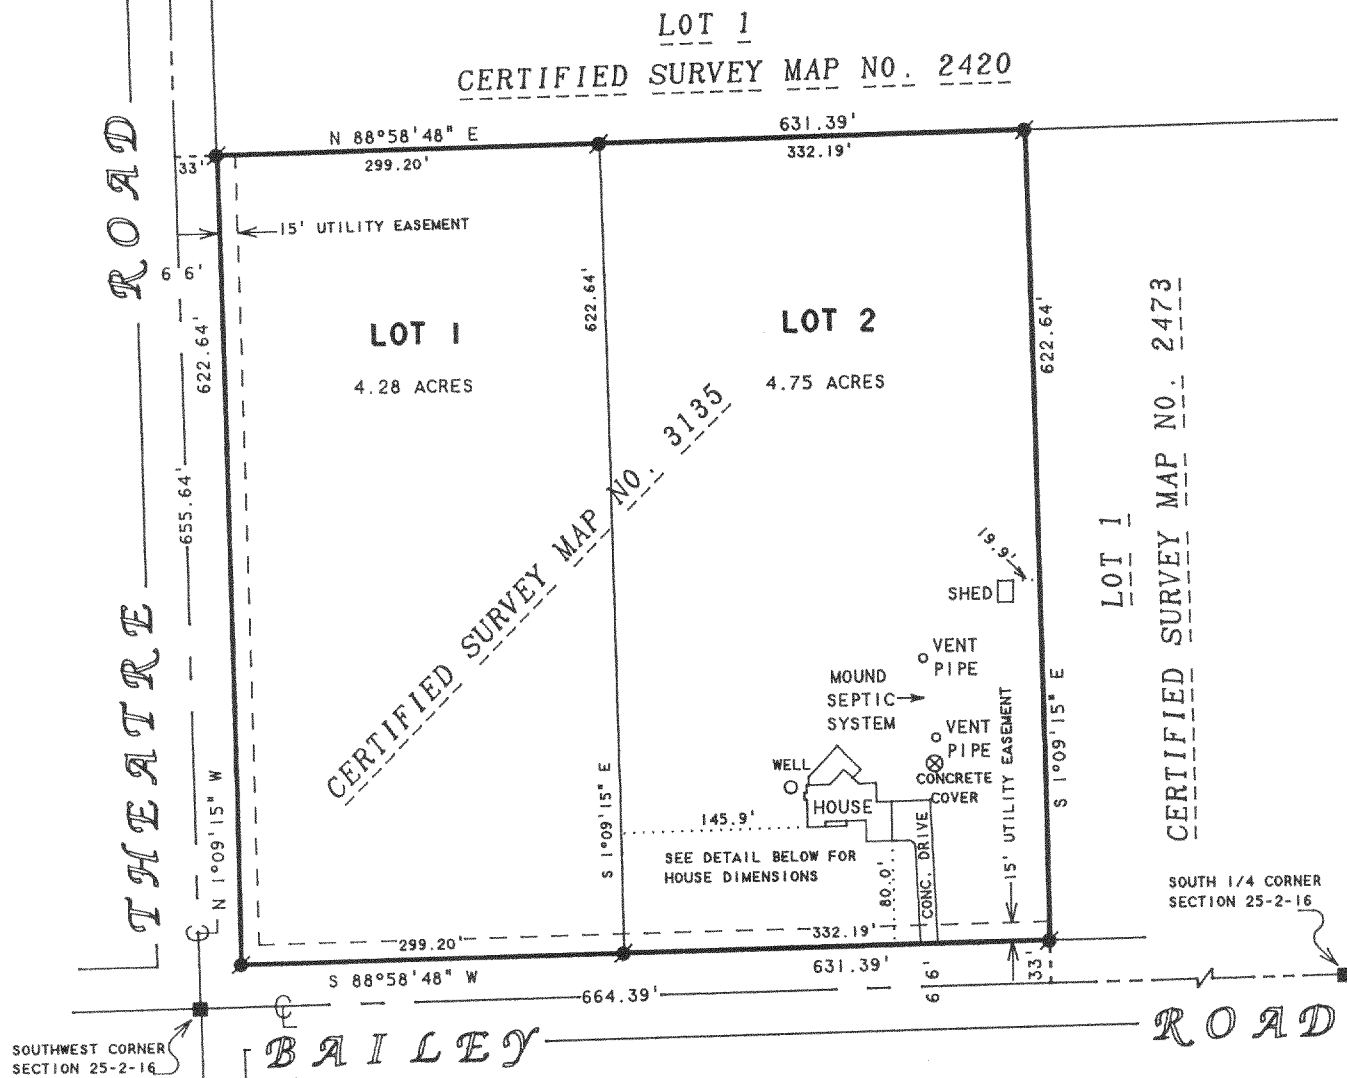

NOTE: BEARINGS ARE REFERENCED TO THE
WISCONSIN COORDINATE SYSTEM -
SOUTH ZONE.

PLAT OF SURVEY OF

LOTS 1 AND 2 OF CERTIFIED SURVEY MAP NO. 3135,
LOCATED IN THE SOUTHWEST 1/4 OF SECTION 25,
T2N, R16E, WALWORTH COUNTY, WISCONSIN.



N



SCALE 1"=150'

LEGEND

- - IRON ROD FOUND
- - CONCRETE MONUMENT FOUND
- CP - CONCRETE PORCH
- ⌵ - TV SATELLITE ANTENNA

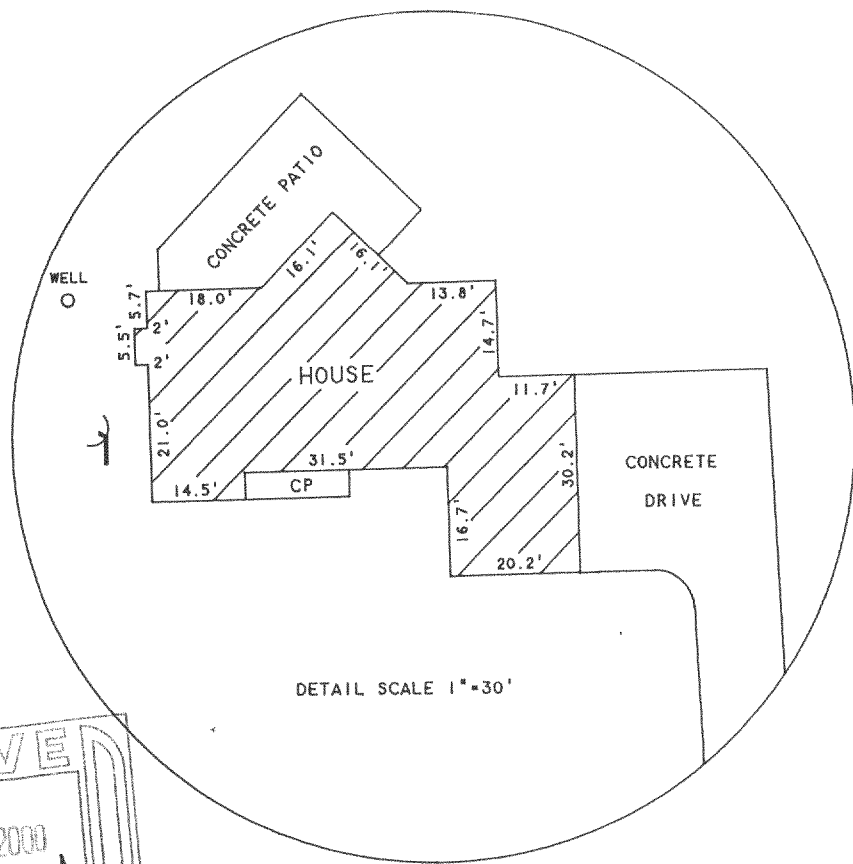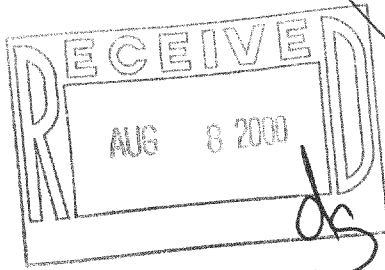

I HEREBY CERTIFY THAT I HAVE SURVEYED THE ABOVE DESCRIBED PROPERTY AND THAT THE
ABOVE MAP IS A TRUE REPRESENTATION THEREOF AND SHOWS THE SIZE AND LOCATION OF
THE PROPERTY, ITS EXTERIOR BOUNDARIES, THE LOCATION OF ALL VISIBLE STRUCTURES
AND DIMENSIONS OF ALL PRINCIPAL BUILDINGS THEREON, BOUNDARY FENCES, APPARENT
EASEMENTS, ROADWAYS AND VISIBLE ENCROACHMENTS, IF ANY, TO THE BEST OF MY
KNOWLEDGE AND BELIEF.

THIS SURVEY IS MADE FOR THE USE OF THE PRESENT OWNERS OF THE PROPERTY, AND ALSO
THOSE WHO PURCHASE, MORTGAGE, OR GUARANTEE THE TITLE THERETO WITHIN ONE (1) YEAR
FROM DATE HEREON.

David F. Abell

DAVID F. ABELL
WISCONSIN REGISTERED LAND SURVEYOR, S-1596

June 19, 2000

DATE JOB NUMBER - 98226A
NOTE: THIS IS NOT A CERTIFIED COPY UNLESS SEALED.

ORDERED BY: ATTY. ROBERT C. LEIBSLE
GODFREY, NESHEK, WORTH,
LEIBSLE & CONOVER, S.C.
11 NORTH WISCONSIN STREET
P.O. BOX 260
ELKHORN, WI 53121-0260

FA-3135-1

216-2899