

PLAT OF SURVEY

LOT 2 AND OUTLOT 1 OF
CERTIFIED SURVEY MAP NO.
2920 AS RECORDED IN VOL.
15 OF CERTIFIED SURVEY
MAPS AS PAGES 171-177 AS
DOCUMENT NO. 367824,
LOCATED IN PART OF THE
NORTHWEST 1/4 OF THE
SOUTHWEST 1/4 OF SECTION
9, TOWN 2 NORTH, RANGE 16
EAST, TOWN OF DELAVAN,
COUNTY OF WALWORTH, STATE
OF WISCONSIN.

A PERPETUAL NONEXCLUSIVE 50' WIDE
EASEMENT FOR INGRESS AND EGRESS TO TAX
KEY INDEX NUMBER D-9-5B, AS RECORDED
IN VOLUME 650 ON PAGE 634 AS
DOCUMENT NUMBER 365475.


ORDERED BY: PATTI KIRCHOFF
KEEFE REAL ESTATE
751 GENEVA PARKWAY
LAKE GENEVA, WI. 53147

OWNERS: WM. BRUCE AND ESTHER KING
6414 HWY 11
DELAVAN, WI. 53115

LINE	BEARING	DISTANCE
L1	N 52°11'44" E	31.46
L2	S 0°23'25" E	23.71
L3	N 56°33'51" E	28.41
L4	S 12°09'40" E	32.17

LOT 1

LOT 2
49270 SQ. FT.

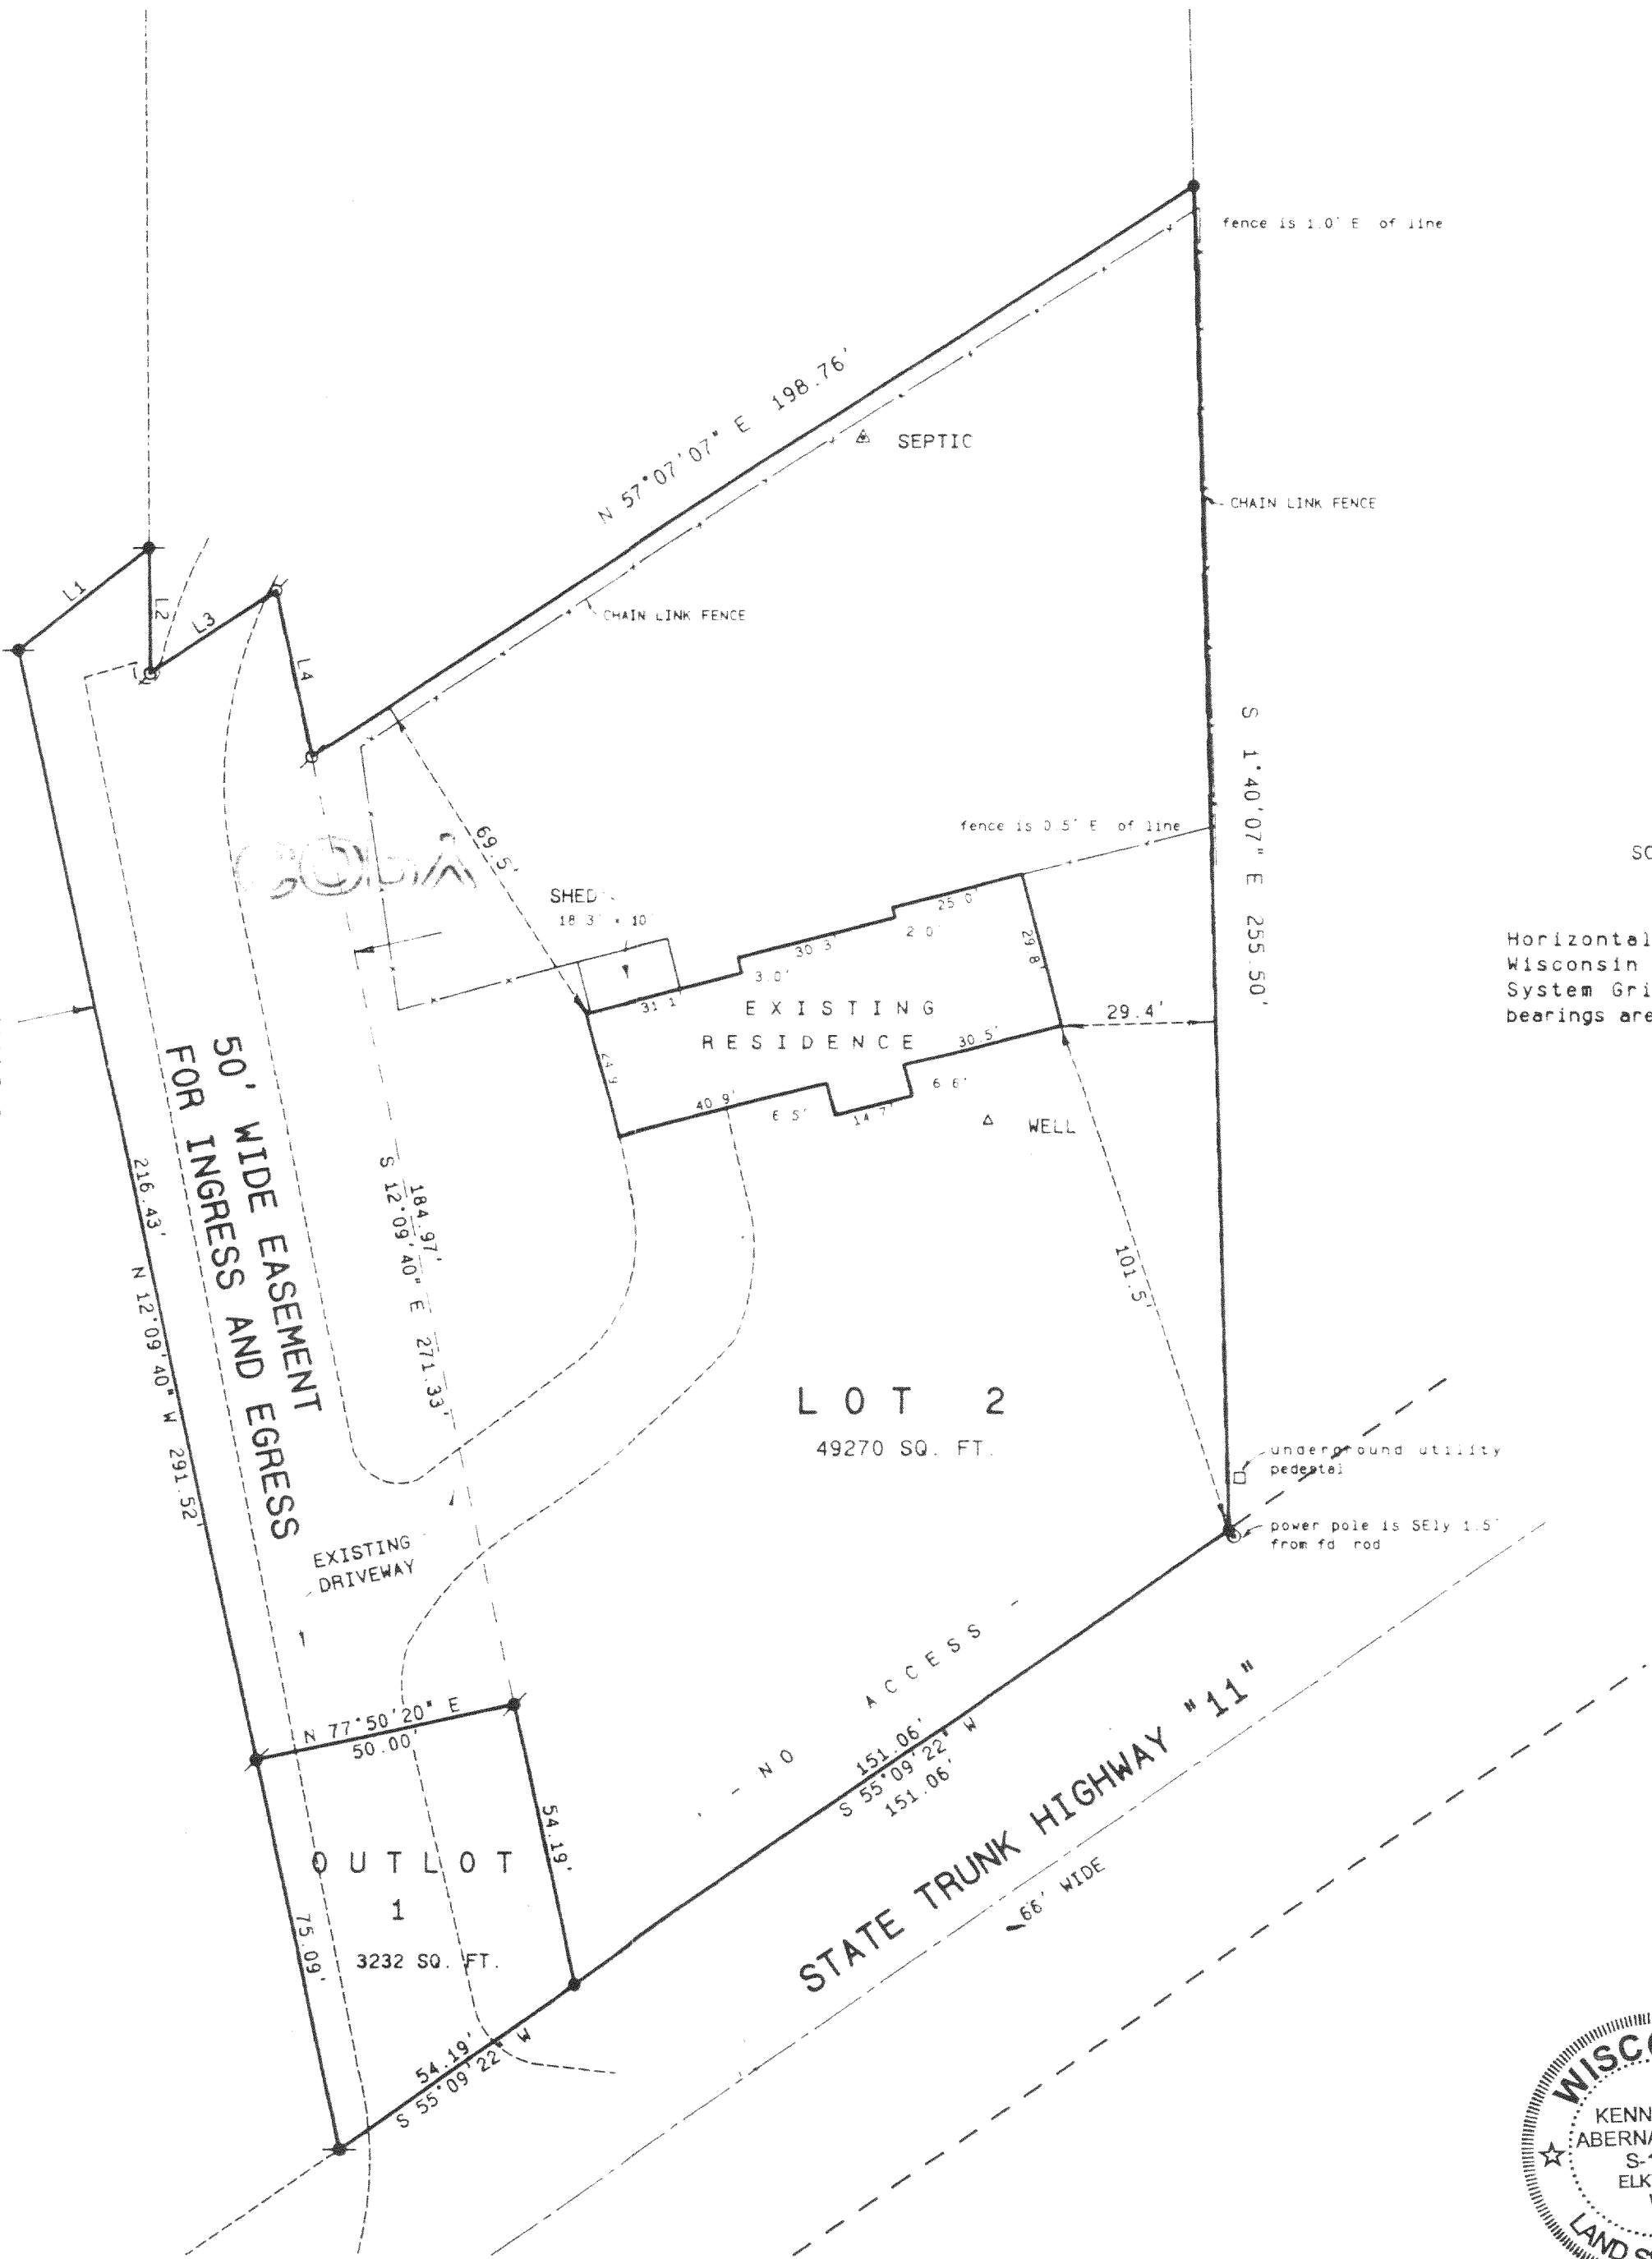


SCALE 1" = 30 FEET

Horizontal Datum is based on the
Wisconsin State Plane Coordinate
System Grid, South Zone, and all
bearings are referred to Grid North.

Legend

- FOUND IRON PIPE
- FOUND IRON ROD
- FOUND BRASS CAPPED MONUMENT
- FOUND CONCRETE MONUMENT
- CHISEL CUT IN CONCRETE
- SET IRON ROD, 24" LONG, WEIGHING
1.5 LBS. LINEAL FT., 3/4" DIA.
- SET IRON ROD, 30" LONG, WEIGHING
4.5 LBS. LINEAL FT., 1 1/16" DIA.
- RECORDED AS DIMENSION
- EXISTING FENCE

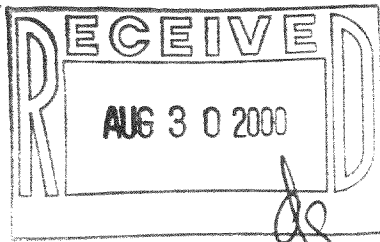

SCALE: 1" = 30 FEET



"I hereby certify that the above described property has been surveyed
by me or under my direction and that the above plat is a true
representation thereof and shows the size and location of the property, its
external boundaries, the location of all visible structures and dimensions of
all principal buildings thereon, boundary fences, adjacent easements,
roadways and visible encroachments, if any."

"This survey is made for the use of the present owners of the property,
and also those who purchase, mortgage, or otherwise acquire the title thereto within
one year from date hereof."

Kenneth B. Abernathy, Jr.

KENNETH B. ABERNATHY, JR.
WISCONSIN REGISTERED LAND SURVEYOR,
S-1594

Date: *AUG 25, 2000* Job No. *97714*