


PLAT OF SURVEY

LOTS 6 AND 7, BLOCK 3, INLET OAKS
SUBDIVISION NUMBER 4, LOCATED IN SECTION
15, TOWN 2 NORTH, RANGE 16 EAST, DELAVAN
TOWNSHIP, WALWORTH COUNTY, WISCONSIN.


OWNERS: JOHN & TERI DESCHNER
407 DELAVAN DR.
DELAVAN, WI. 53115

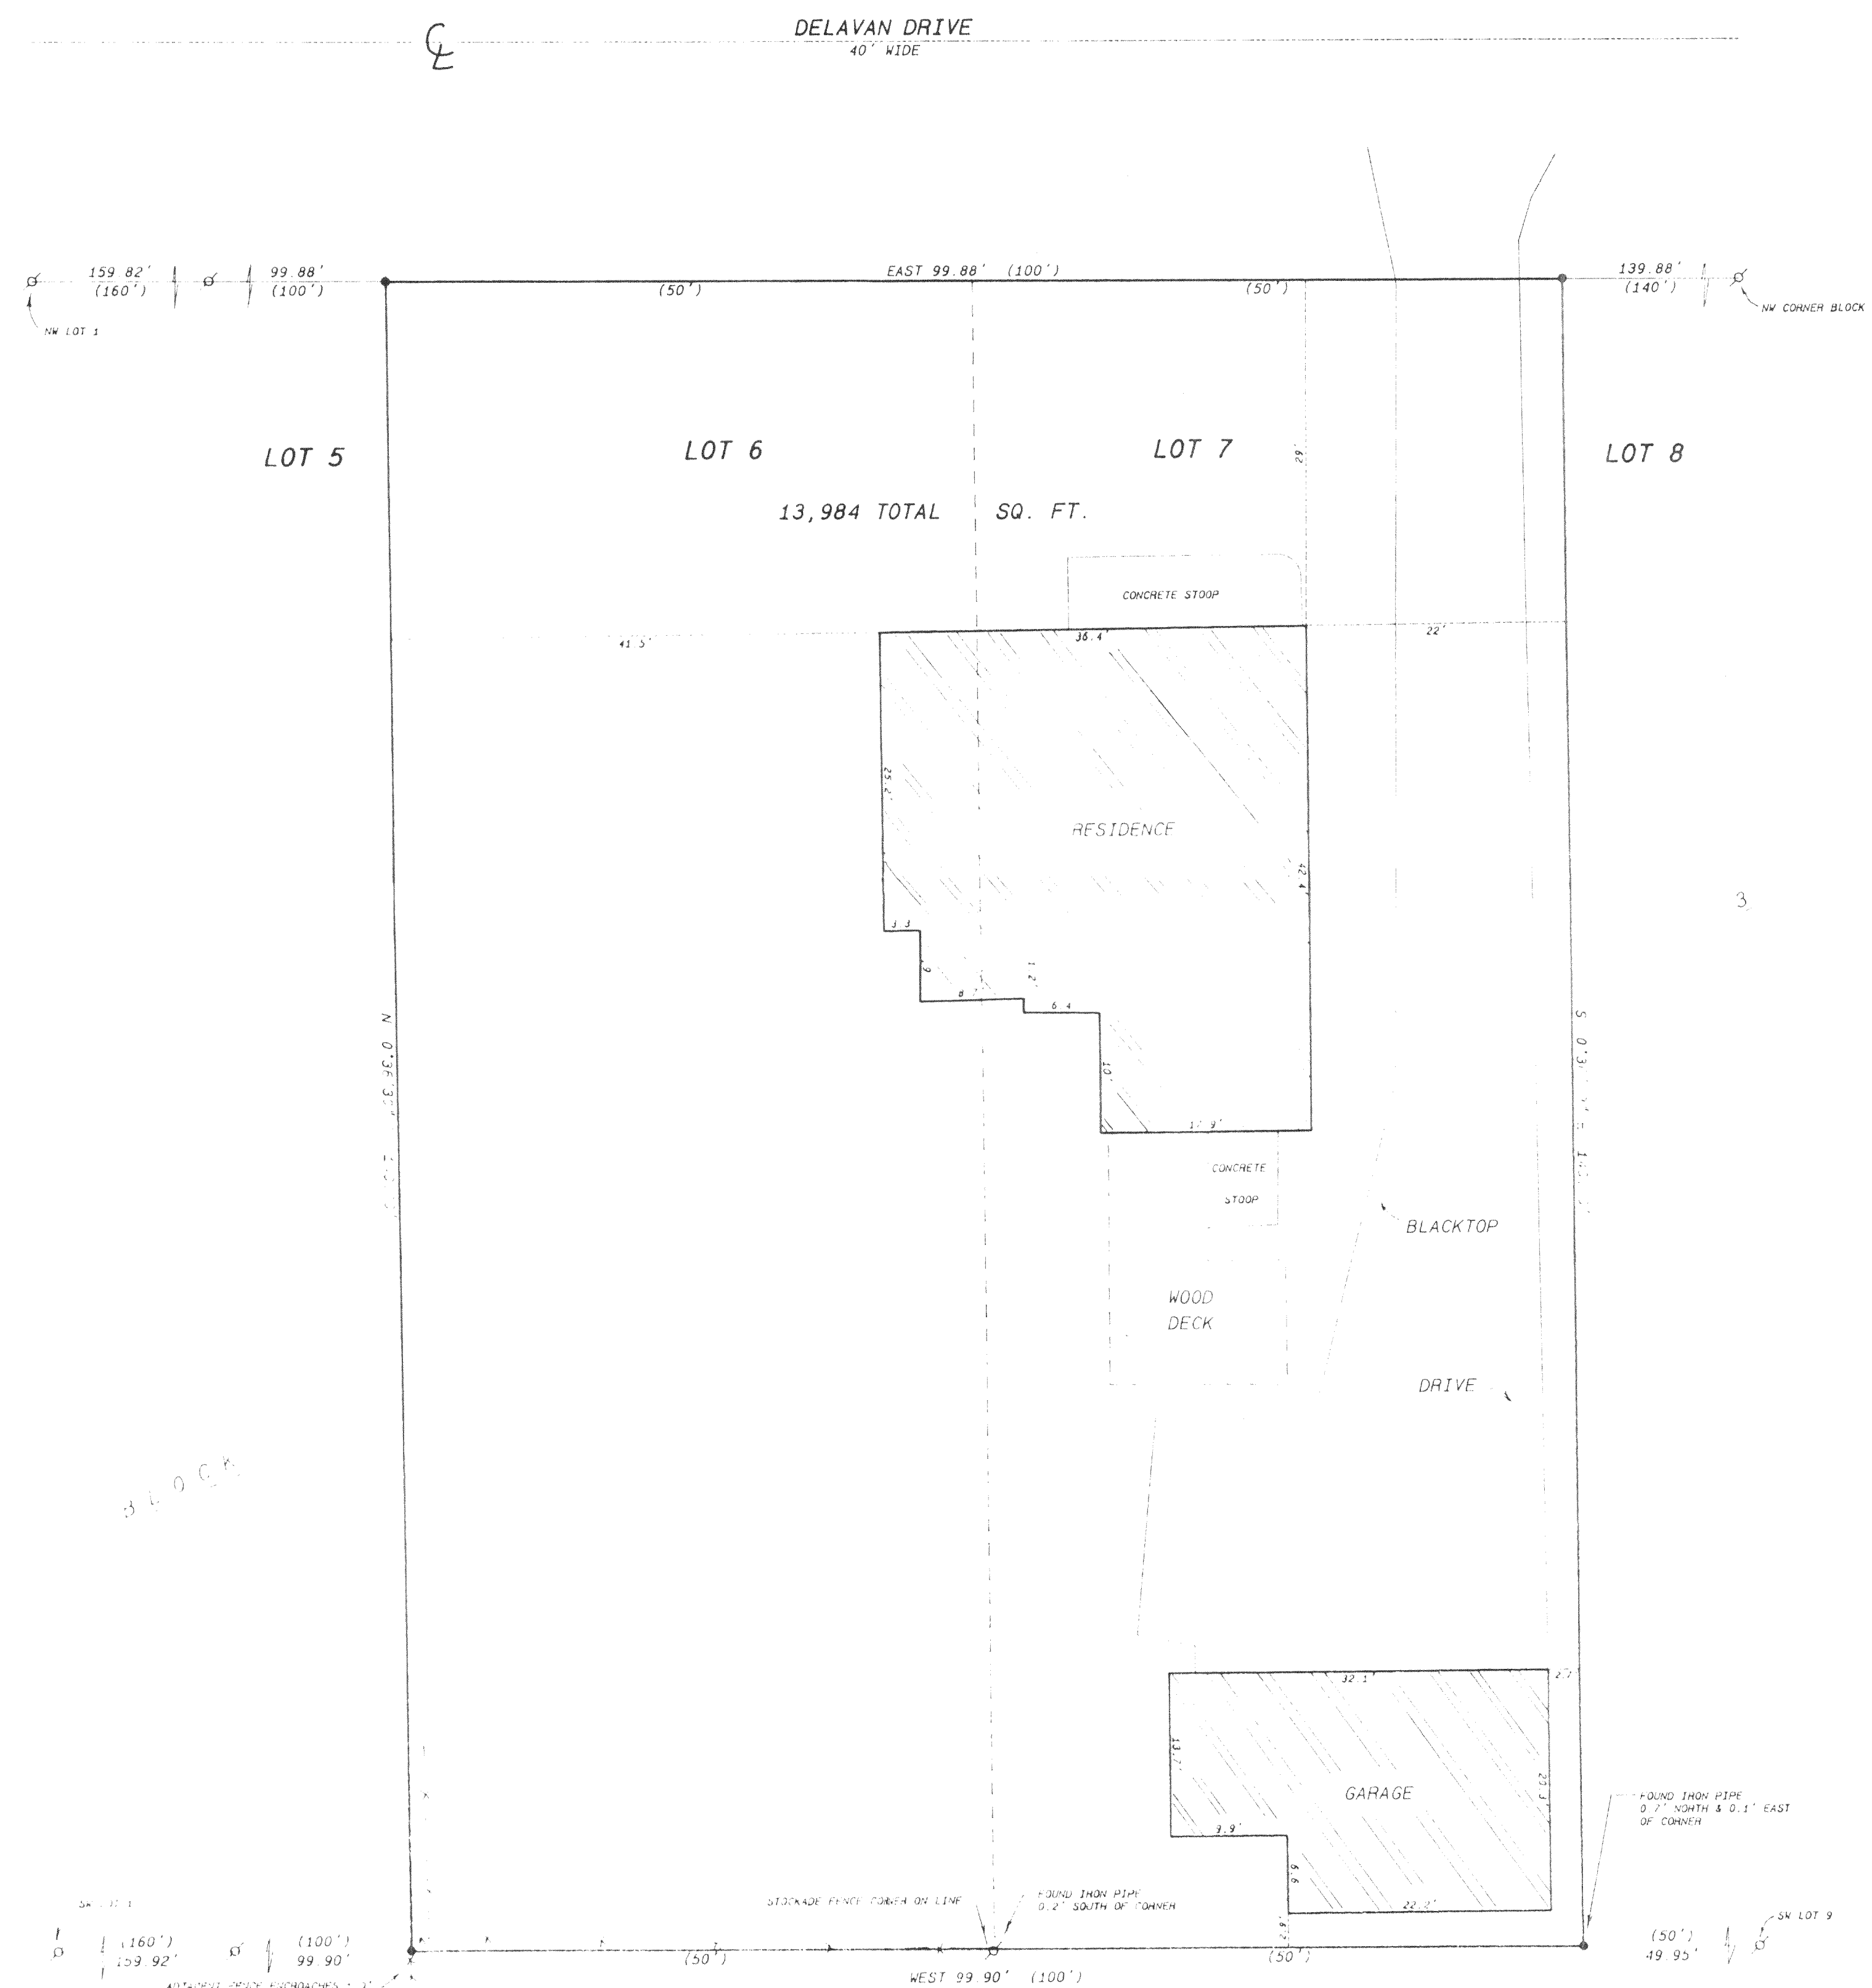


SCALE: 1 INCH = 10 FEET

Legend

- 1" FOUND IRON PIPE
- FOUND IRON ROD
- FOUND BRASS CAPPED MONUMENT
- X FOUND CONCRETE MONUMENT
- + CHISEL CUT IN CONCRETE
- SET IRON ROD, 24" LONG, WEIGHING 15 LBS. UNILAL FT. 3/4" DIA.
- SET IRON ROD, 30" LONG, WEIGHING 45 LBS. UNILAL FT. 1 1/16" DIA.
- (EXT) RECORDED AS DIMENSION
- X-XX-XX EXISTING FENCE

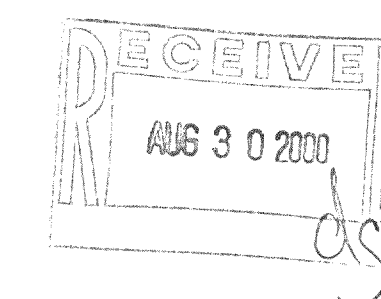

SCALE: 1" = 10 FEET

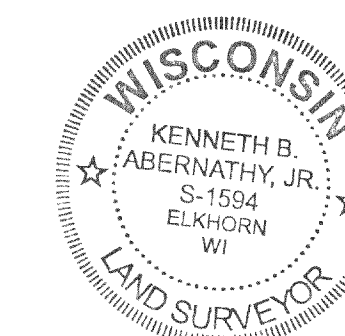

KENNETH B. ABERNATHY, JR.
WISCONSIN REGISTERED LAND SURVEYOR,
S-1594

Date: JUNE 2, 2000 Job No. 00-514

FIN4-21

216-2924