


GEORGE T. DUNHAM
SURVEYING & SUBDIVIDING
DELAVER, WISCONSIN

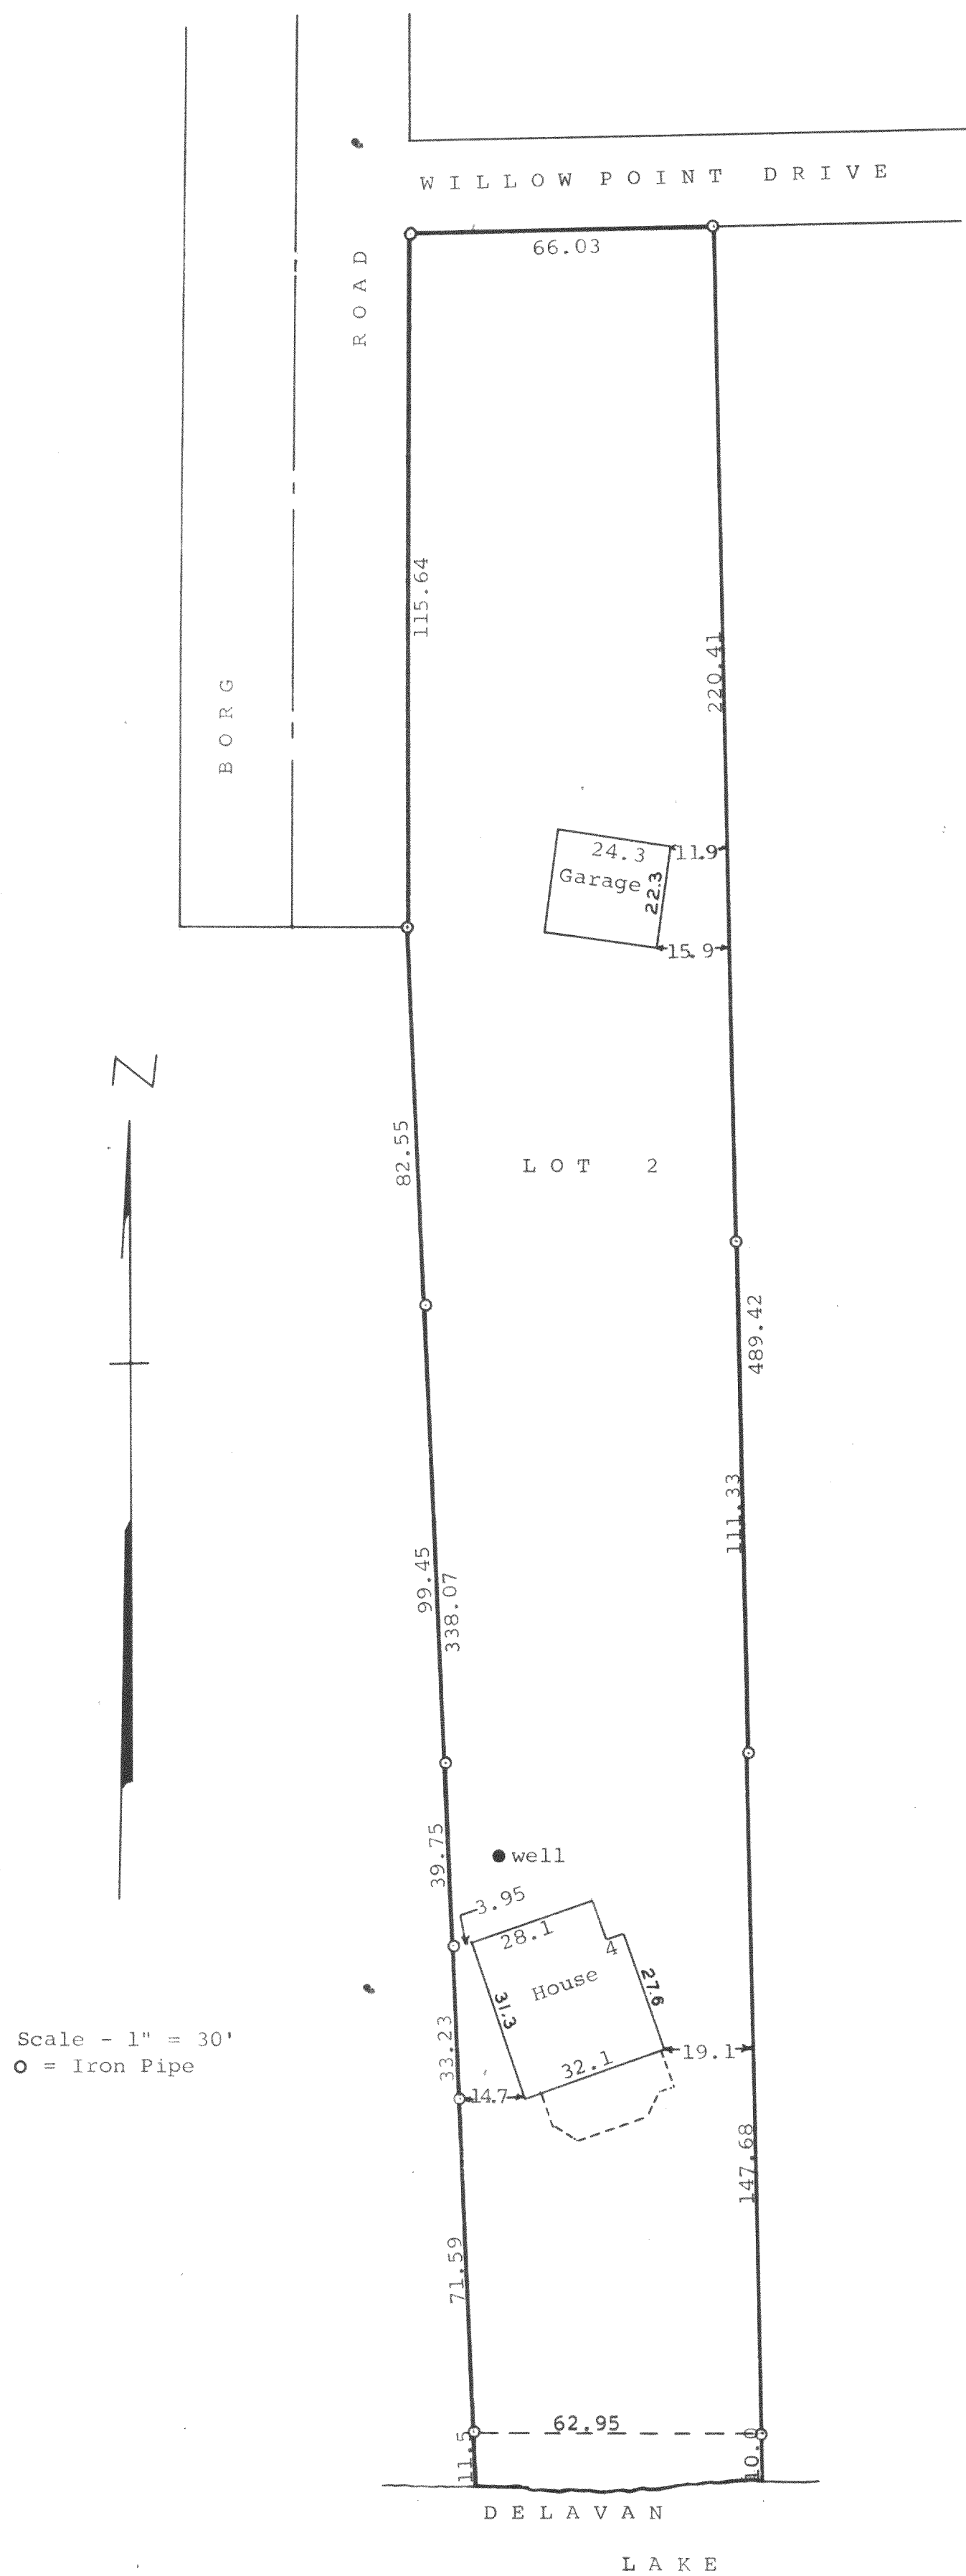

Plat of survey of Lot 2 in "The Hamlet of Bon Secour" located in Section 29, T 2 N, R 16 E, Walworth County, Wisconsin.
August 7, 1967

George T. Dunham
George T. Dunham, Surveyor

FBO-2