


GEORGE T. DUNHAM
SURVEYING & SUBDIVIDING
DELAVAN, WISCONSIN

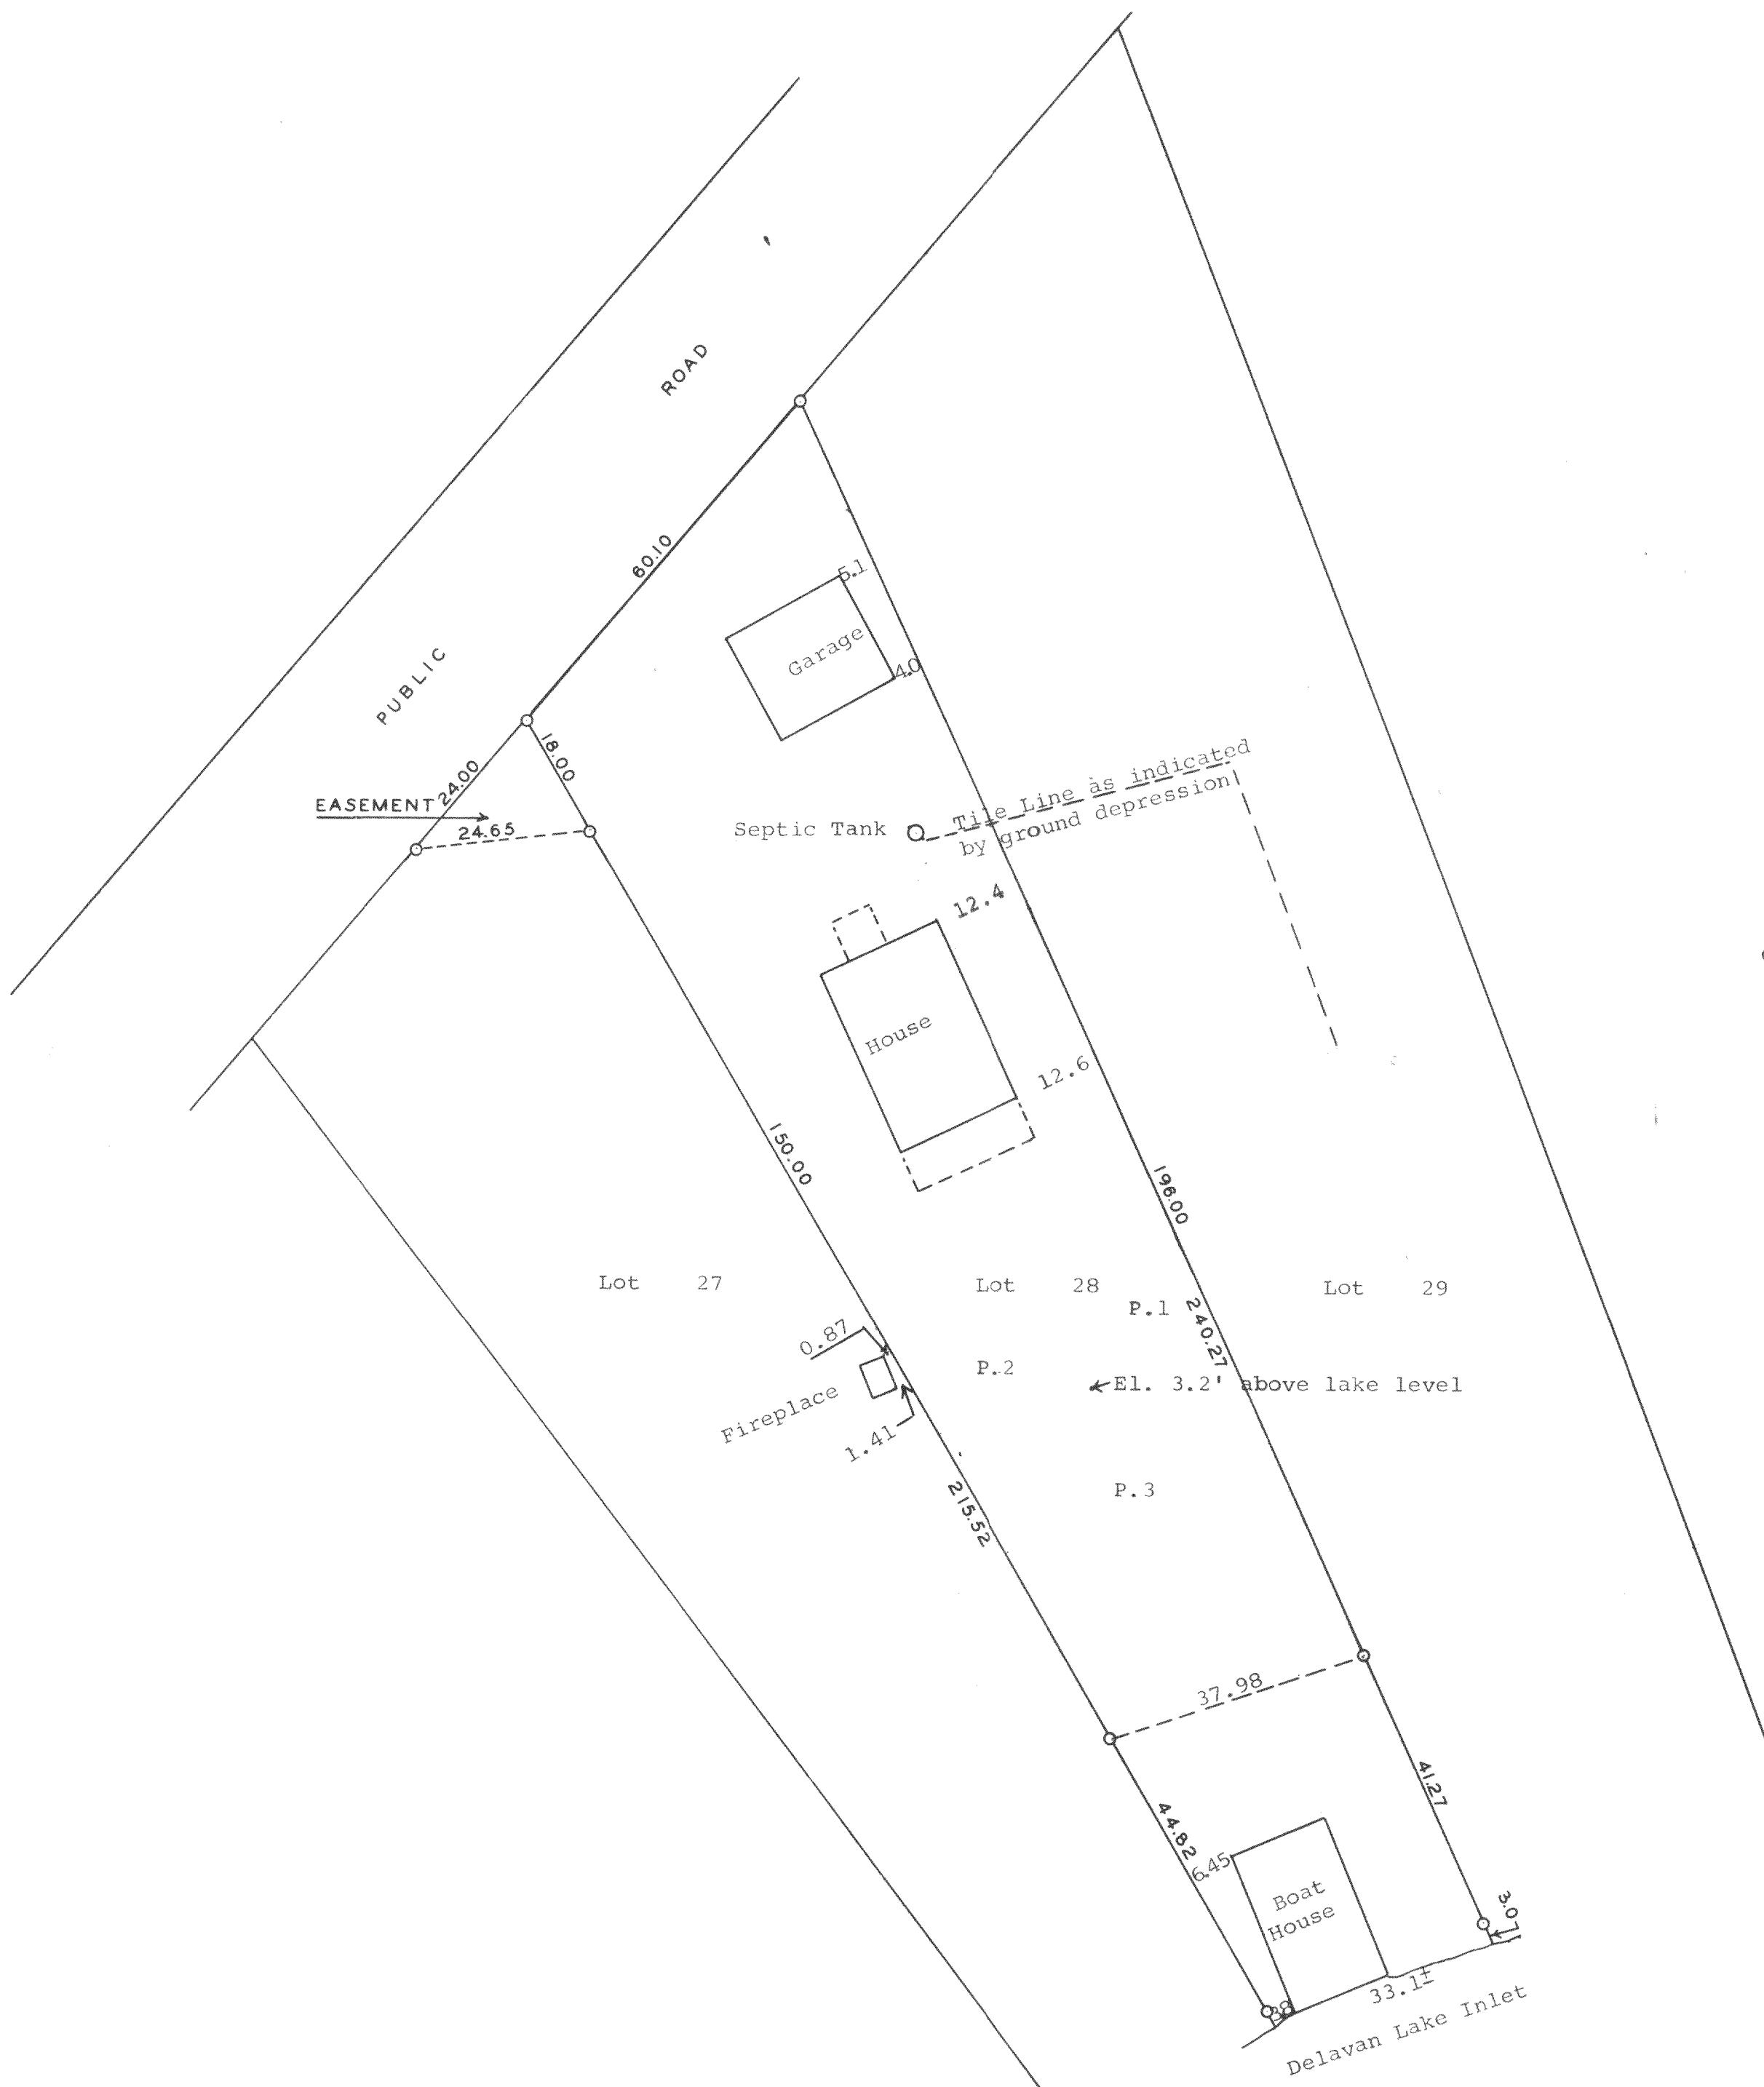

Scale - 1" = 20'
○ = Iron Pipe or Rod

Plat of survey of Lot 28 of The Annex to Inlet Oaks
Located in Sections 15 & 22, T 2 N, R 16 E, Walworth
County, Wisconsin.
October 7, 1967
Revised 10/31/67
12/14/67 George T. Dunham, Surveyor

George T. Dunham

RVD
FIA - 22A