


GEORGE T. DUNHAM
SURVEYING & SUBDIVIDING
DELAVER, WISCONSIN

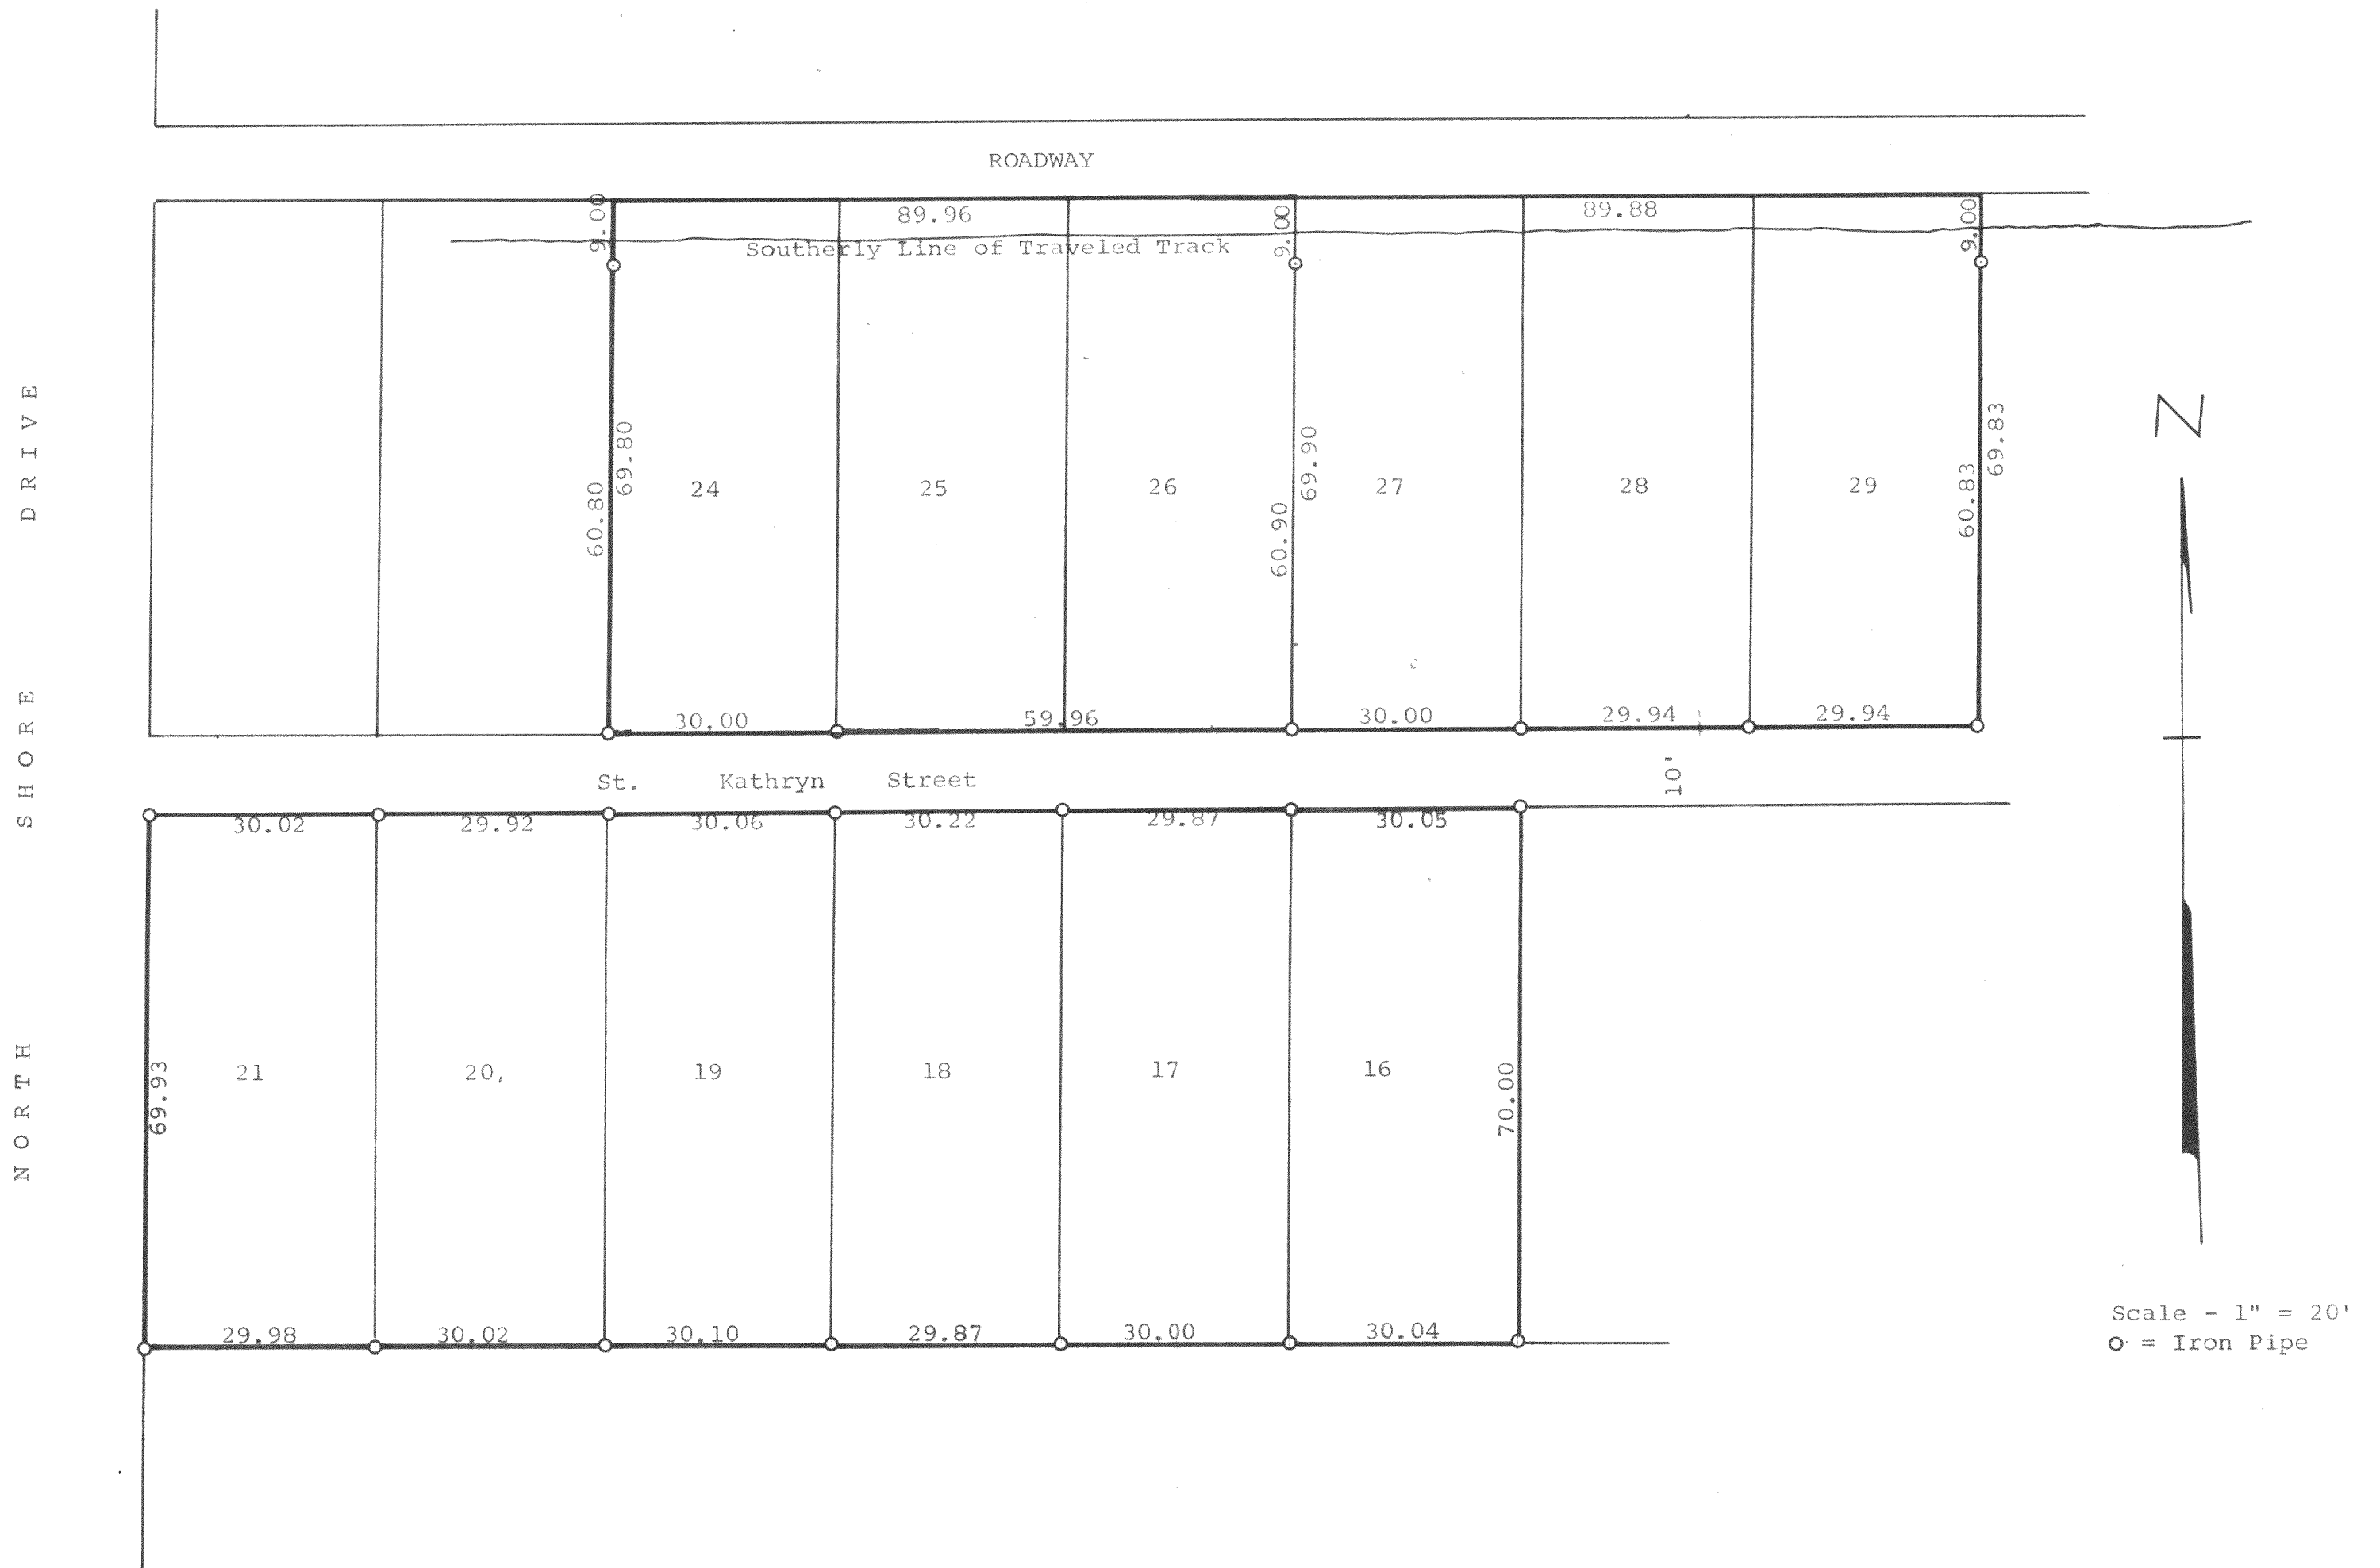

Scale - 1" = 20'
○ = Iron Pipe

Plat of survey of Lots 16-21 inclusive and Lots 24-29
inclusive of The Fleming Addition located in Section 28,
T 2 N, R 16 E, Walworth County, Wisconsin.
January 13, 1969

George T. Dunham
George T. Dunham, Surveyor

216-279