

# Plat of Survey

of

## Tax Parcel F D 2200006

A parcel of land located in the Northeast 1/4 of Section 22, Town 2 North, Town 16 East, Walworth County, Wisconsin, as described in a Warranty Deed recorded in Vol. 644 of Deeds on Page 104 as Document No. 342153 as shown below:

A parcel of land located in the NE 1/4 of fractional Section 22-2-16 East, Walworth County, Wisconsin, described as follows, to-wit: Commencing at the E 1/4 Section corner of said Section 22; thence West along the 1/4 section line, 38.14 feet to the place of beginning; thence continue West on the 1/4 section line 191.71 feet to a point in the centerline of State Trunk Highway #50; thence North 29°20' West along said centerline 106.29 feet to a point; thence North 38°43' East 198.87 feet to a point; thence South 25°45' East 274.91 feet to said 1/4 section line and the place of beginning. Said land being in the Town of Delavan.

## Tax Parcel F D 2200007

A parcel of land located in the Northeast 1/4 of Section 22, Town 2 North, Town 16 East, Walworth County, Wisconsin, as described in a Warranty Deed recorded in Vol. 630 of Deeds on Page 5127 as Document No. 286479 as shown below:


Beginning at the East 1/4 corner of the Fractional Section 22 T2N, R16E, East, Walworth County, Wisconsin; run thence West on the South line of the NE 1/4 of said Section 22, 229.85 feet to a point in the centerline of State Trunk Highway #50; thence North 29°20' West along the centerline of State Trunk Highway #50, 106.29 feet to a point; said point marks the place of beginning of the parcel of land herein after described; thence continue North 29°20' West along the centerline of State Trunk Highway #50, 223.88 feet to a point; thence North 65°13' East 193.40 feet to a point; thence South 25°45' East 134.86 feet to a point; thence South 38°43' West 198.57 feet to a point and the place of beginning. Said land being in the Town of Delavan.

Surveyed for: **ARC Architectural Group**  
1037 Kentucky Street  
Racine, Wisconsin, 53405


Lot 1  
WESTSHIRE FARMS at the LAKES

Note: Easement shown is taken from previous survey.  
Refer to a current Title Commitment for a complete list of easements which affect these sites.

**VCB**  
Benchmark  
RF spike in South face  
of pole el. 936.76

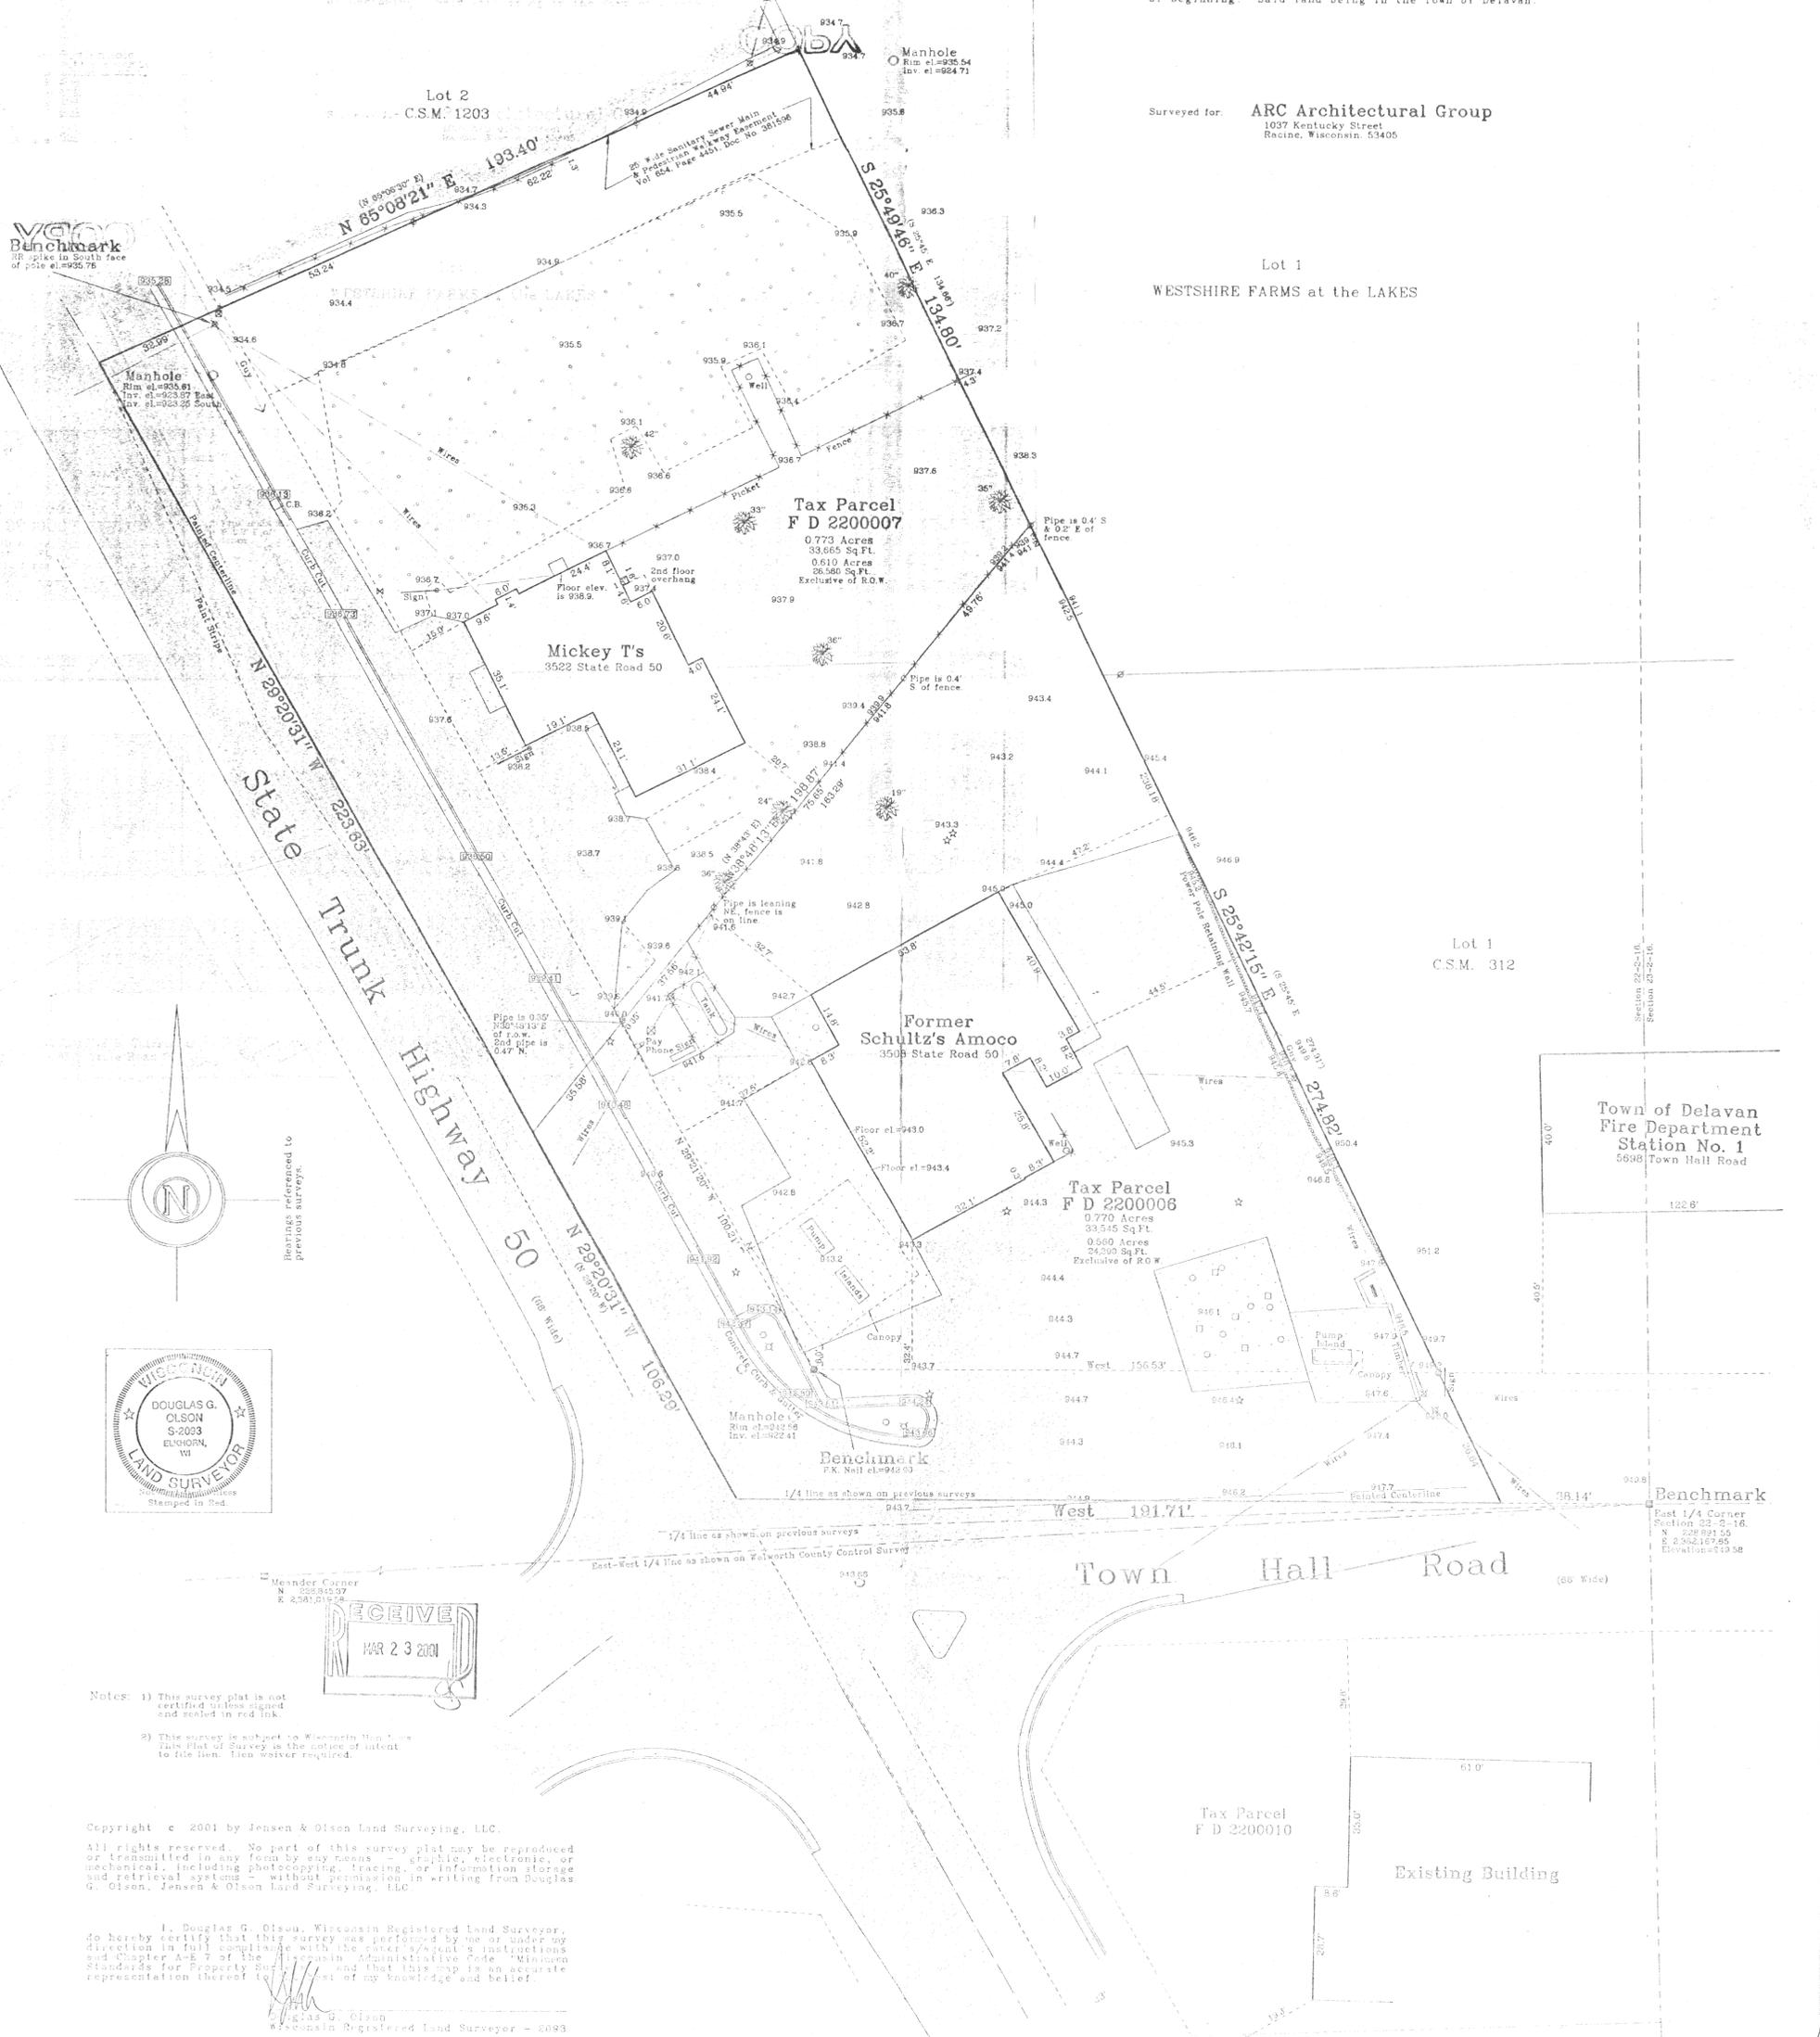

Town of Delavan  
Fire Department  
Station No. 1  
5698 Town Hall Road

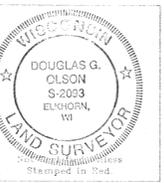

Notes: 1) This survey plat is not certified unless signed and sealed in red ink.  
2) This survey is subject to Wisconsin laws. This Plat of Survey is the notice of intent to file lien. Lien waiver required.

Copyright © 2001 by Jensen & Olson Land Surveying, LLC.  
All rights reserved. No part of this survey plat may be reproduced or transmitted in any form by any means, including photocopying, tracing, or information storage and retrieval systems - without permission in writing from Douglas G. Olson, Jensen & Olson Land Surveying, LLC.  
I, Douglas G. Olson, Wisconsin Registered Land Surveyor, do hereby certify that this survey was performed by me or under my direction in full compliance with the rules and regulations, instructions and Chapter A-E 7 of the Wisconsin Administrative Code - Minimum Standards for Property Surveys - and that this map is an accurate representation thereof to the best of my knowledge and belief.

**Jensen & Olson Land Surveying, LLC**  
45 South Wisconsin Street P.O. Box 322  
Elkhorn, Wisconsin, 53121  
Telephone: (414) 723-2434  
Facsimile: (414) 723-8034

Scale in Feet  
1" = 20'  
Survey date: March 6, 2001  
Revisions:

Job Reference Number  
2001.164

Found County Section Corner	Concrete Surface
Found Iron Pipe	Asphalt Surface
Found Iron Rod	Gravel Surface
Found P.W. Nail	Gravel Surface
Recorded Information	
Monitoring Well	
Utility	
Spot El. Top of Curb	
Spot El. Decision Tree	

FD-22-7  
FD-22-6 216-2992