


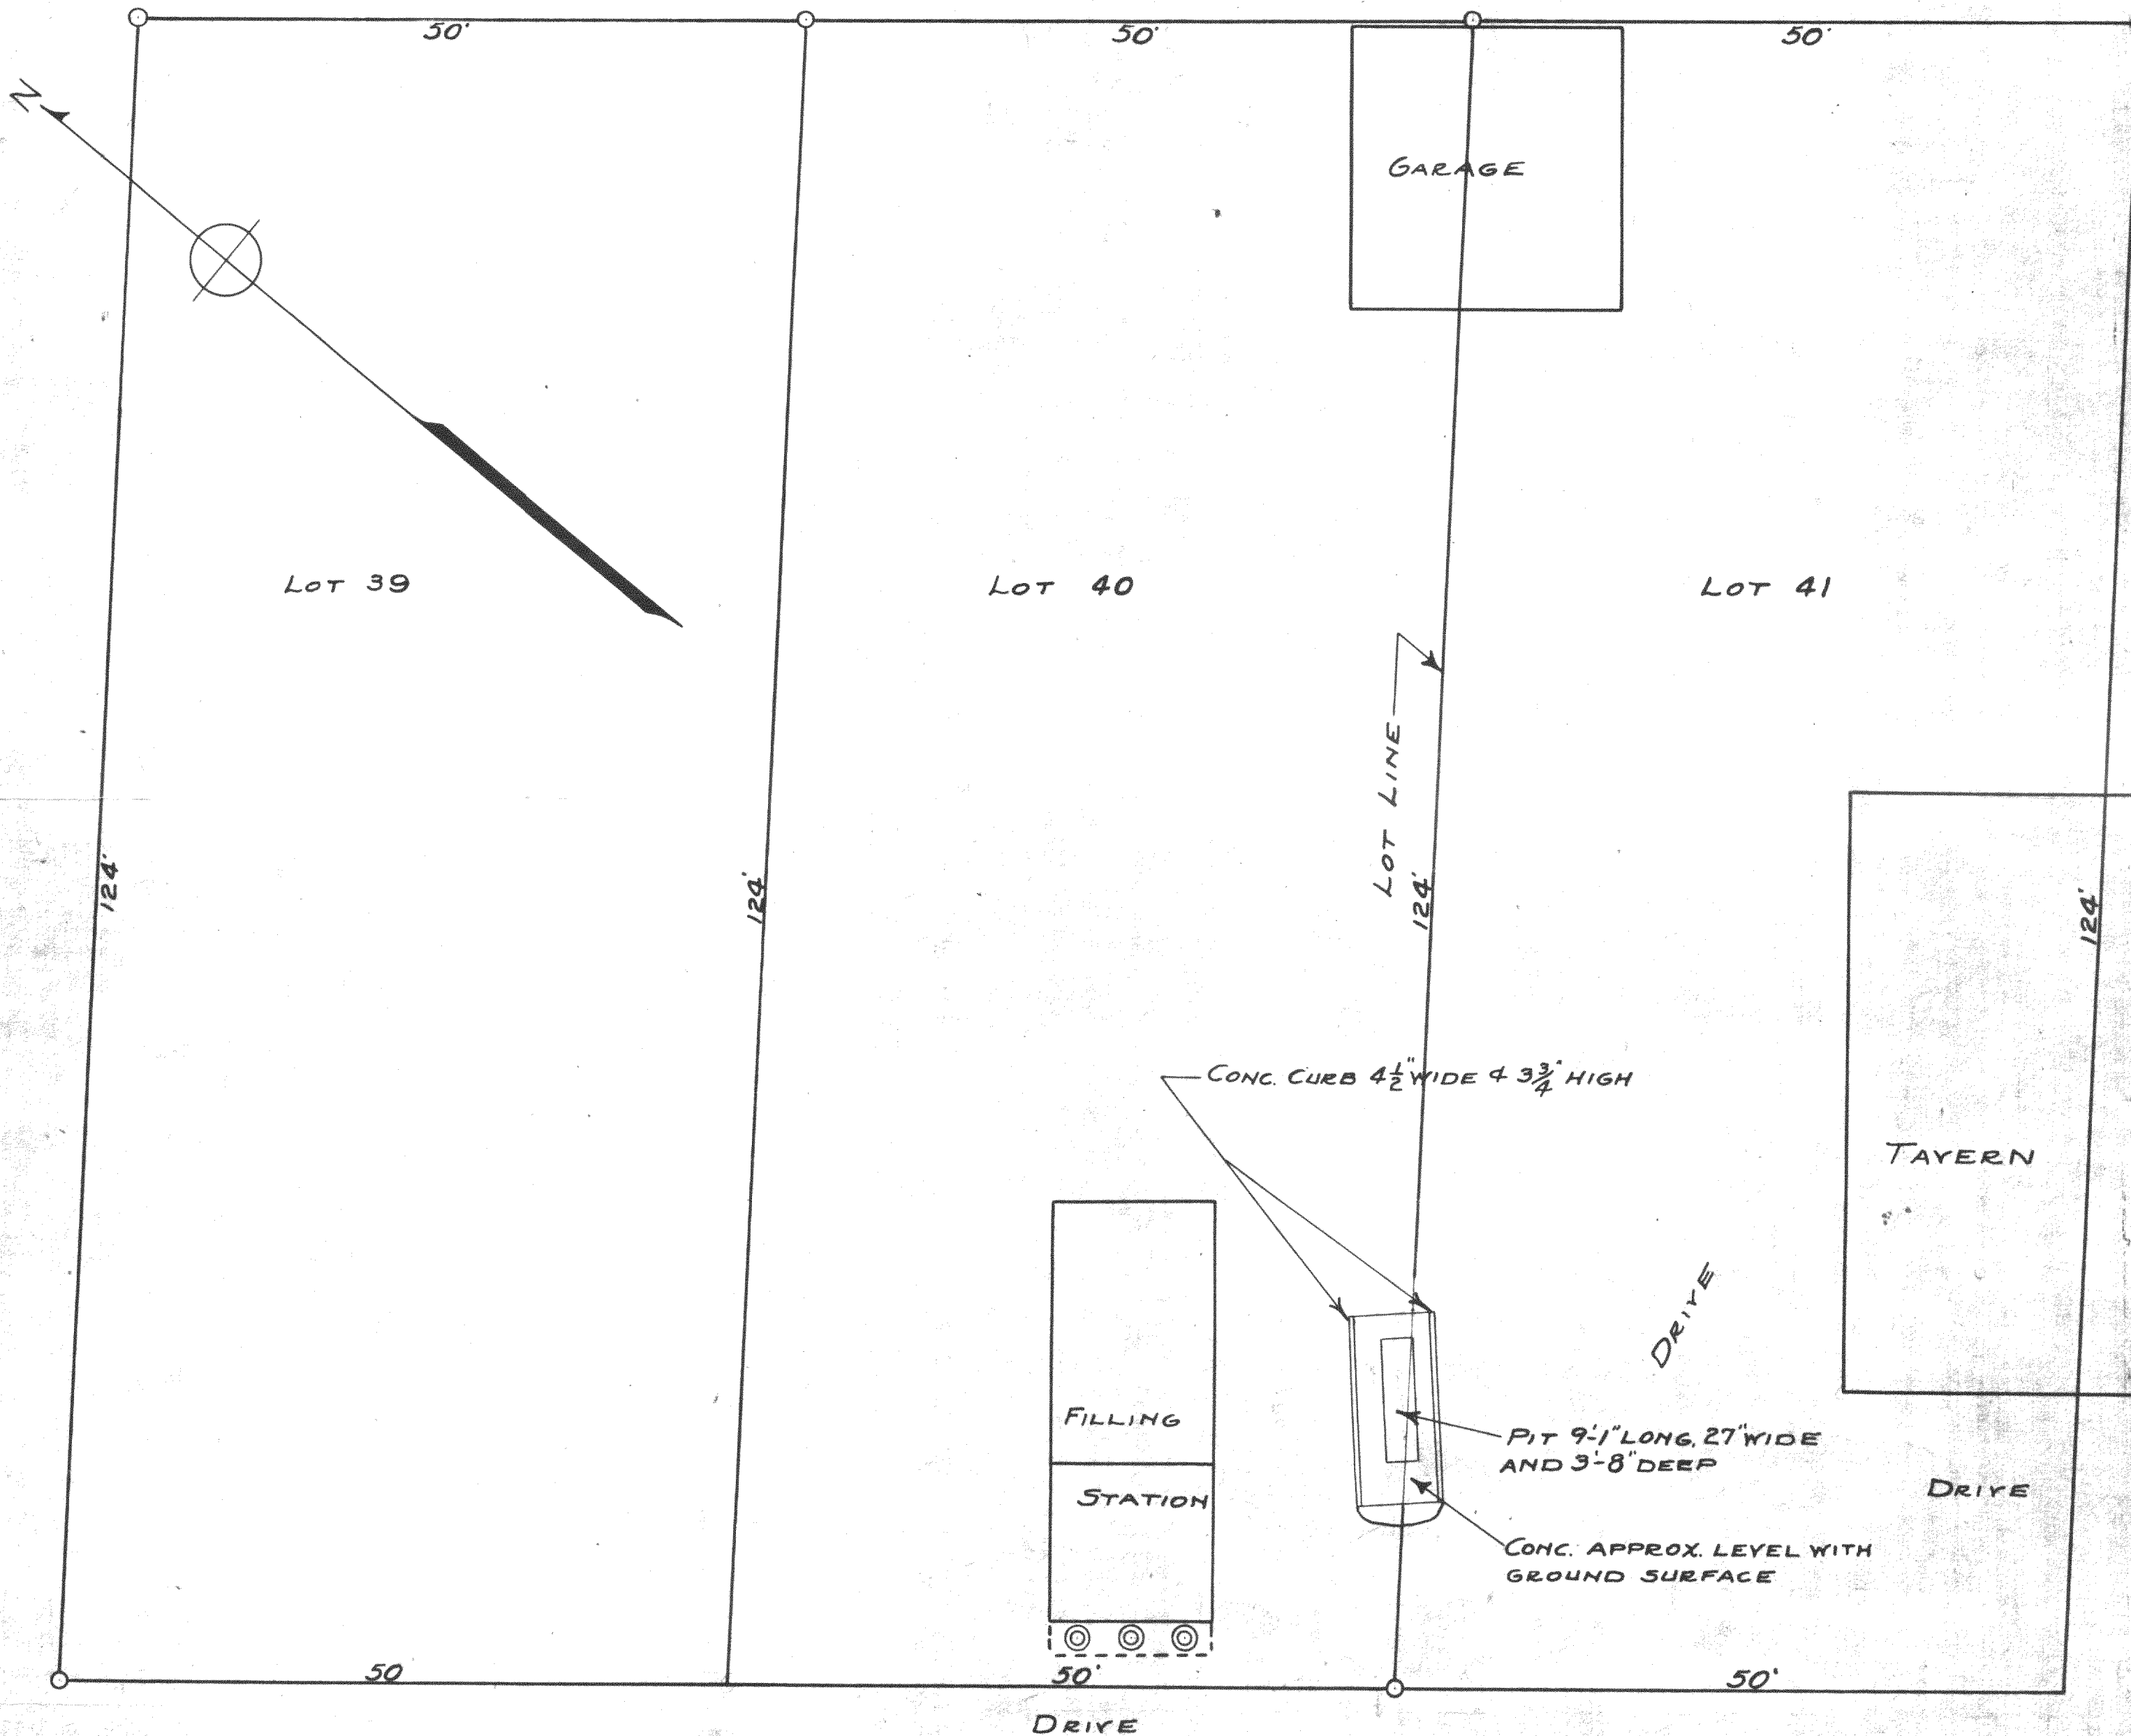

PLAT OF SURVEY OF LOTS 39, 40 AND 41 OF
 BLOCK 2 OF 3RD ADDITION TO INLET OAKS SUBD.
 T2N R16E OF WALWORTH COUNTY TO SHOW IMPROVEMENTS ON
 THE LOT LINE BETWEEN LOTS 40 AND 41.
 SCALE 1"=10'
 JULY 7, 1939

Floyd L. Jensen
 COUNTY SURVEYOR

FIN 3-52
 11 53

CENTER LINE OF CONCRETE
 ROAD

216-30