


ABELL SURVEYING & MAPPING

1140 SEQUOIA STREET • DELAVAN, WISCONSIN 53115
262-728-6737



N

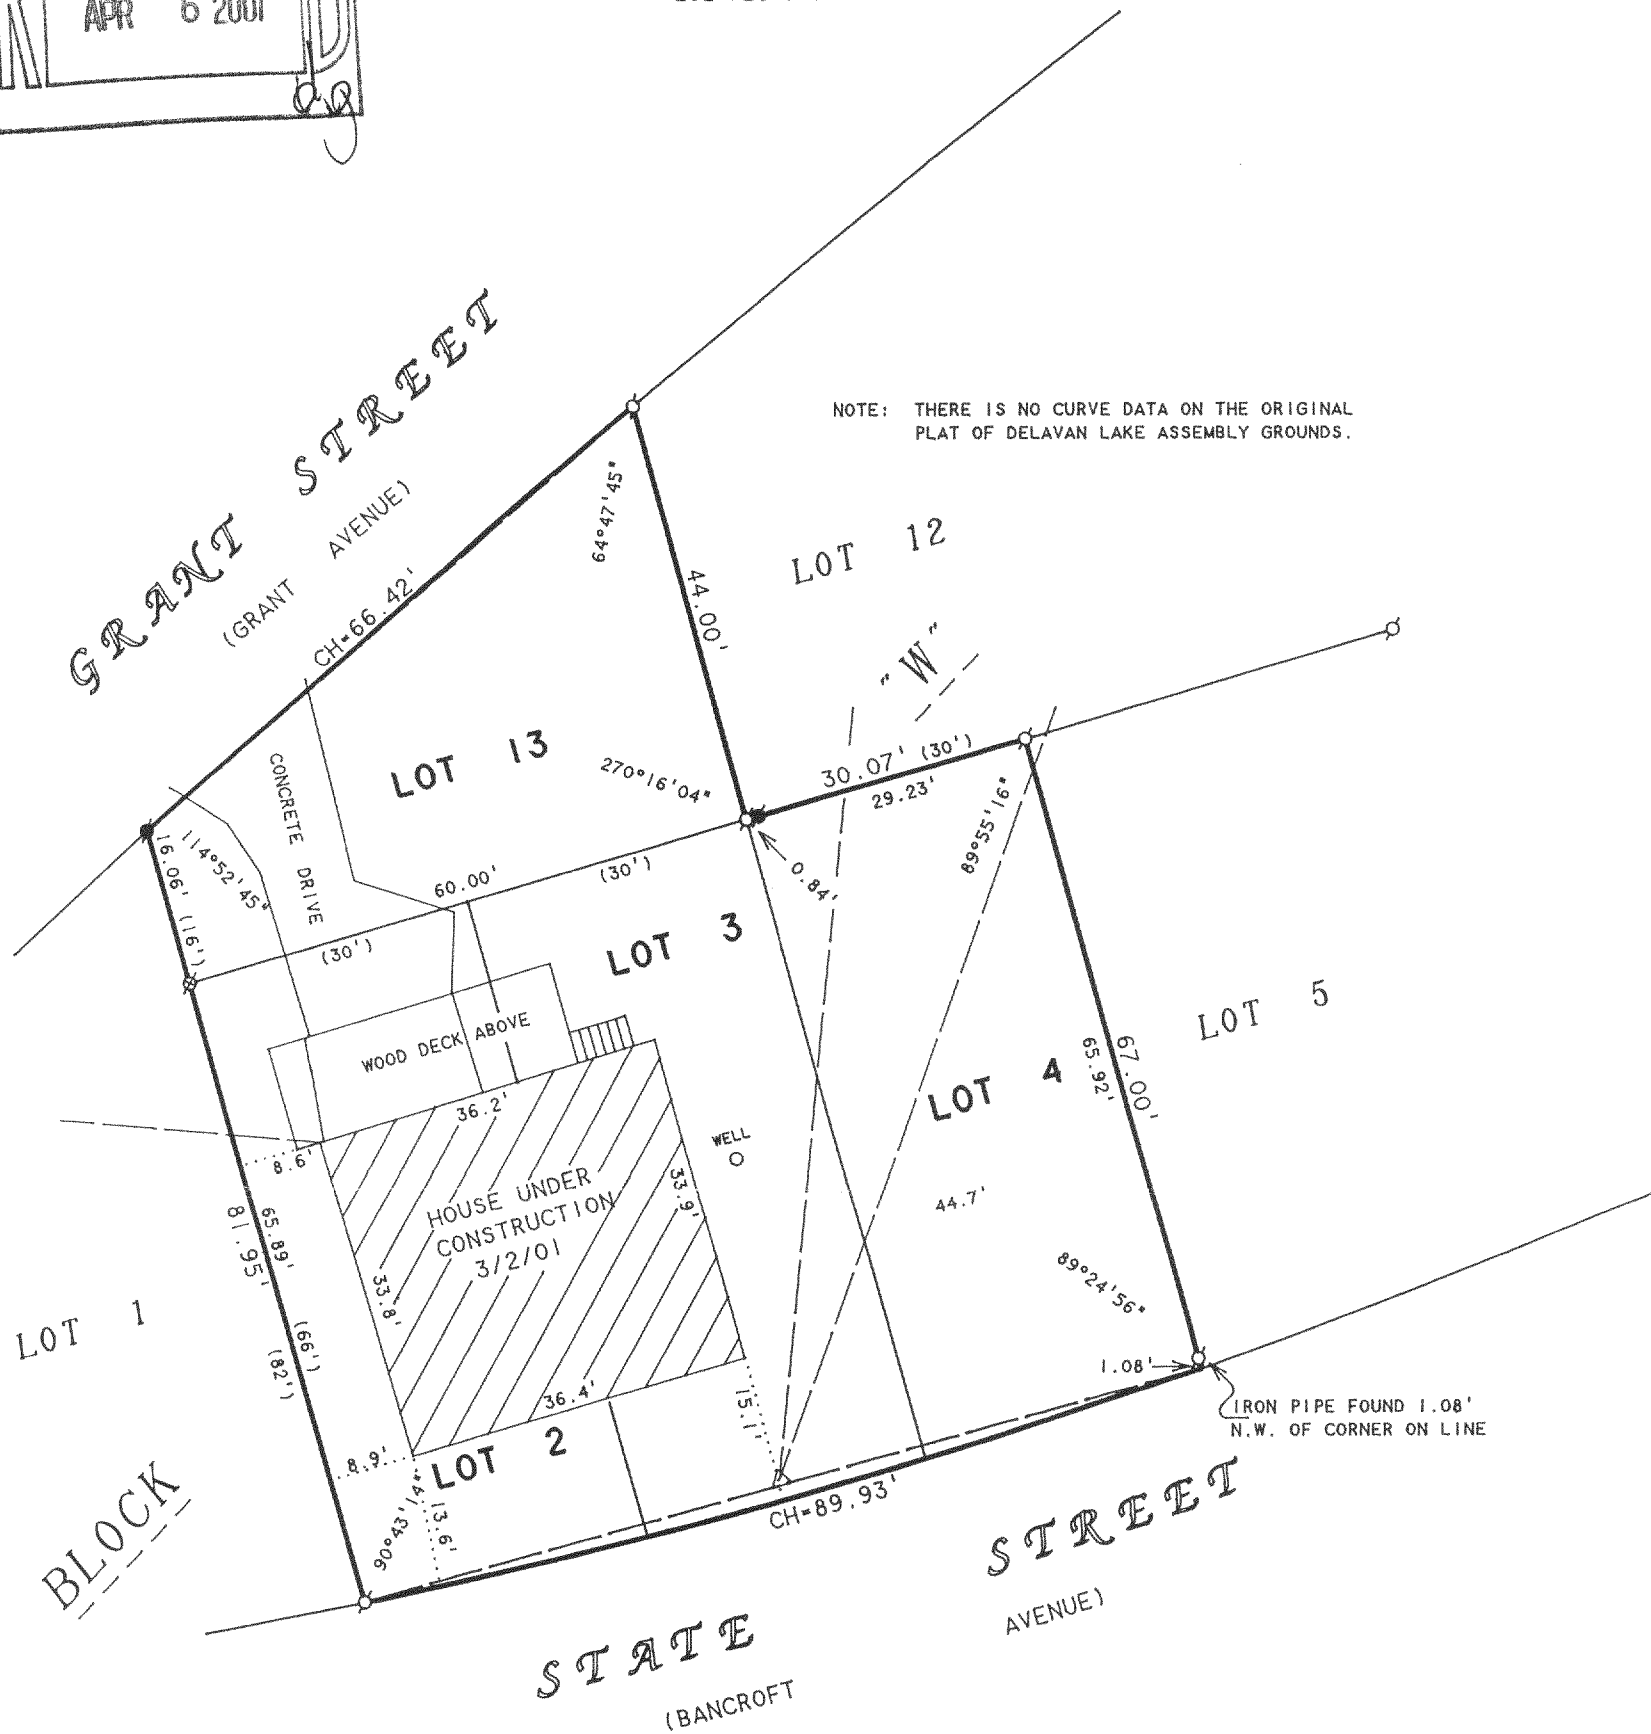

SCALE 1"=20'

LEGEND

- - IRON PIPE FOUND
- - IRON ROD FOUND
- ⊗ - SPIKE FOUND
- △ - UTILITY POLE
- - OVERHEAD UTILITY LINES
- () - RECORDED AS

ORDERED BY: DOROTHY O'CONNOR
12334 S. SPRUCE COURT
PALOS HEIGHTS, IL 60463

REVISED: MARCH 2, 2001 TO SHOW HOUSE
UNDER CONSTRUCTION.

PLAT OF SURVEY OF

LOTS 2-4 AND LOT 13, BLOCK "W", DELAVAN LAKE
ASSEMBLY GROUNDS, LOCATED IN T2N, R16E,
WALWORTH COUNTY, WISCONSIN.

I, DAVID F. ABELL, DO HEREBY CERTIFY THAT I HAVE SURVEYED THE PROPERTY HEREON
DESCRIBED ACCORDING TO THE OFFICIAL RECORDS AND THAT THE PLAT HEREON IS A
CORRECT REPRESENTATION OF THE PROPERTY LINES TO THE BEST OF MY KNOWLEDGE AND
BELIEF.

David F. Abell

DAVID F. ABELL
WISCONSIN REGISTERED LAND SURVEYOR, S-1596

May 31, 2000

DATE: May 31, 2000 JOB NUMBER - 00074A
NOTE: THIS IS NOT A CERTIFIED COPY UNLESS SEALED.

FDLA-208A

216-3009