

LEGEND

- 3/4" IRON PIPE FOUND
- 3/4" IRON ROD FOUND
- ▲ TRAVERSE POINT
- ⊠ TV AERIAL
- ⊙ GAS METER
- ⊥ WELL
- ⊙ SEPTIC COVER
- ☐ MAIL BOX

(132.00') RECORDED DISTANCES


PLAT OF SURVEY

404 NEGLAY STREET, DELAVAN, WISCONSIN.


LOT 4, BLOCK 1 OF INLET OAKS SUBDIVISION NO. 3, BEING PART OF SECTION 22, TOWNSHIP 2 NORTH, RANGE 16 EAST, IN THE TOWN OF DELAVAN, WALWORTH COUNTY, WISCONSIN.

SAID LANDS CONTAIN 6992 SQUARE FEET AS MEASURED.


OWNER: CLINT GINNER

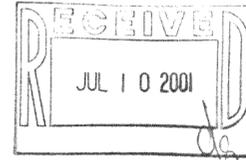

NOTES: BEARINGS ARE BASED ON THE NORTH LINE OF NEGLAY STREET, ASSUMED TO BEAR: S 89°55'00"W.

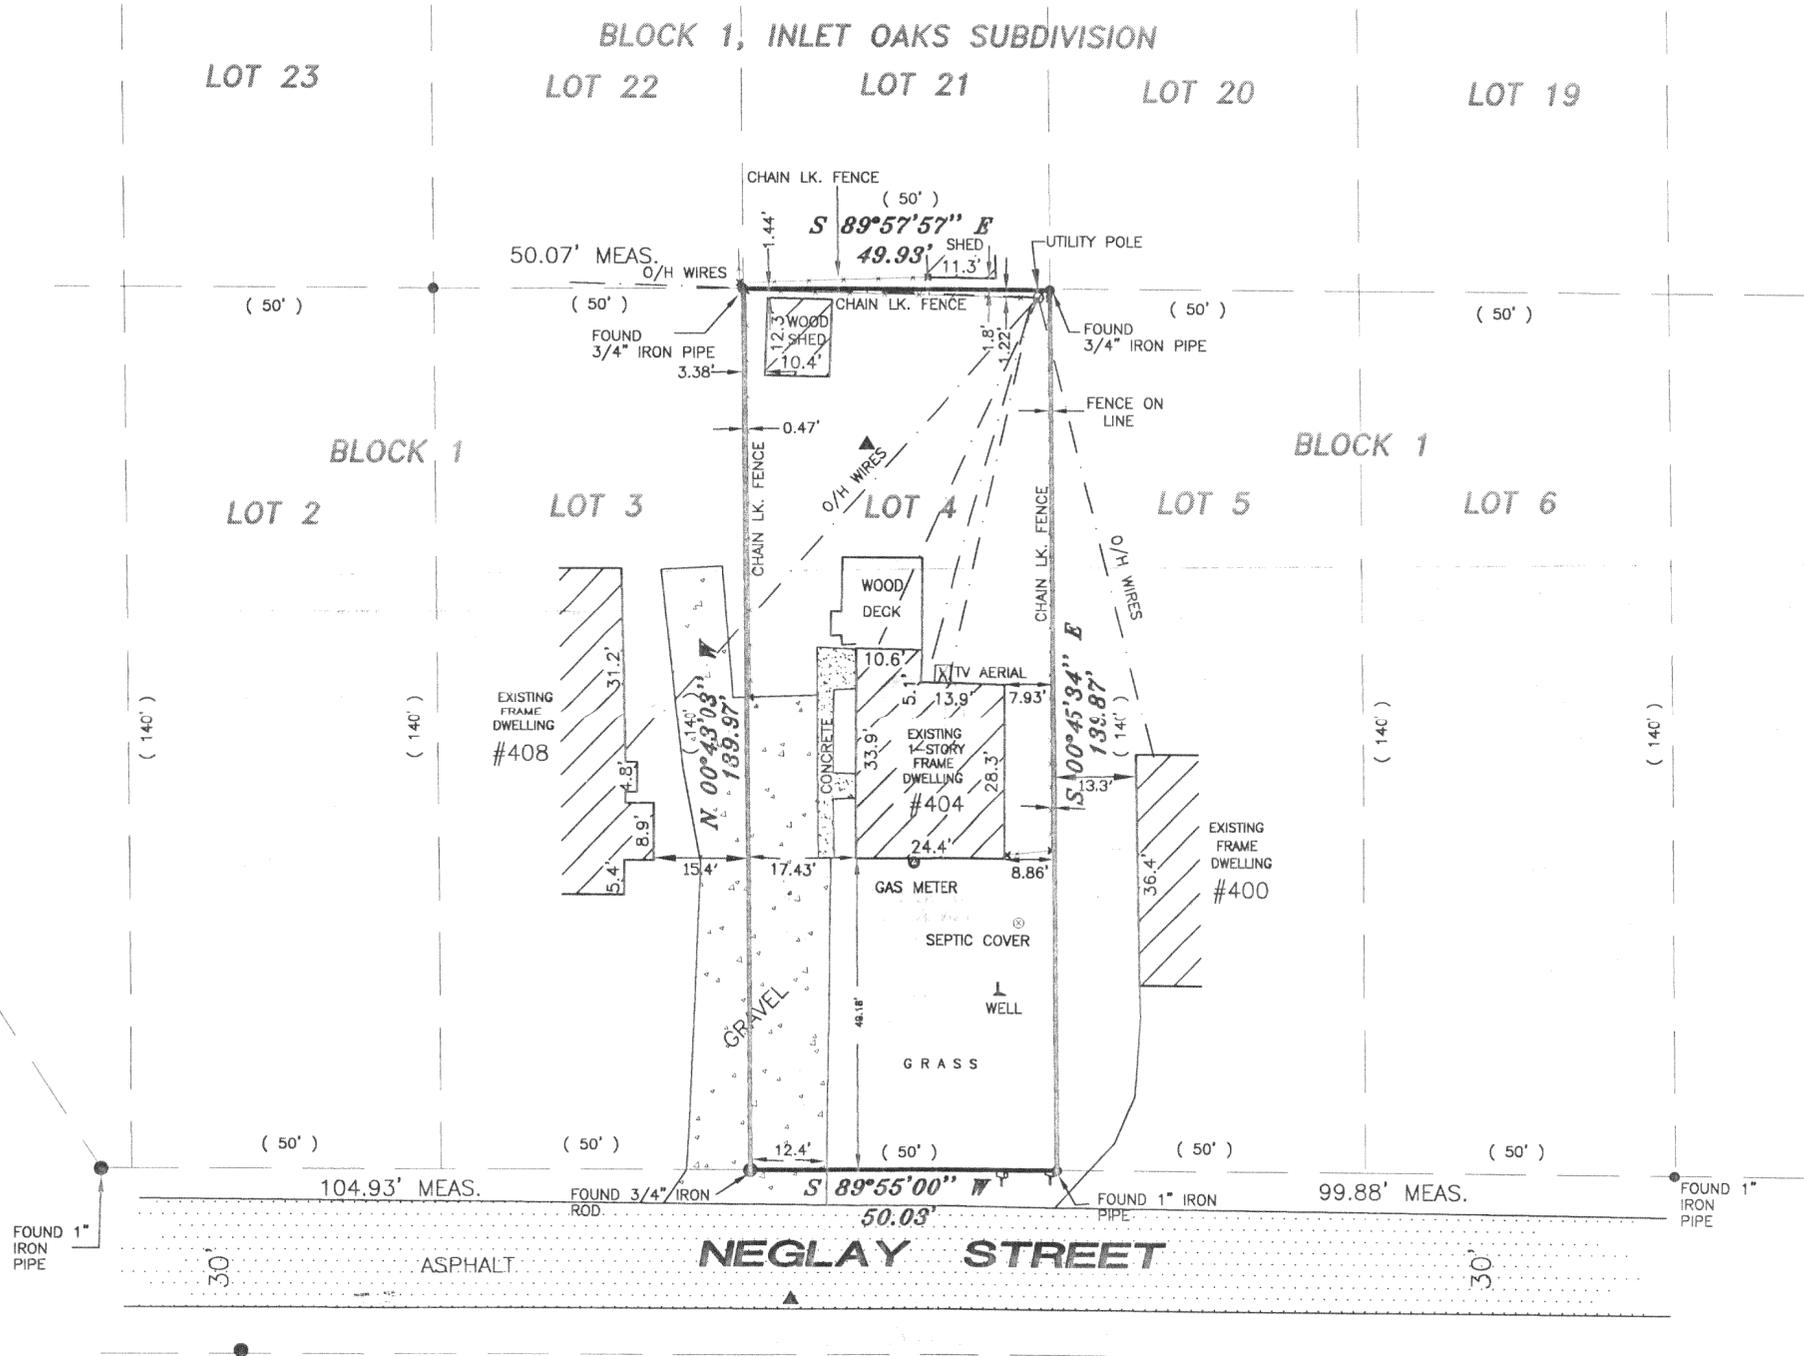

I Certify that I have surveyed the above described property (Property), and the above map is correct to the best of my professional knowledge and belief and shows the size and location of the Property, its exterior boundaries, the location and dimensions of all visible structures thereon, boundary fences, apparent easements and roadways and visible encroachments, if any. This survey is made for the exclusive use of the present owners of the Property, and also those who purchase, mortgage, or guarantee the title thereto, within one (1) year from date hereof.

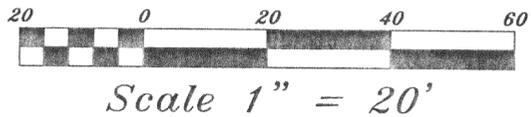

Eric R. Sturm
 May 20, 2001
 ERIC R. STURM, RLS, PLS
 MANAGING MEMBER OF:
 EASTERN SURVEYING & MAPPING, LLC
 REGISTERED WISCONSIN LAND SURVEYOR S-2309