


ABELL SURVEYING & MAPPING

1140 SEQUOIA STREET • DELAVAN, WISCONSIN 53115
262-728-6737

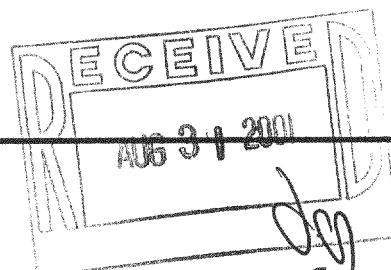

N

SCALE 1"=30'

LEGEND

- Ø - IRON PIPE FOUND
- - 1" DIA. IRON PIPE SET
- MH ⊗ - MANHOLE COVER
- CP - CONCRETE PORCH
- () - RECORDED AS
- 941|9 - SPOT ELEVATION

DELANAN LAKE

ELEVATION OF DELAVAN LAKE = 927.91'
FLOOD PLAIN FOR DELAVAN LAKE = 929'

LOT 3

TAX PARCEL FHA-4

LOT 2

TAX PARCEL FHA-5

TAX PARCEL FHA-5A

WELLO
0.46 ACRES ±

GARAGE

SOUTH SHORE DRIVE

THE FLOOD PLAIN FOR DELAVAN LAKE
OF 929' DOES NOT EXTEND ABOVE THE
BANK OF THE LAKE SHORE.

NOTE: BEARINGS ARE REFERENCED TO
EXISTING SURVEY RECORDS.

PLAT OF SURVEY OF

A parcel of land located in Lot 3 of Harrington Subdivision in Sec. 27, T 2
N, R 16 E Walworth County, Wisconsin, described as follows, to-wit:
Beginning at the most S'yly corner of said Lot 3; thence NE'yly along the
SE'yly line of said Lot 3, 90.00 ft; thence NW'yly parallel with the SW'yly
line of said Lot 3 to the shore of Delavan Lake; thence SW'yly along the
shore of Delavan Lake 90.00 ft to the most W'yly corner of said Lot 3; thence
SE'yly along the SW'yly line of said Lot 3 to the place of beginning.

I HEREBY CERTIFY THAT I HAVE SURVEYED THE ABOVE DESCRIBED PROPERTY AND THAT THE
ABOVE MAP IS A TRUE REPRESENTATION THEREOF AND SHOWS THE SIZE AND LOCATION OF
THE PROPERTY, ITS EXTERIOR BOUNDARIES, THE LOCATION OF ALL VISIBLE STRUCTURES
AND DIMENSIONS OF ALL PRINCIPAL BUILDINGS THEREON, BOUNDARY FENCES, APPARENT
EASEMENTS, ROADWAYS AND VISIBLE ENCROACHMENTS, IF ANY, TO THE BEST OF MY
KNOWLEDGE AND BELIEF.

ORDERED BY: CENTURY 21-SKANDIA REALTY
822 E. GENEVA STREET
DELAVAN, WI 53115

THIS SURVEY IS MADE FOR THE USE OF THE PRESENT OWNERS OF THE PROPERTY, AND ALSO
THOSE WHO PURCHASE, MORTGAGE, OR GUARANTEE THE TITLE THERETO WITHIN ONE (1) YEAR
FROM DATE HEREON.

REVISED: MAY 9, 2001 TO SHOW THE FLOOD PLAIN
FOR DELAVAN LAKE AND SOME SPOT ELEVATIONS ONLY.
ORDERED BY: COOK CONSTRUCTION
2666 COUNTY ROAD "O" SOUTH
DELAVAN, WI 53115

DAVID F. ABELL
WISCONSIN REGISTERED LAND SURVEYOR, S-1596

April 4, 2000

DATE: JOB NUMBER - 00035A
NOTE: THIS IS NOT A CERTIFIED COPY UNLESS SEALED.

FHA-5A
216-3043