


BOUNDARY & TOPOGRAPHIC SURVEY

PART OF ADDITION TO WILLOW POINT PARK
SEC. 29, TOWN OF DELAVAN
WALWORTH COUNTY, WISCONSIN

SHORE YARD TAX PARCEL FWA-4
47
SHORE YARD FEIA-5B
75+

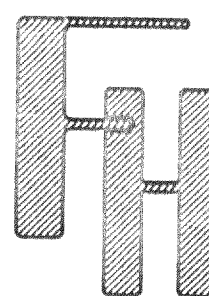

WORK ORDERED BY:
DR. T. WILLIAM COOK
3508 BROOKVIEW RD.
ROCKFORD, IL 61107

FARRIS, HANSEN & ASSOCIATES, INC.
ENGINEERING - ARCHITECTURE - SURVEYING
7 RIDGWAY COURT P.O. BOX 437
ELKHORN, WISCONSIN 53121
OFFICE: (262) 723-2098 FAX: (262) 723-5866

REVISIONS
09-08-2000
ADD ALLEY PARCEL
AND DETAIL TO WEST
09-20-2000
ADD SECOND FLOOR
ADDITION NOTE

PROJECT NO.
4468
DATE
09-08-00
SHEET NO.
1 OF 1

GARAGE

75' SETBACK FROM LAKESHORE
"NO AUTOMOBILE PARKING WITHIN
SEVENTY-FIVE FEET OF THE SHORELINE"
PER JUDGEMENT OF CIRCUIT COURT
CASE NO. 96-CV-64, FILED JULY 28, 1997

ALPINE LANE

GRAVEL ROADWAY

EXISTING RESIDENCE

BENCH MARK
NAIL FOUND EL. = 931.00'

AREA FORMERLY KNOWN AS "ALLEY" NOW PART OF
LANDS CLAIMED BY DR. T. WILLIAM COOK
PER JUDGEMENT OF CIRCUIT COURT
CASE NO. 96-CV-64, FILED JULY 28, 1997

AS BUILT FOUNDATION
EXISTING RESIDENCE

PARCEL "A"

CONCRETE PLANTER

LOT 8

LOT 9


DELAVAN LAKE

ICE EL. = 127.8' ON DATE OF TOPOGRAPHIC MAPPING (FEB. 20, 1996)

● = FOUND IRON REBAR STAKE
* = FOUND RAILROAD SPIKE
⊙ = SET NAIL IN PAVEMENT
(xxx) = RECORDED AS

MAP SCALE IN FEET 1" = 10'

RECEIVED
SEP 10 2001

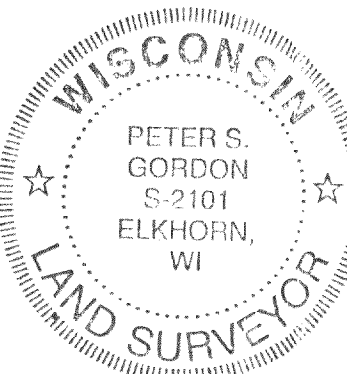

Revised
6/22/2001
to show size
& location of
foundation
as built

NOTE: COPIES OF THIS MAP TO WHICH THE FOLLOWING
CERTIFICATE WILL APPLY SHOW SURVEYOR'S ORIGINAL SEAL AND
SIGNATURE IN RED INK. COPIES BY ANY OTHER MEANS MAY HAVE
ALTERATIONS WHICH DO NOT REPRESENT THE SURVEYOR'S WORK
PRODUCT.

I HEREBY CERTIFY THAT THE ABOVE DESCRIBED PROPERTY HAS
BEEN SURVEYED UNDER MY DIRECTION AND THAT THE ABOVE MAP
IS A TRUE REPRESENTATION THEREOF AND SHOWS THE SIZE AND
LOCATION OF THE PROPERTY AND ITS EXTERIOR BOUNDARIES.
THIS SURVEY IS MADE FOR THE USE OF THE PRESENT OWNERS OF
THE PROPERTY, AND ALSO THOSE WHO PURCHASE, MORTGAGE, OR
GUARANTEE THE TITLE THERE TO WITHIN ONE YEAR FROM THE DATE
HEREOF.

DATED: 5-9-1996

PETER S. GORDON
PETER S. GORDON R.L.S. 2101

FOIA-MISC
26-5065