

PLAT OF SURVEY
WESTWARD STAR WOODS

WORK ORDERED BY -
ROGER WEST / CENTURY 21-SKANDIA
822 EAST GENEVA STREET
DELAVAN, WI 53115

FARRIS, HANSEN & ASSOCIATES, INC.
ENGINEERING - ARCHITECTURE - SURVEYING
7 RIDGWAY COURT P.O. BOX 437
ELKHORN, WISCONSIN 53121
OFFICE: (262) 723-2098 FAX: (262) 723-5866

REVISIONS


PROJECT NO.
5765
DATE
06/05/01
SHEET NO.
1 OF 1

PLAT OF SURVEY

LOTS 1 THRU 7

WESTWARD STAR WOODS

BEING PART OF GOVERNMENT LOT 1 LOCATED IN THE
NE 1/4 & SE 1/4 OF THE FRACTIONAL NE 1/4 OF
SECTION 31, TOWN 2 NORTH, RANGE 16 EAST,
TOWN OF DELAVAN, WALWORTH COUNTY, WISCONSIN

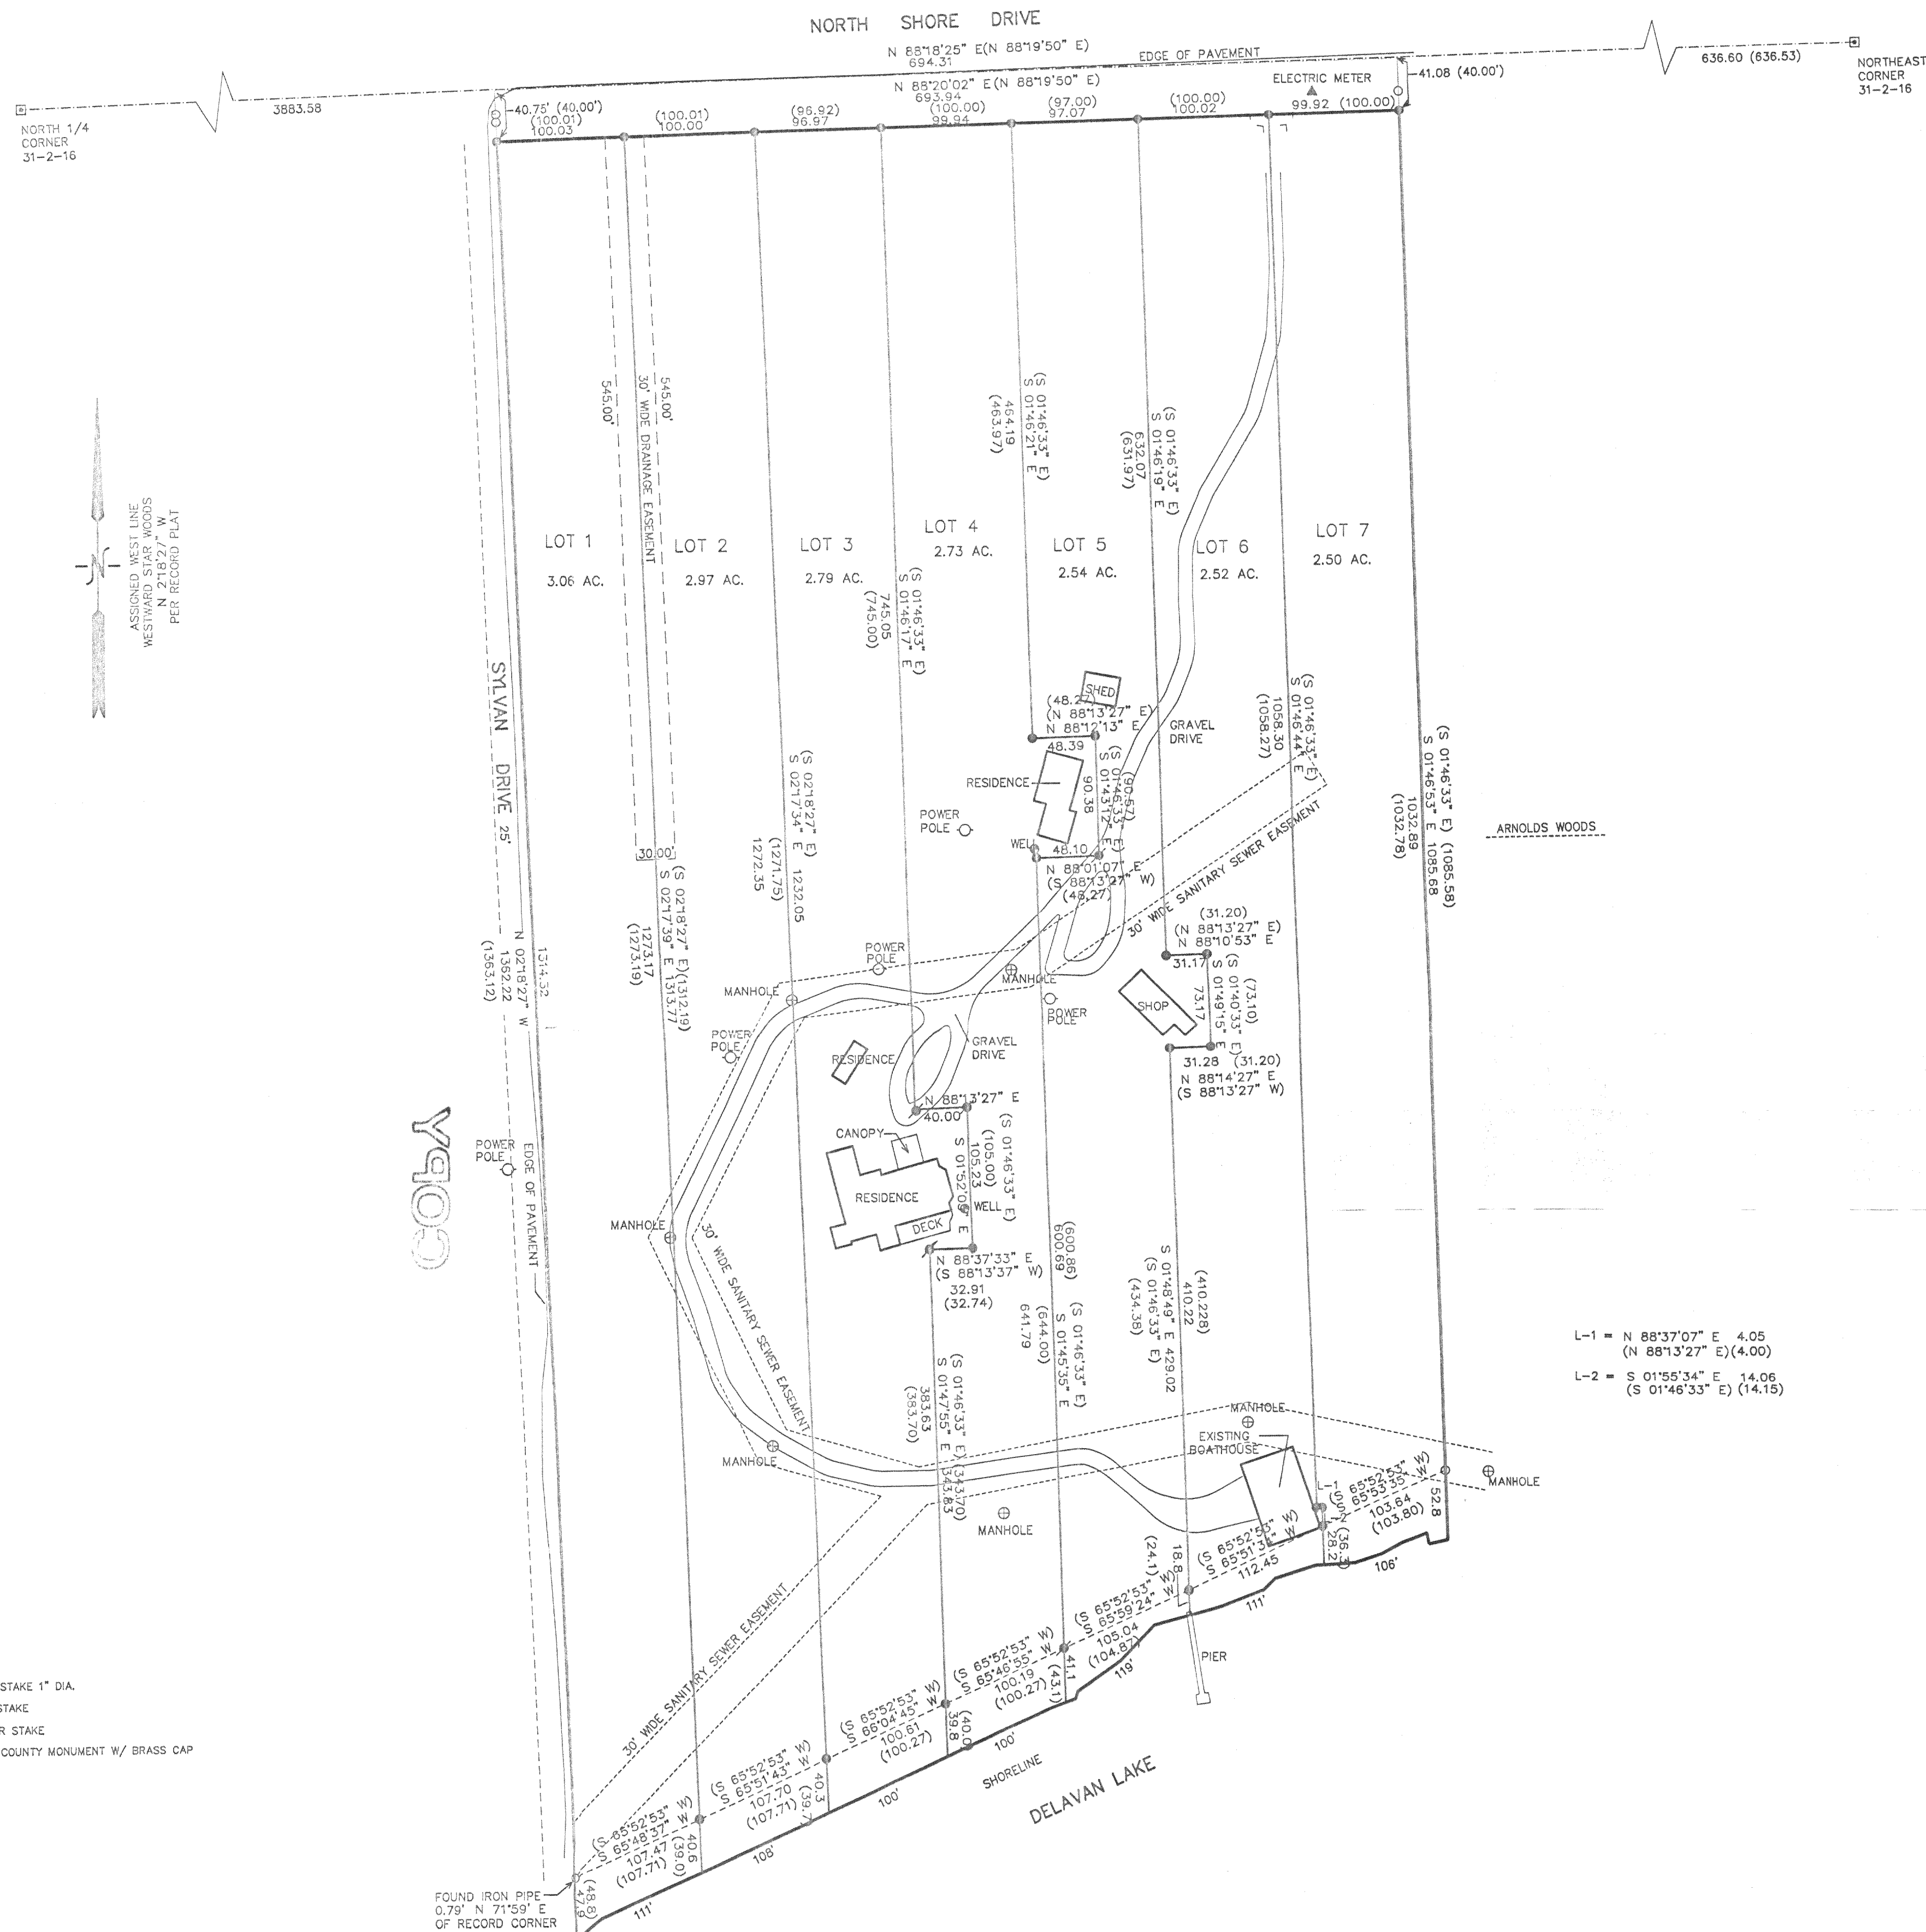


L-1 = N 88°37'07" E 4.05
(N 88°37'27" E) (4.00)
L-2 = S 01°55'34" E 14.06
(S 01°46'33" E) (14.15)

NOTE: COPIES OF THIS MAP TO WHICH THE FOLLOWING
CERTIFICATE WILL APPLY SHOW SURVEYOR'S ORIGINAL SEAL AND
SIGNATURE IN RED INK. COPIES BY ANY OTHER MEANS MAY HAVE
ALTERATIONS WHICH DO NOT REPRESENT THE SURVEYOR'S WORK
PRODUCT.

I HEREBY CERTIFY THAT THE ABOVE DESCRIBED PROPERTY HAS
BEEN SURVEYED UNDER MY DIRECTION AND THAT THE ABOVE MAP
IS A TRUE REPRESENTATION THEREOF AND SHOWS THE SIZE AND
LOCATION OF THE PROPERTY AND ITS EXTERIOR BOUNDARIES.
THIS SURVEY IS MADE FOR THE USE OF THE PRESENT OWNERS OF
THE PROPERTY, AND ALSO THOSE WHO PURCHASE, MORTGAGE, OR
GUARANTEE THE TITLE THERETO WITHIN ONE YEAR FROM THE DATE
HEREOF.

DATED: June 12, 2001

PETER S. GORDON R.L.S. 2101

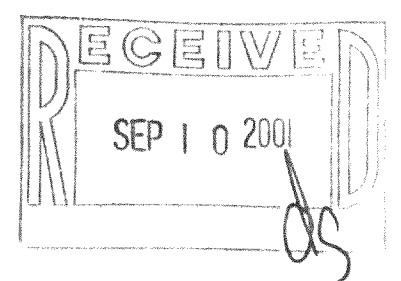

Fwe-1
Fwe-2
Fwe-3
Fwe-4
Fwe-5
Fwe-6
Fwe-7

216-3067