
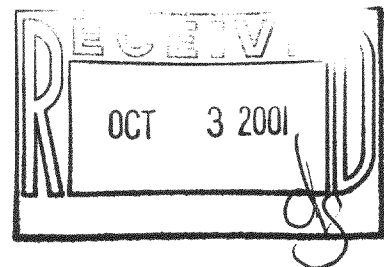


Township 2 North, Range 16 East of the 4th Principal Meridian, Town of Delavan,
Walworth County, Wisconsin.

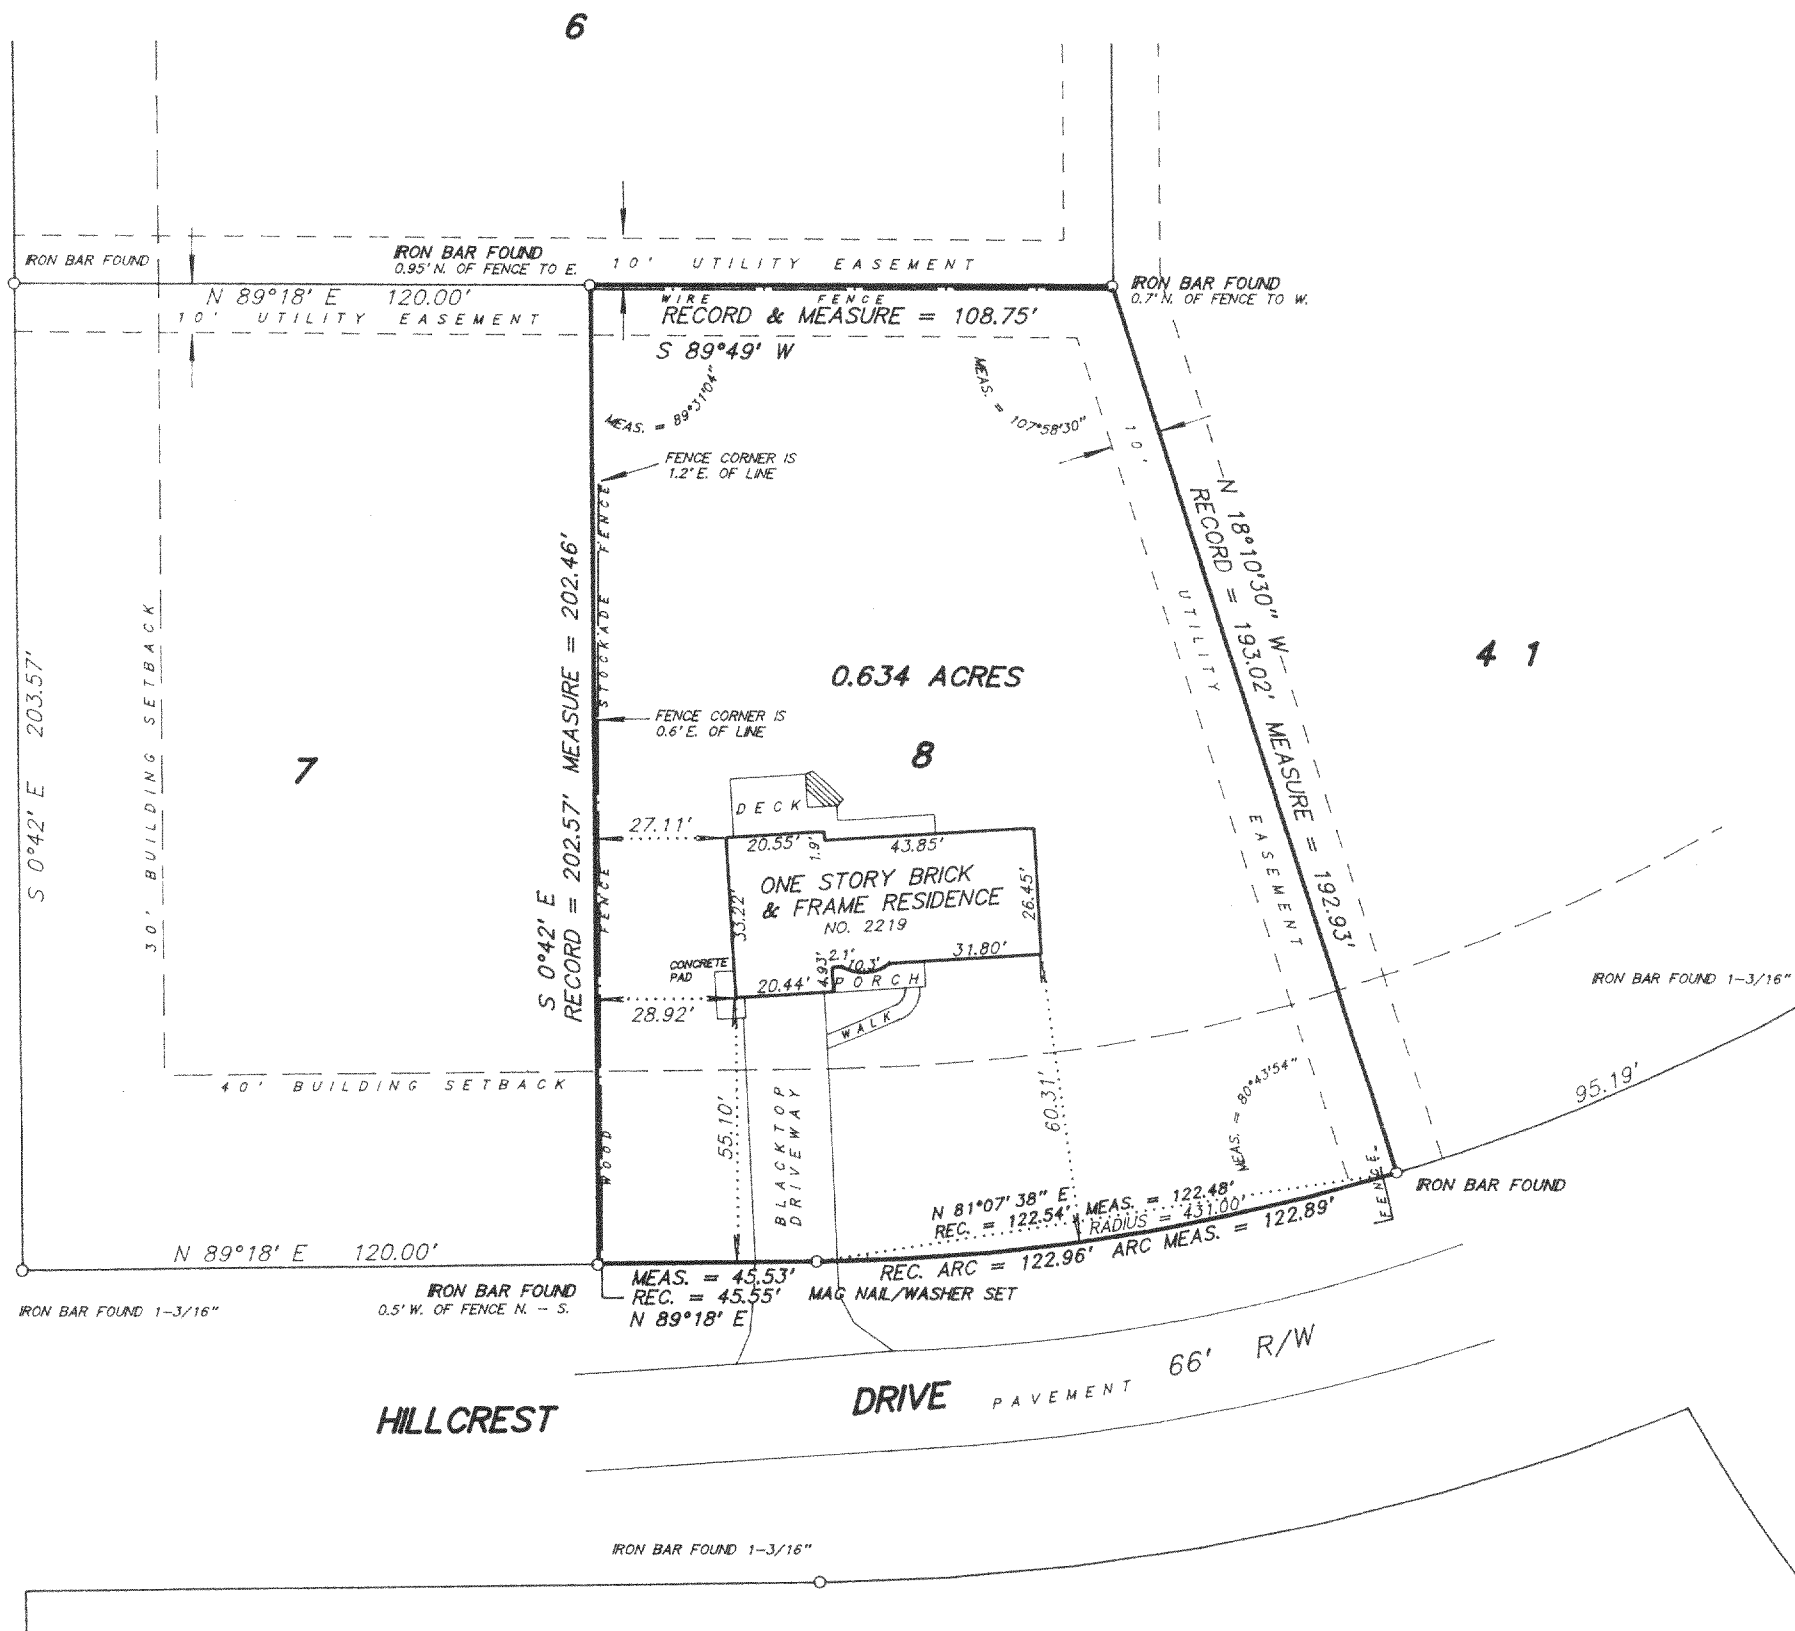

SCALE 1 inch = 40 feet

ORDERED BY C. Gene Simons / REMAX - Geneva Realty

JOB NO. 0 1 1 2 4

I hereby certify that I have surveyed the above described property and the plat is a true representation thereof and shows the size and location of property, its exterior boundaries, the location and dimensions of all visible structures thereon, boundary fences, apparent easements and roadways and visible encroachments, if any.

This survey is made for the exclusive use of the present owners of the property and also those who purchase, mortgage, or guarantee the title thereto within year from the date hereof.

Dated at Bassett, Wisconsin this _____ day of _____ 20

Mark A. Bolender
Wisconsin Registered Land Surveyor S - 1784

FOMS-8
216-3071