

# ABELL SURVEYING & MAPPING

1140 SEQUOIA STREET • DELAVAN, WISCONSIN 53115  
262-728-6737



SCALE 1"=20'

### LEGEND

- ⊙ - IRON PIPE FOUND
- ⊙ - IRON ROD WITH CAP FOUND
- 930.13 - GROUND ELEVATION
- - OVERHEAD UTILITY LINES
- ( ) - RECORDED AS

### PLAT OF SURVEY OF

LOT 6, BLOCK 1, SOUTH SHORE MANOR, LOCATED  
IN T2N, R16E, WALWORTH COUNTY, WISCONSIN.

I, DAVID F. ABELL, DO HEREBY CERTIFY THAT I HAVE SURVEYED THE PROPERTY HEREON DESCRIBED ACCORDING TO THE OFFICIAL RECORDS AND THAT THE PLAT HEREON IS A CORRECT REPRESENTATION OF THE PROPERTY LINES TO THE BEST OF MY KNOWLEDGE AND BELIEF.



*David F. Abell*

DAVID F. ABELL  
WISCONSIN REGISTERED LAND SURVEYOR, S-1596

November 5, 2001

DATE: November 5, 2001 JOB NUMBER - 01159  
NOTE: THIS IS NOT A CERTIFIED COPY UNLESS SEALED.

ORDERED BY: COOK CONSTRUCTION  
2666 COUNTY TRUNK "D" SOUTH  
DELAVAN, WI 53115

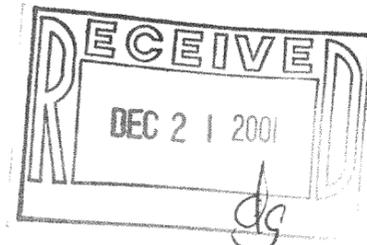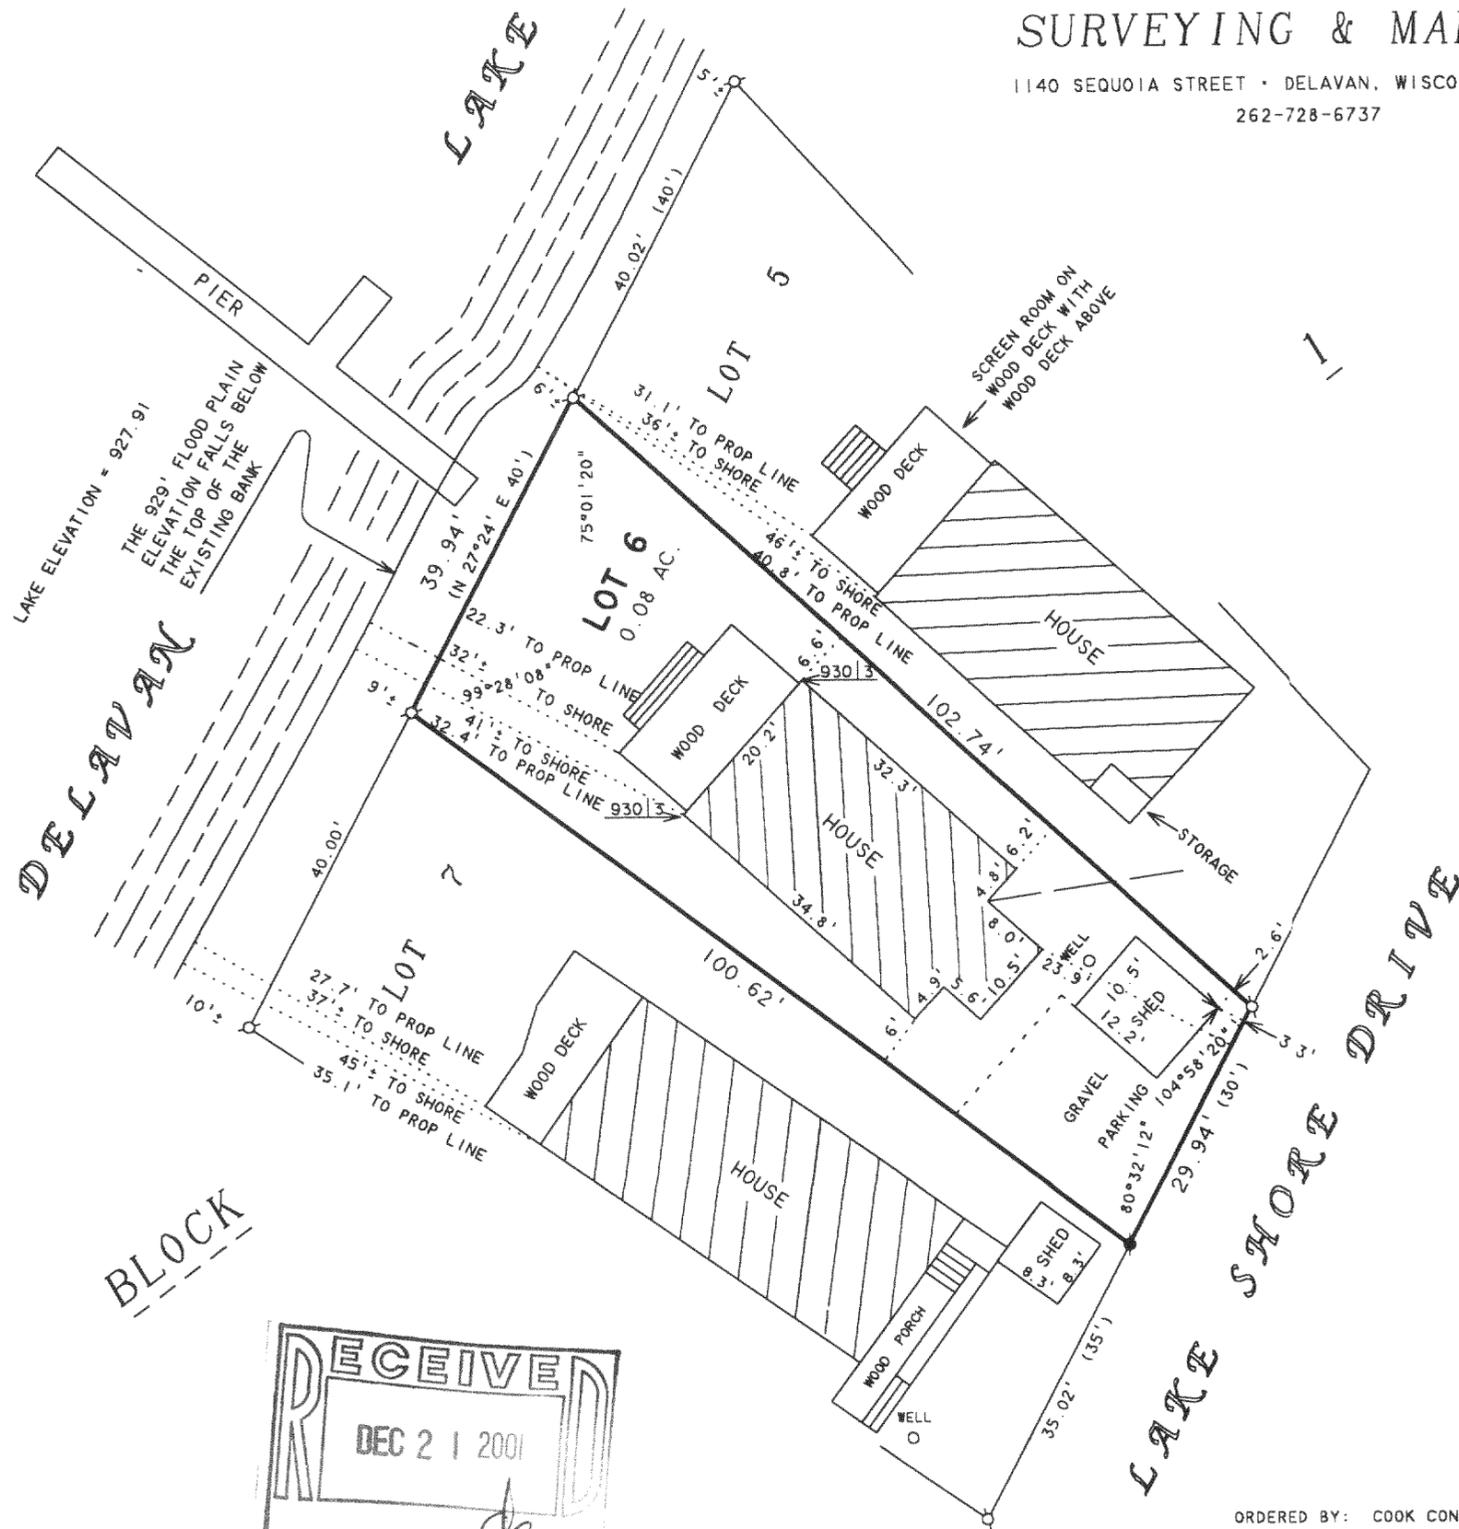

FSS-ST 216-3099