


GEORGE T. DUNHAM
SURVEYING & SUBDIVIDING
DELAVER, WISCONSIN

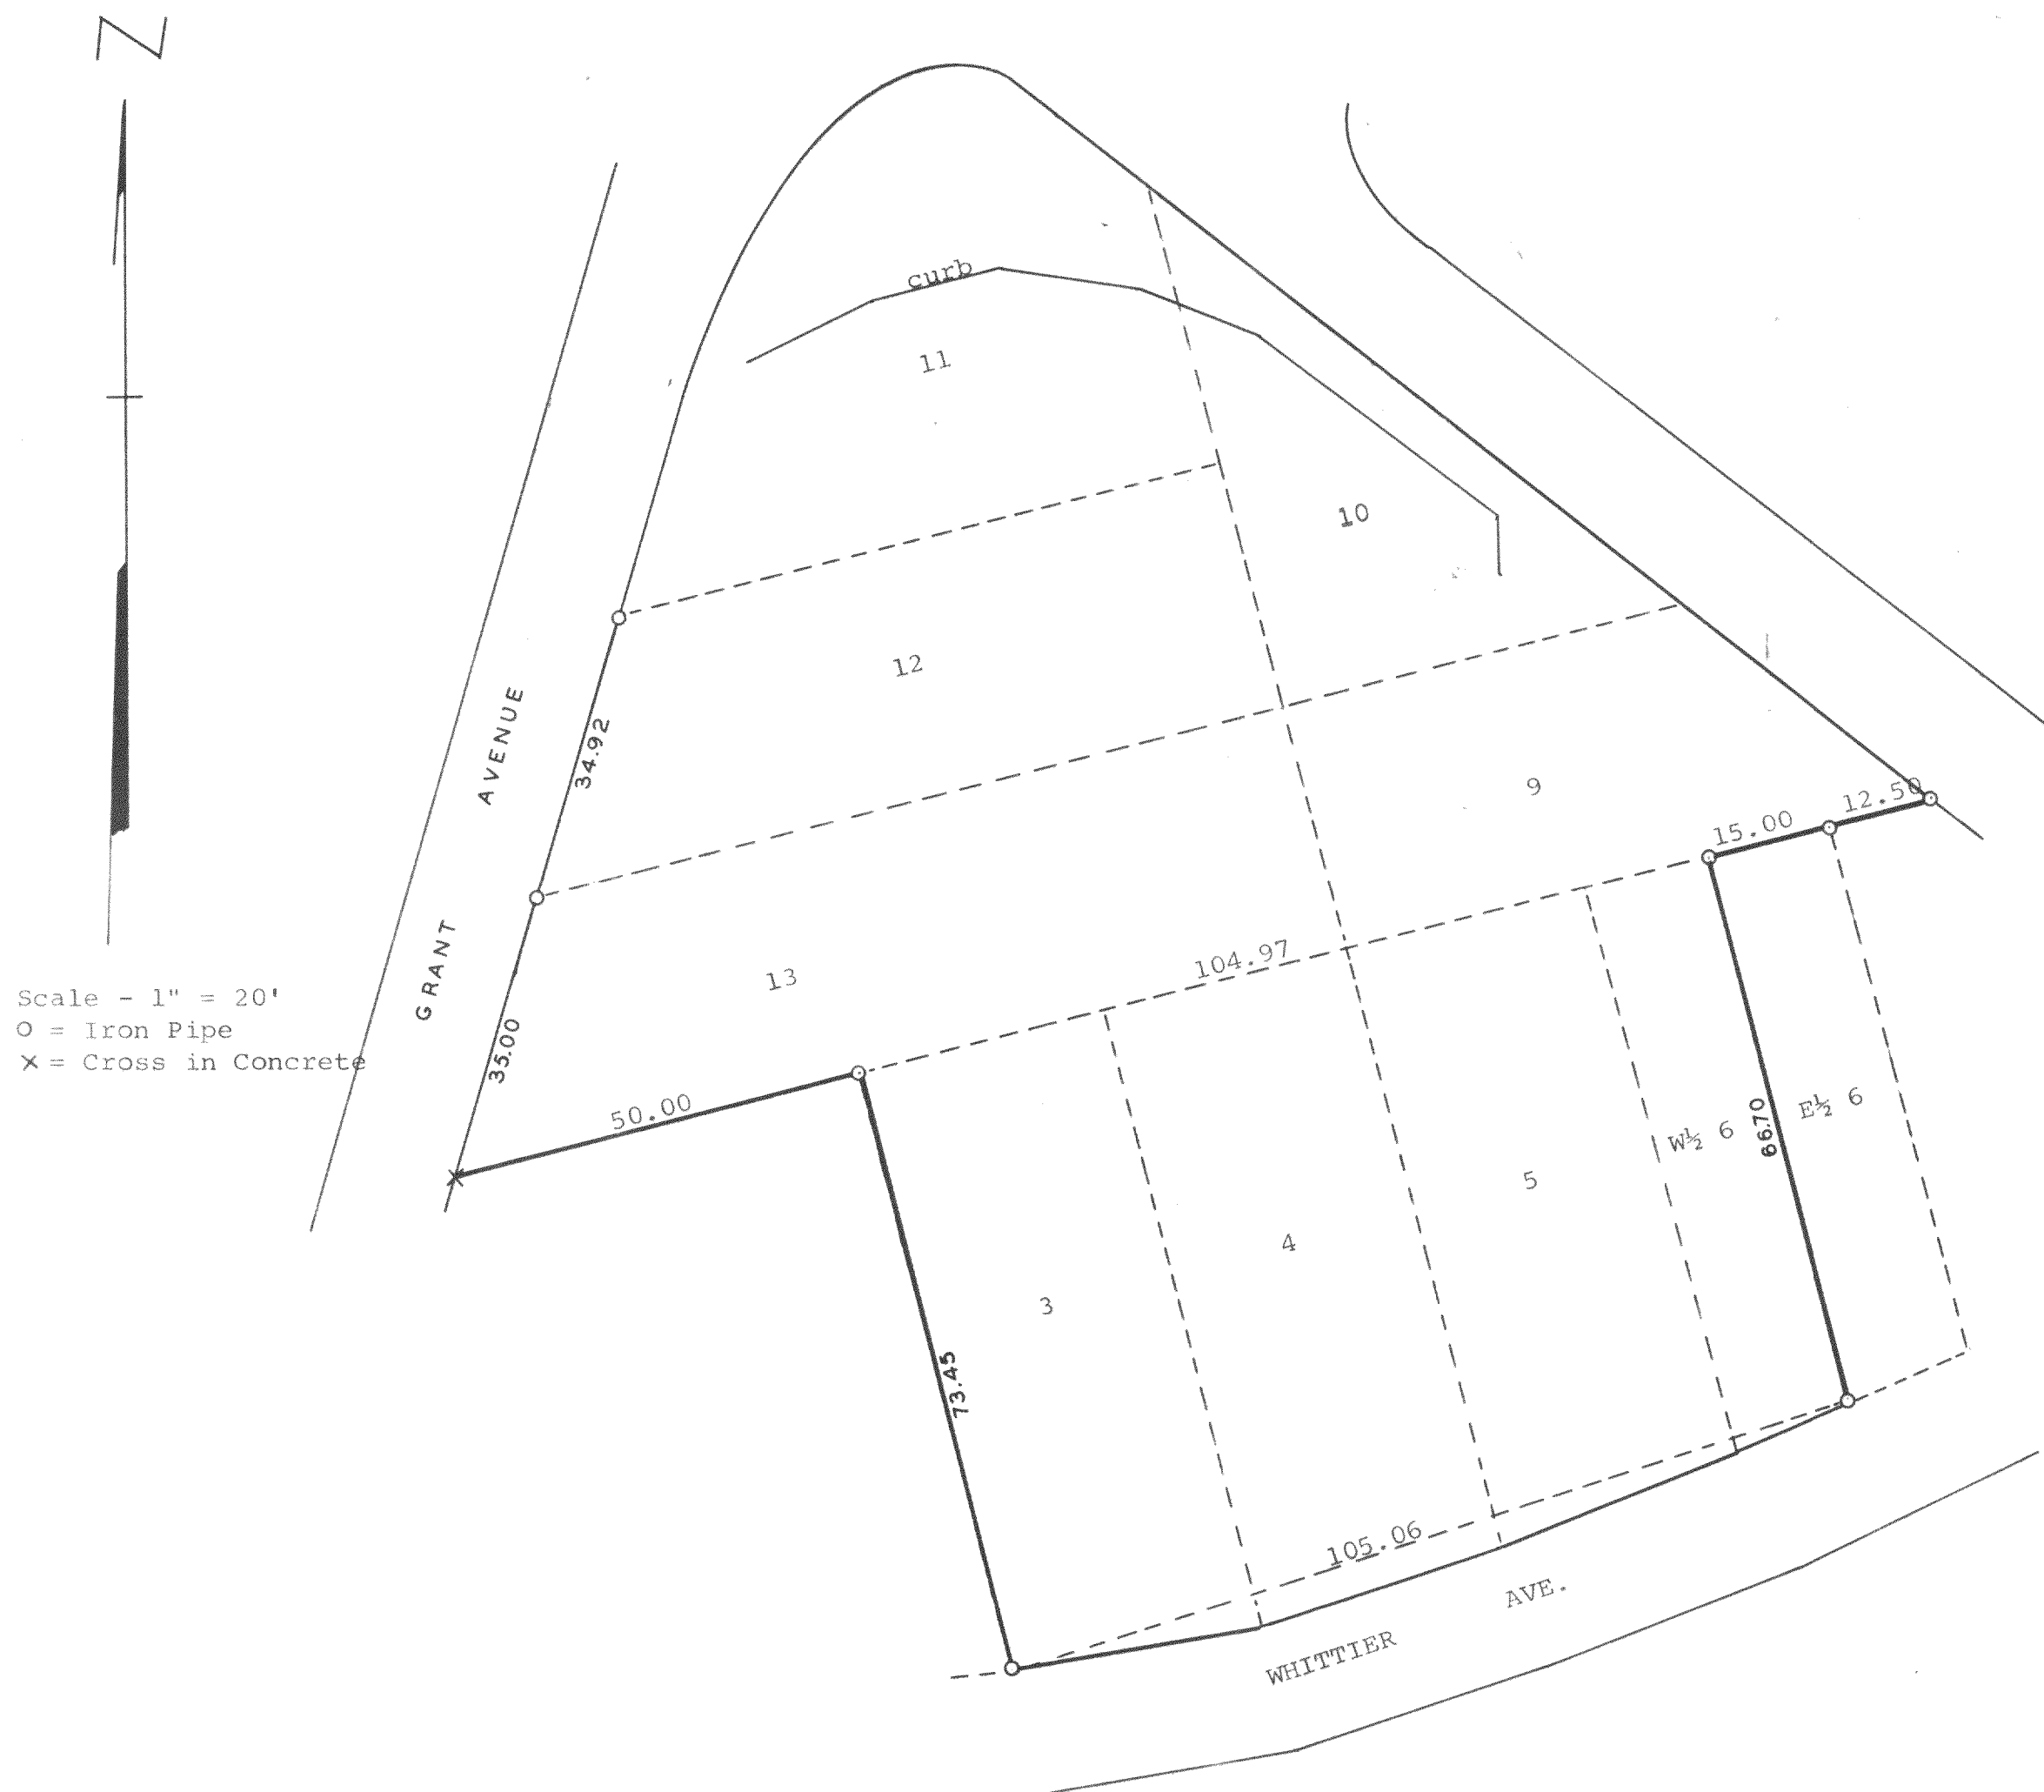

Plat of survey of Lots 3, 4, 5, West 1/2 of Lot 6, 9, 10, 11, 12, and 13 all in Block "Y" of Delavan Lake Assembly Grounds, T 2 N, R 16 E, Walworth County, Wisconsin.
May 4, 1968

George T. Dunham
George T. Dunham, Surveyor

216-311

FDLA-214, 217