

PLAT OF SURVEY

WORK ORDERED BY -
GEORGE & MARTHA COZZOLINO
1911 S. SHORE DRIVE
DELAN, WI. 53115

FARRIS, HANSEN & ASSOCIATES, INC.
Engineering, Architecture, Surveying
7 Ridgway Court P.O. Box 437
ELKHORN, WISCONSIN 53121
Office: (262) 723-2098
Fax: (262) 723-5886



REVISIONS
4/16/02 - LK
ADDED NEW
IMPROVEMENTS

PROJECT NO.
4932
DATE:
03/25/98
SHEET NO.
1 OF 1


PLAT OF SURVEY

LOT 10 OF POINT COMFORT ALSO PART OF PARK
LYING BETWEEN PLAT AND LAKE ROAD AND THAT PART
OF PARK LYING BETWEEN PLAT AND LAKE BY EXTENDING
NORTH AND SOUTH LINES

LOCATED IN SECTION 22, TOWN 2 NORTH, RANGE 16 EAST,
WALWORTH COUNTY, WISCONSIN

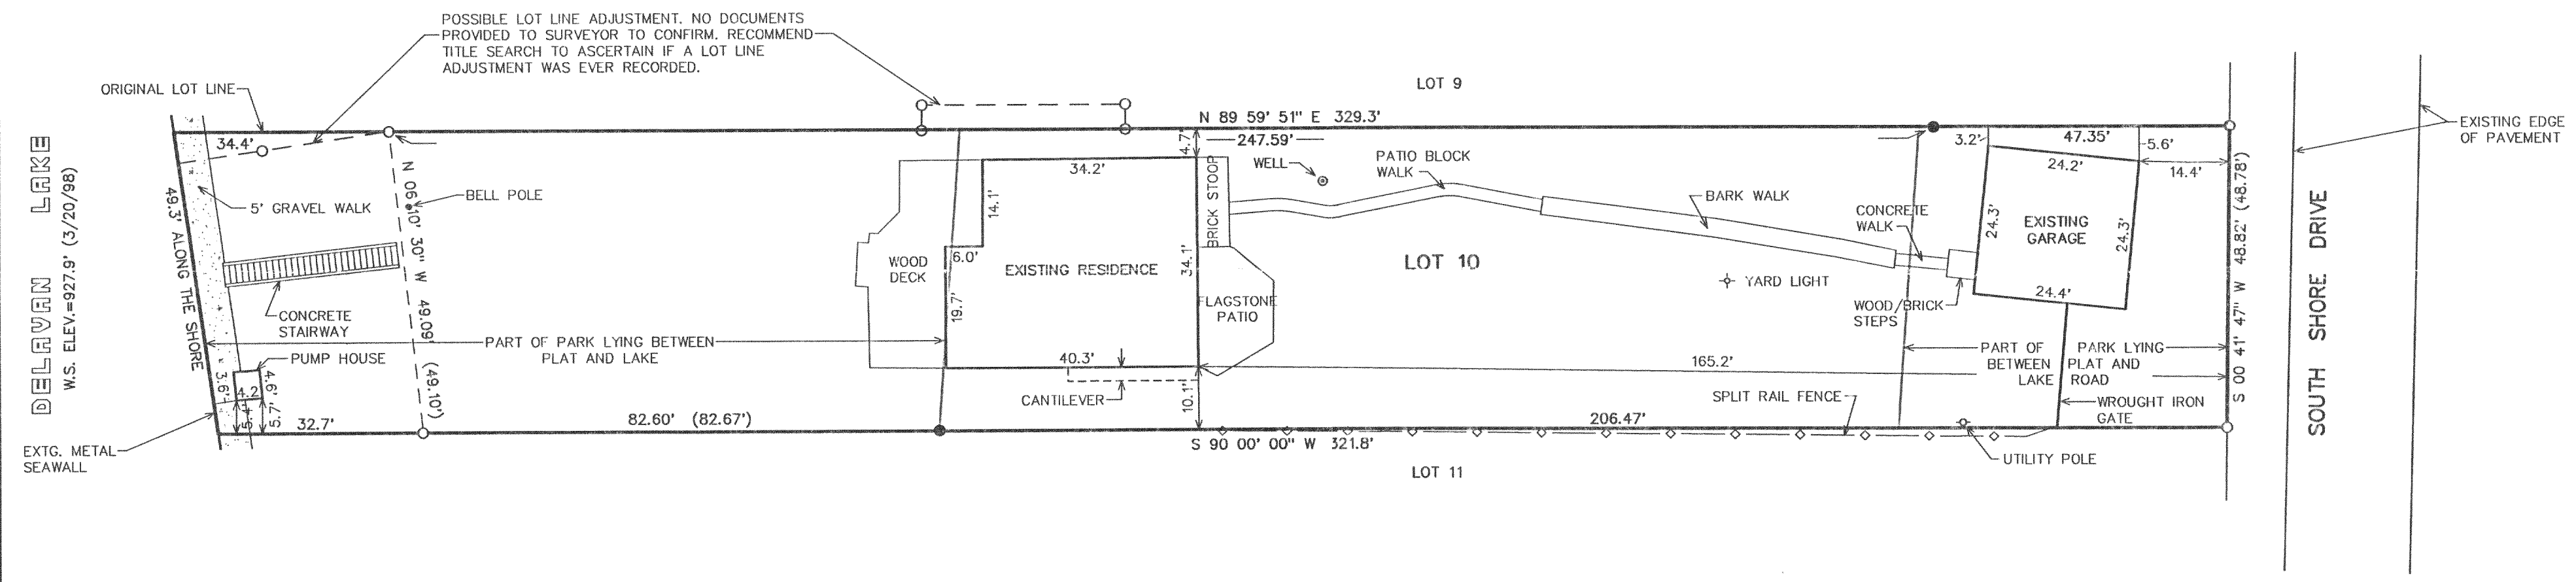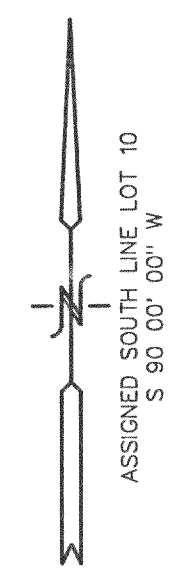

- LEGEND
- = FOUND IRON PIPE STAKE
 - = FOUND IRON REBAR STAKE
 - (XXX) = RECORDED AS

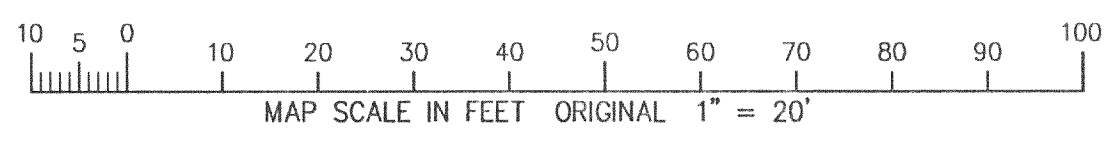


NOTE: COPIES OF THIS MAP TO WHICH THE FOLLOWING CERTIFICATE
WILL APPLY SHOW THE SURVEYOR'S ORIGINAL SEAL AND SIGNATURE
IN RED INK. COPIES BY ANY OTHER MEANS MAY HAVE ALTERATIONS
WHICH DO NOT REPRESENT THE SURVEYOR'S WORK PRODUCT.

I HEREBY CERTIFY THAT THE ABOVE DESCRIBED PROPERTY HAS BEEN
SURVEYED UNDER MY DIRECTION AND THAT THE ABOVE MAP IS A TRUE
REPRESENTATION THEREOF AND SHOWS THE SIZE AND LOCATION OF
THE PROPERTY AND ITS EXTERIOR BOUNDARIES. THIS SURVEY IS
MADE FOR THE USE OF THE PRESENT OWNERS OF THE PROPERTY, AND
ALSO THOSE WHO PURCHASE, MORTGAGE, OR GUARANTEE THE TITLE
THERE TO WITHIN ONE YEAR FROM THE DATE HEREOF.

DATED: 3/25/98 REVISED 4/16/02 TO SHOW
EXISTING IMPROVEMENTS

PETER S. GORDON R.L.S. 2101

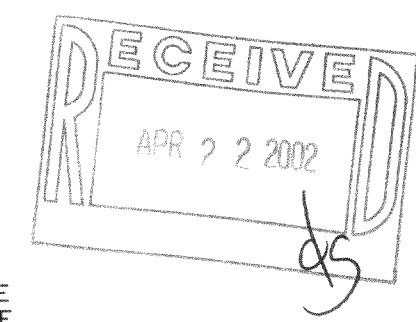

APR 16 2002

FPC-7 216-3158