


ABERNATHY and ASSOCIATES

Kenneth B. Abernathy Jr.


Wisconsin Registered Land Surveyor S-1594

W4056 BRAY RD.
ELKHORN, WI. 53121
PHONE: (262) 723-4260 (OFFICE)
(262) 723-7209 (FAX)
Email: abernathy@elknet.net

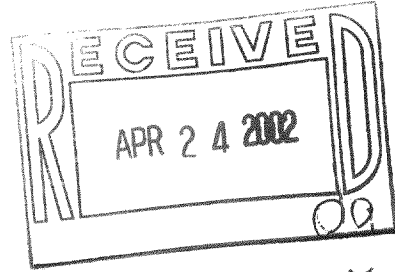

PLAT OF SURVEY

LOT 4 OF MABIE WOOD, A SUBDIVISION LOCATED IN THE
SOUTHEAST 1/4 OF SECTION 21, TOWN 2 NORTH, RANGE 16 EAST,
DELAVER TOWNSHIP, WALWORTH COUNTY, WISCONSIN.

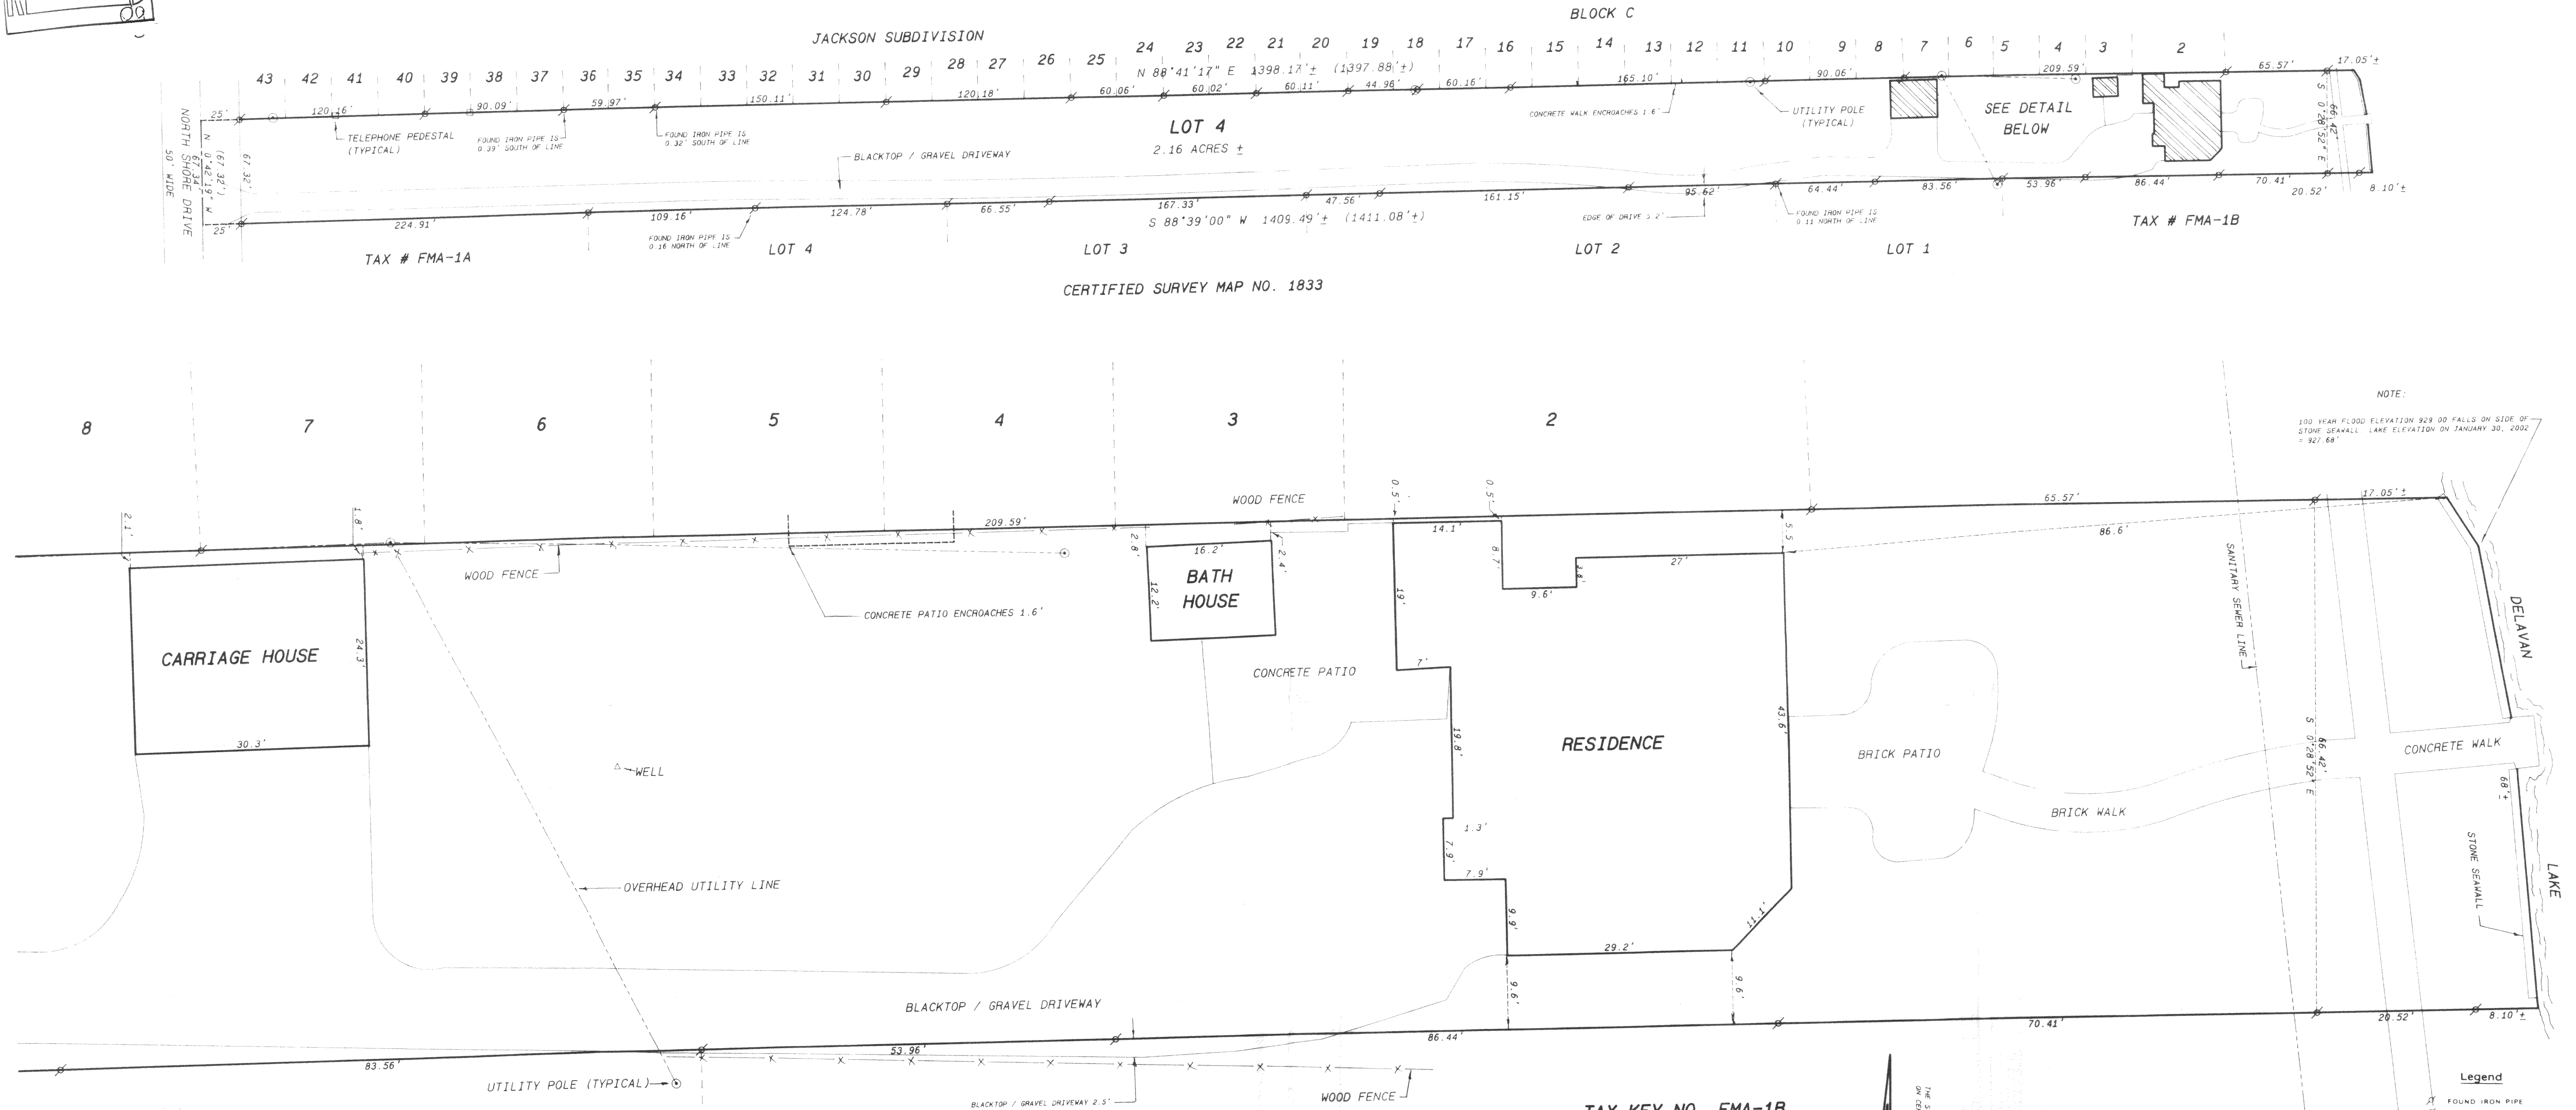


LOT 4, CERTIFIED SURVEY MAP NO. 1833

ORDERED BY: HOME DESIGN MANUFACTURING
N2002 HWY "67"
POST OFFICE BOX 527
FONTANA, WI 53125

OWNER: CHARLENE A. MEHLHAFF
P.O. BOX 22
DELAVER, WI 53115

TAX KEY NO. FMA-1B

SCALE: 1" = 50 FEET
DETAIL: 1" = 10 FEET

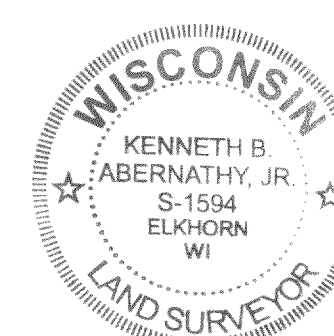

SCALE: 1" = 50 FEET

I hereby certify that the above described property has been surveyed by me or under my direction and that the above map is a true representation thereof and shows the size and location of the property, its exterior boundaries, the location of all visible structures and dimensions of all principal buildings thereon, boundary fences, apparent easements, roadways and visible encroachments, if any.

This survey is made for the use of the present owners of the property, and also those who purchase, mortgage, or guarantee the title thereto within one year from date hereof.

Kenneth B. Abernathy, Jr.
KENNETH B. ABERNATHY, JR.
WISCONSIN REGISTERED LAND SURVEYOR,
S-1594

Date: FEBRUARY 2002 Job No. 02.201