




PLAT OF SURVEY OF

PART OF LOTS 1 AND 2, OF ST. MARY'S OF DELAVAN LAKE, A SUBDIVISION LOCATED IN T2N, R16E, WALWORTH COUNTY, WISCONSIN.


NOTE: BEARINGS ARE REFERENCED TO EXISTING SURVEY RECORDS.

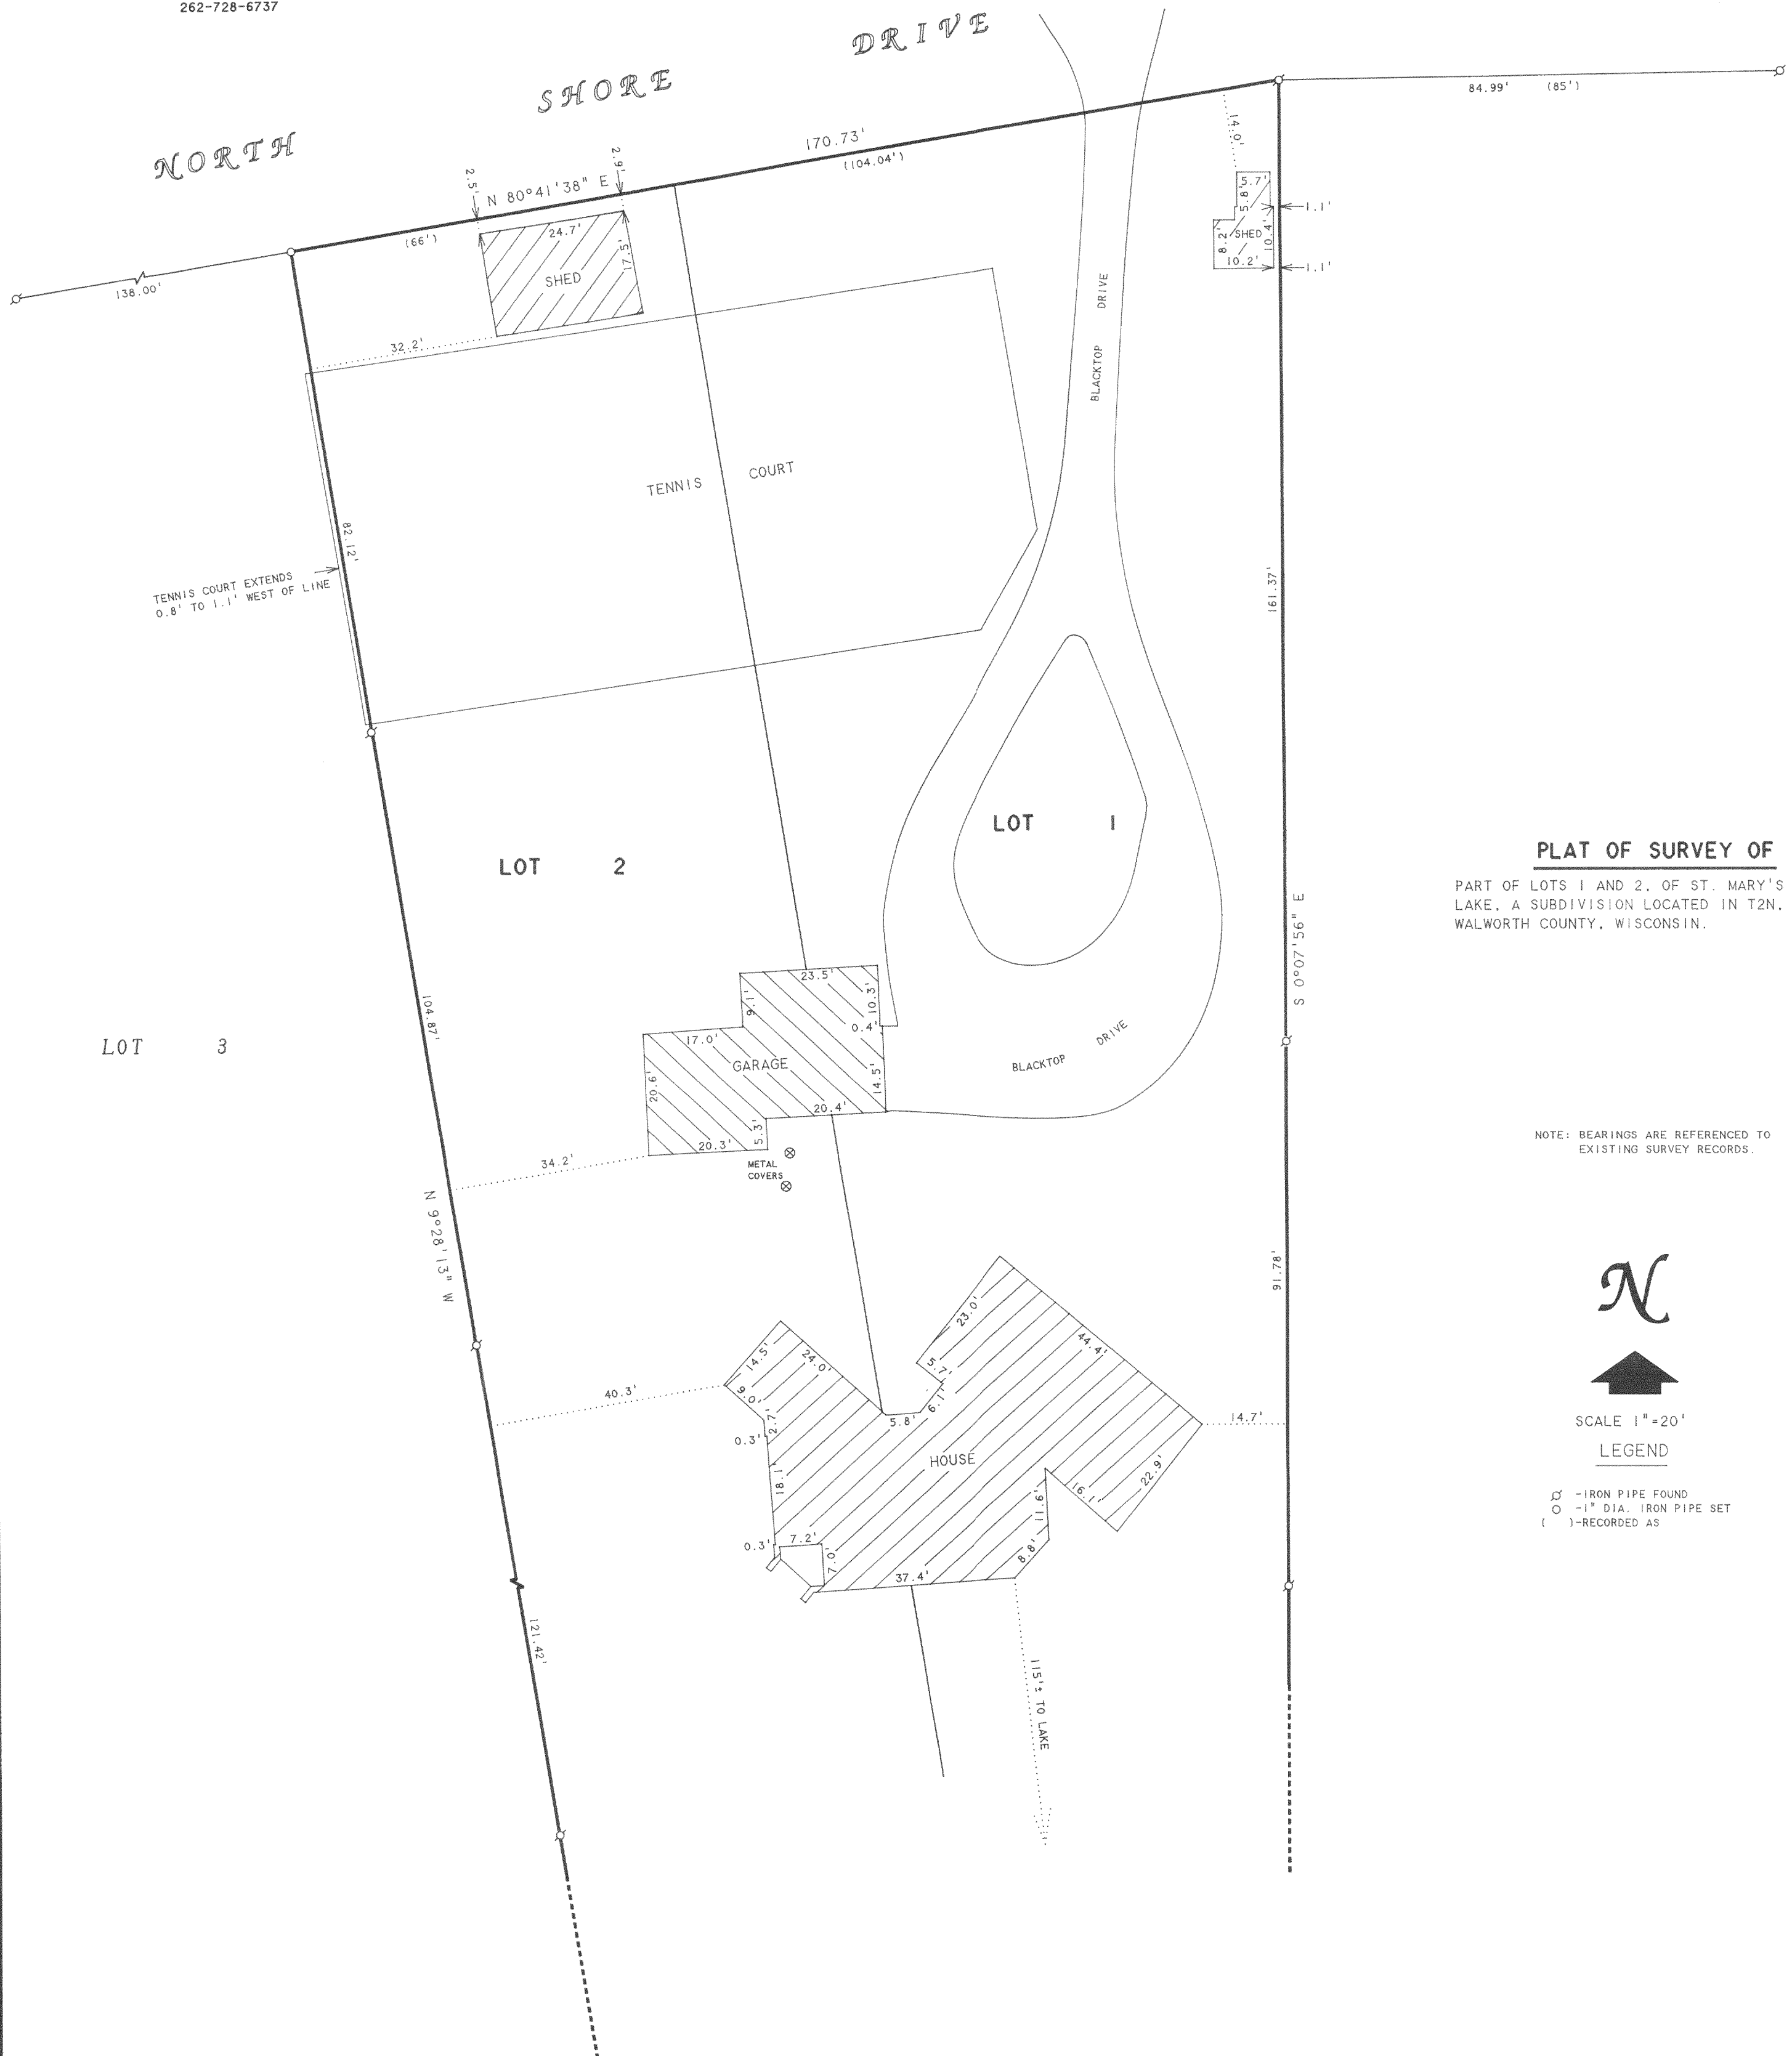

SCALE 1"=20'

LEGEND

⊗ - IRON PIPE FOUND
○ - 1" DIA. IRON PIPE SET
() - RECORDED AS

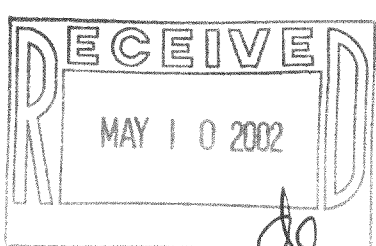

ORDERED BY: CLAIR LAW OFFICE
P.O. BOX 445
DELAVAN, WI 53115

I, DAVID F. ABELL, DO HEREBY CERTIFY THAT I HAVE SURVEYED THE PROPERTY HEREON DESCRIBED ACCORDING TO THE OFFICIAL RECORDS AND THAT THE PLAT HEREON IS A CORRECT REPRESENTATION OF THE PROPERTY LINES TO THE BEST OF MY KNOWLEDGE AND BELIEF.

David F. Abell

DAVID F. ABELL
WISCONSIN REGISTERED LAND SURVEYOR, S-1596

March 14, 2002

DATE
NOTE: THIS IS NOT A CERTIFIED COPY UNLESS SEALED.

JOB NUMBER - 92149A

FS-10 216-3169