


GEORGE T. DUNHAM
SURVEYING & SUBDIVIDING
DELAVER, WISCONSIN


N

Scale - 1" = 30'

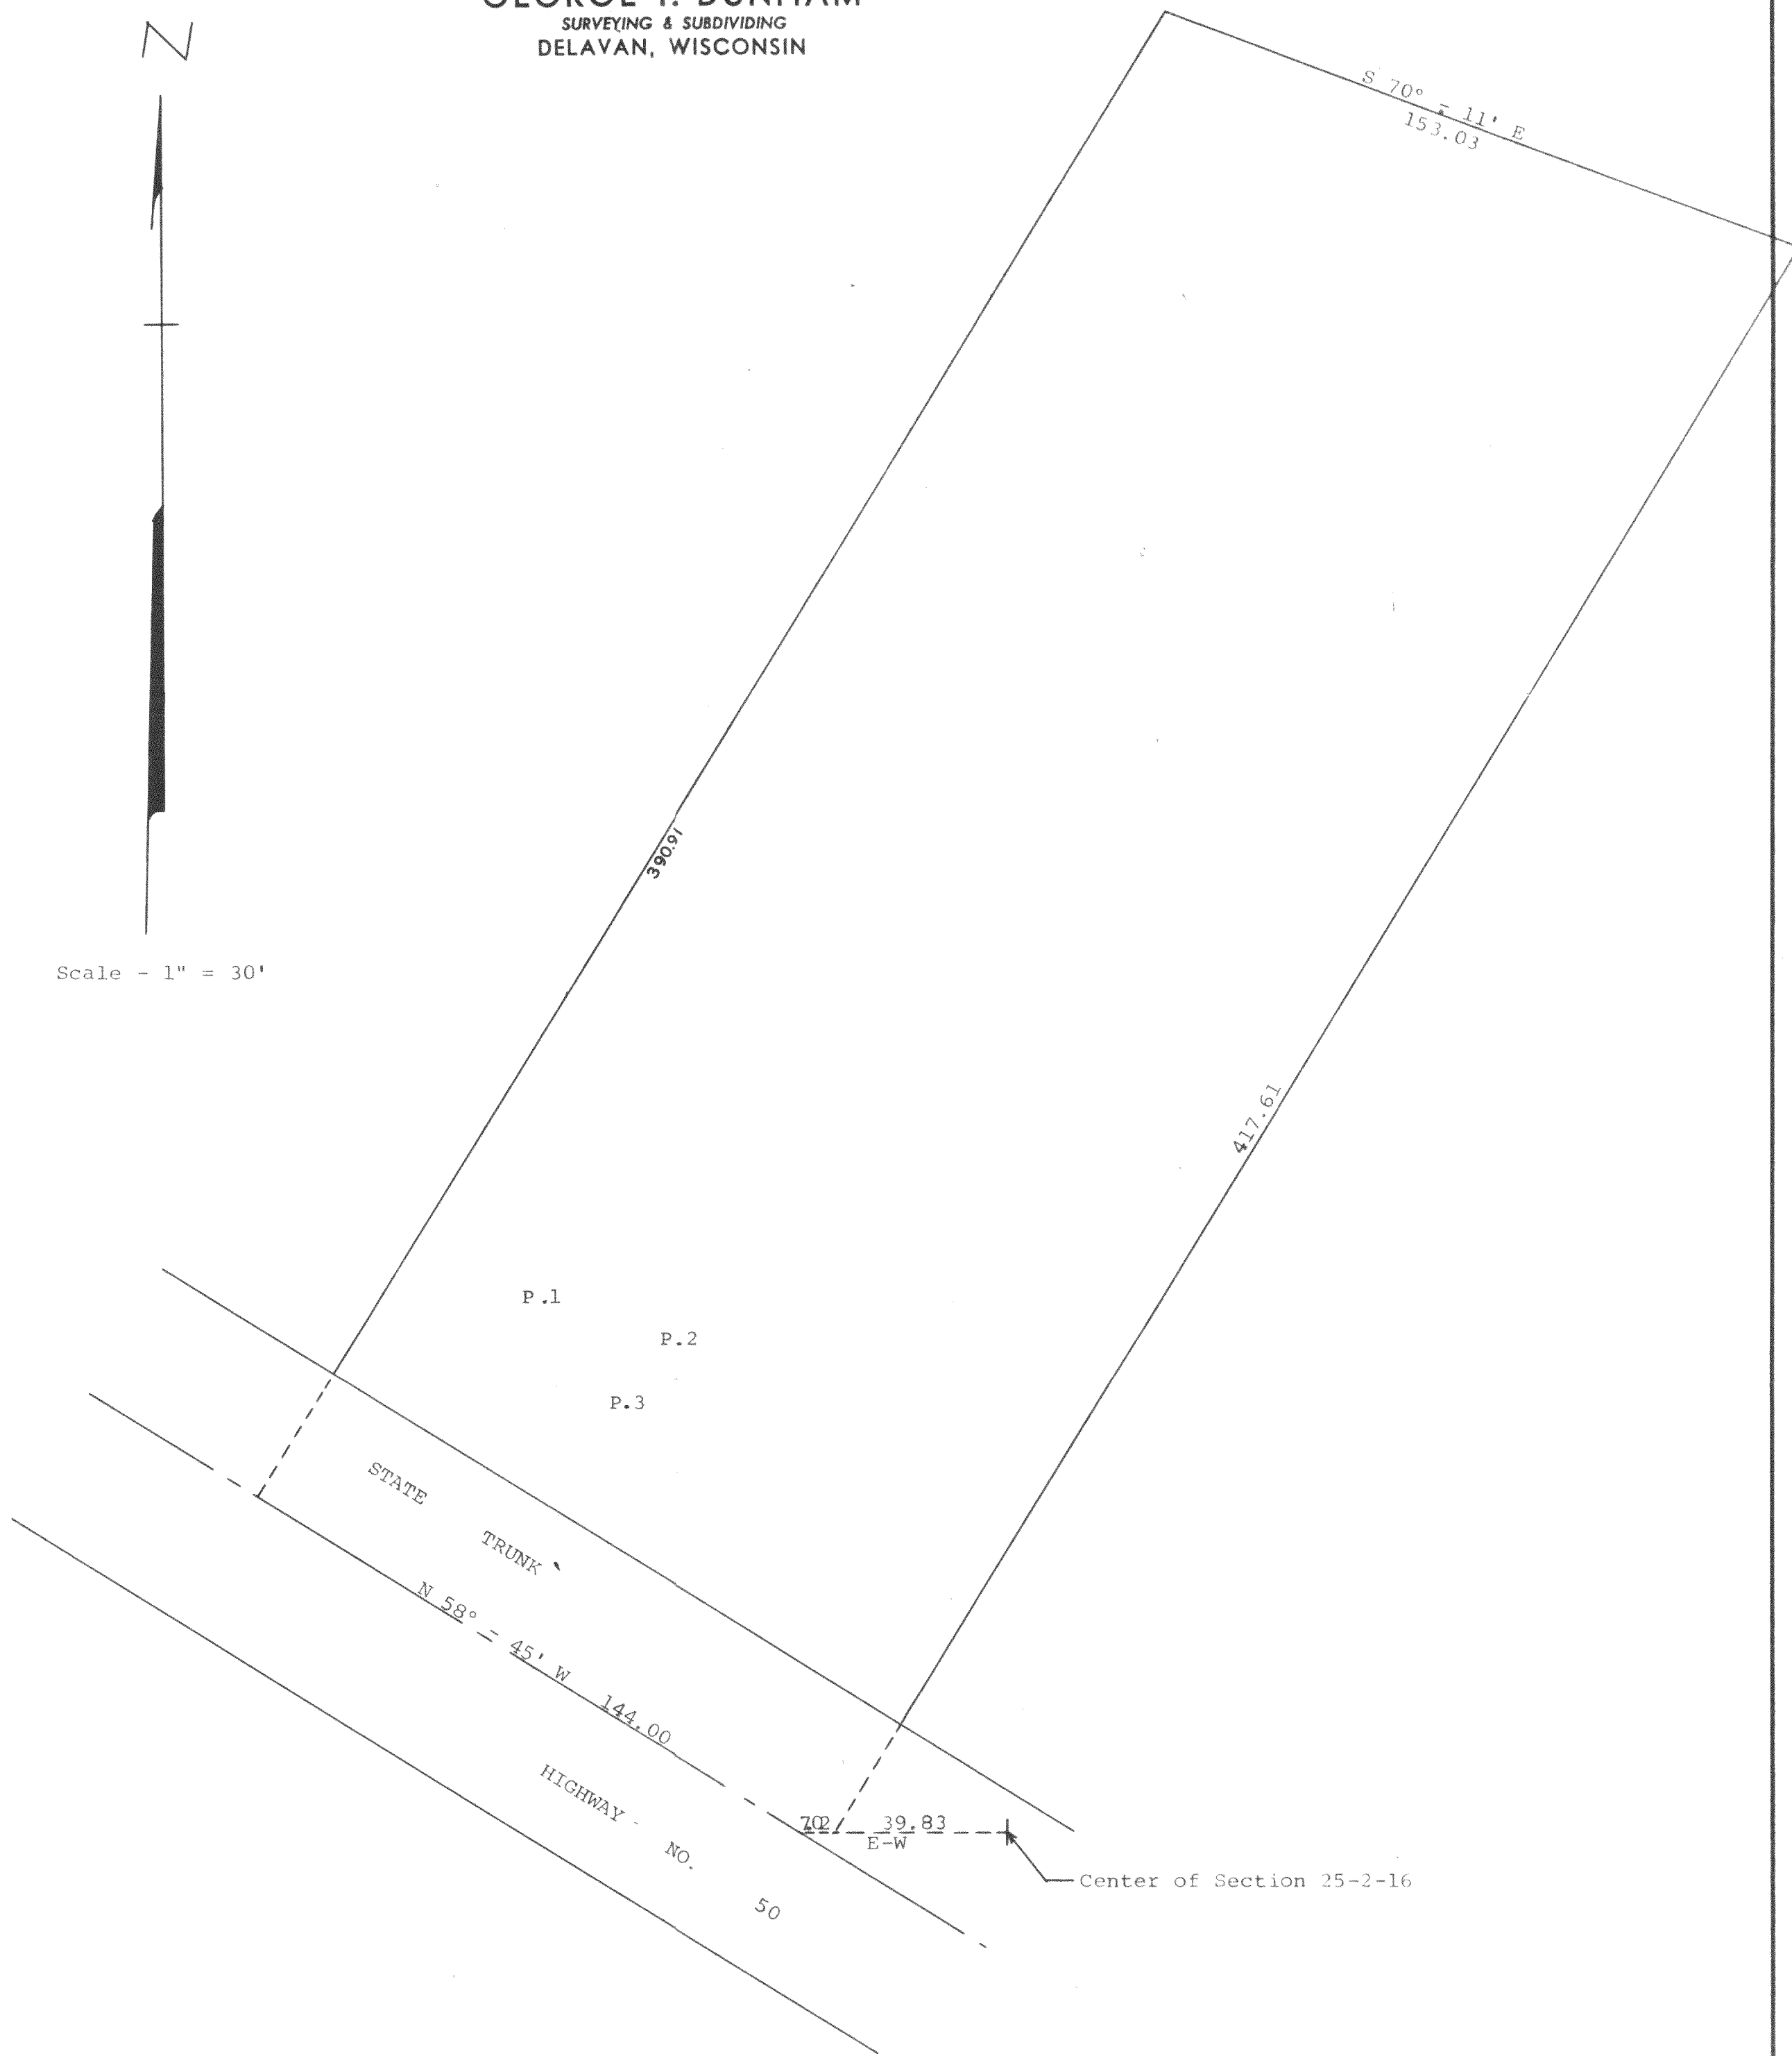

Plat showing the location of the percolation tests
made on a parcel of land owned by Ted Hess located
in the North $\frac{1}{2}$ of Section 25, T 2 N, R 16 E,
Walworth County, Wisconsin.
June 26, 1968

George T. Dunham
George T. Dunham, Surveyor

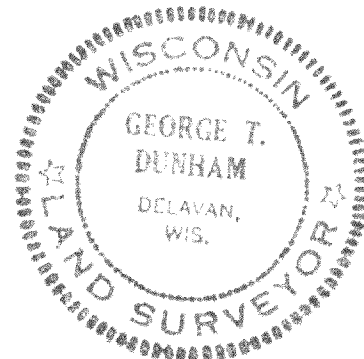

Lt 2
of Cert. Survey 415 (Percolation TEST)