


ABERNATHY and ASSOCIATES

Kenneth B. Abernathy Jr.

Wisconsin Registered Land Surveyor S-1594

W4056 BRAY RD.
ELKHORN, WI. 53121
PHONE: (262) 723-4260 (OFFICE)
(262) 723-7209 (FAX)
Email: abernathy@elknet.net

PLAT OF SURVEY

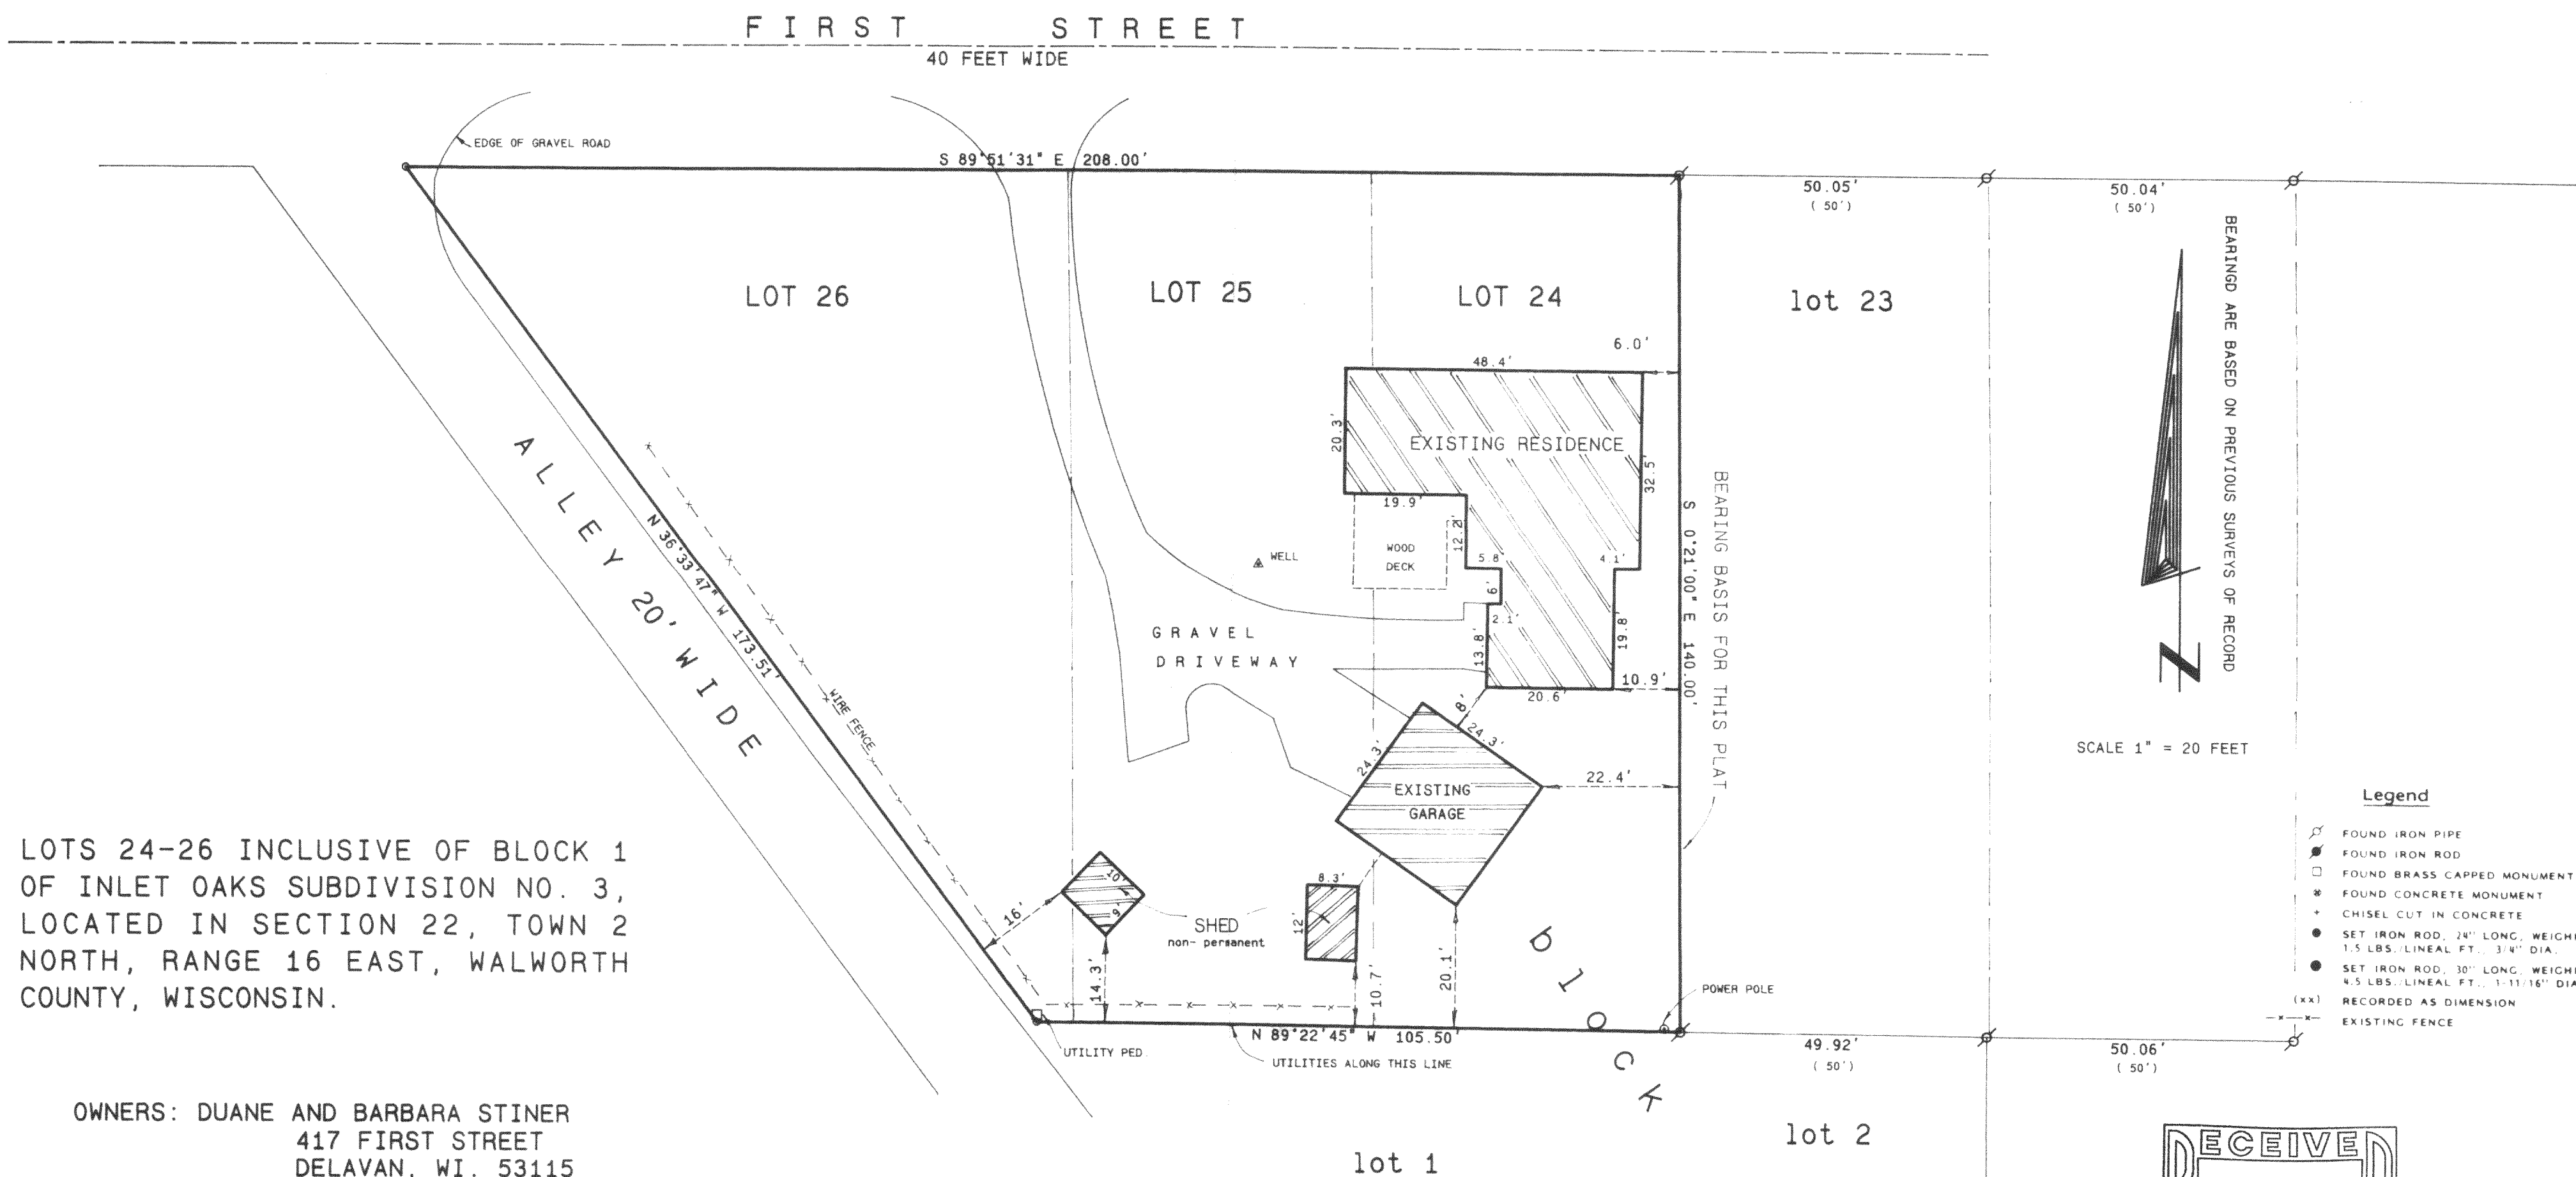


LOTS 24-26 INCLUSIVE OF BLOCK 1
OF INLET OAKS SUBDIVISION NO. 3,
LOCATED IN SECTION 22, TOWN 2
NORTH, RANGE 16 EAST, WALWORTH
COUNTY, WISCONSIN.

OWNERS: DUANE AND BARBARA STINER
417 FIRST STREET
DELAVER, WI. 53115


RECERTIFICATION SURVEY ORDERED BY:
MARILYN MOHNS KEEFE REAL ESTATE
1155 EAST GENEVA
DELAVER, WI. 53115

Legend

- FOUND IRON PIPE
- FOUND IRON ROD
- FOUND BRASS CAPPED MONUMENT
- FOUND CONCRETE MONUMENT
- CHISEL CUT IN CONCRETE
- SET IRON ROD, 24" LONG, WEIGHING 1.5 LBS., LINEAL FT., 3/4" DIA.
- SET IRON ROD, 30" LONG, WEIGHING 4.5 LBS., LINEAL FT., 1-11/16" DIA.
- RECORDED AS DIMENSION
- EXISTING FENCE

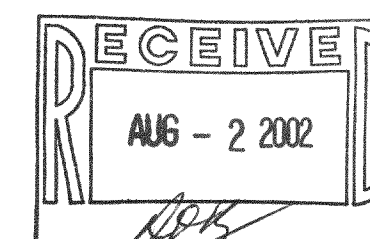

SCALE: 1" = 20 FEET

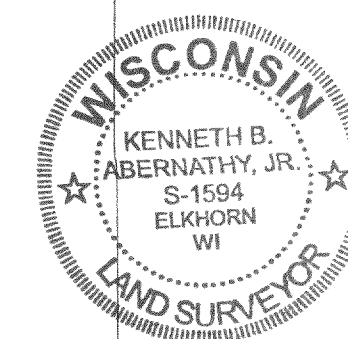

I hereby certify that the above described property has been surveyed by me or under my direction and that the above map is a true representation thereof and shows the size and location of the property, its exterior boundaries, the location of all visible structures and dimensions of all principal buildings thereon, boundary fences, apparent easements, roadways and visible encroachments, if any. This survey is made for the use of the present owners of the property, and also those who purchase, mortgage, or guarantee the title thereto within one year from date hereof.

Kenneth B. Abernathy Jr.
KENNETH B. ABERNATHY, JR.
WISCONSIN REGISTERED LAND SURVEYOR,
S-1594
Date: 12/8/91 Job No. 91.1201

REVISED AND RECERTIFIED
7/19/02

FIN3-20

216-3213